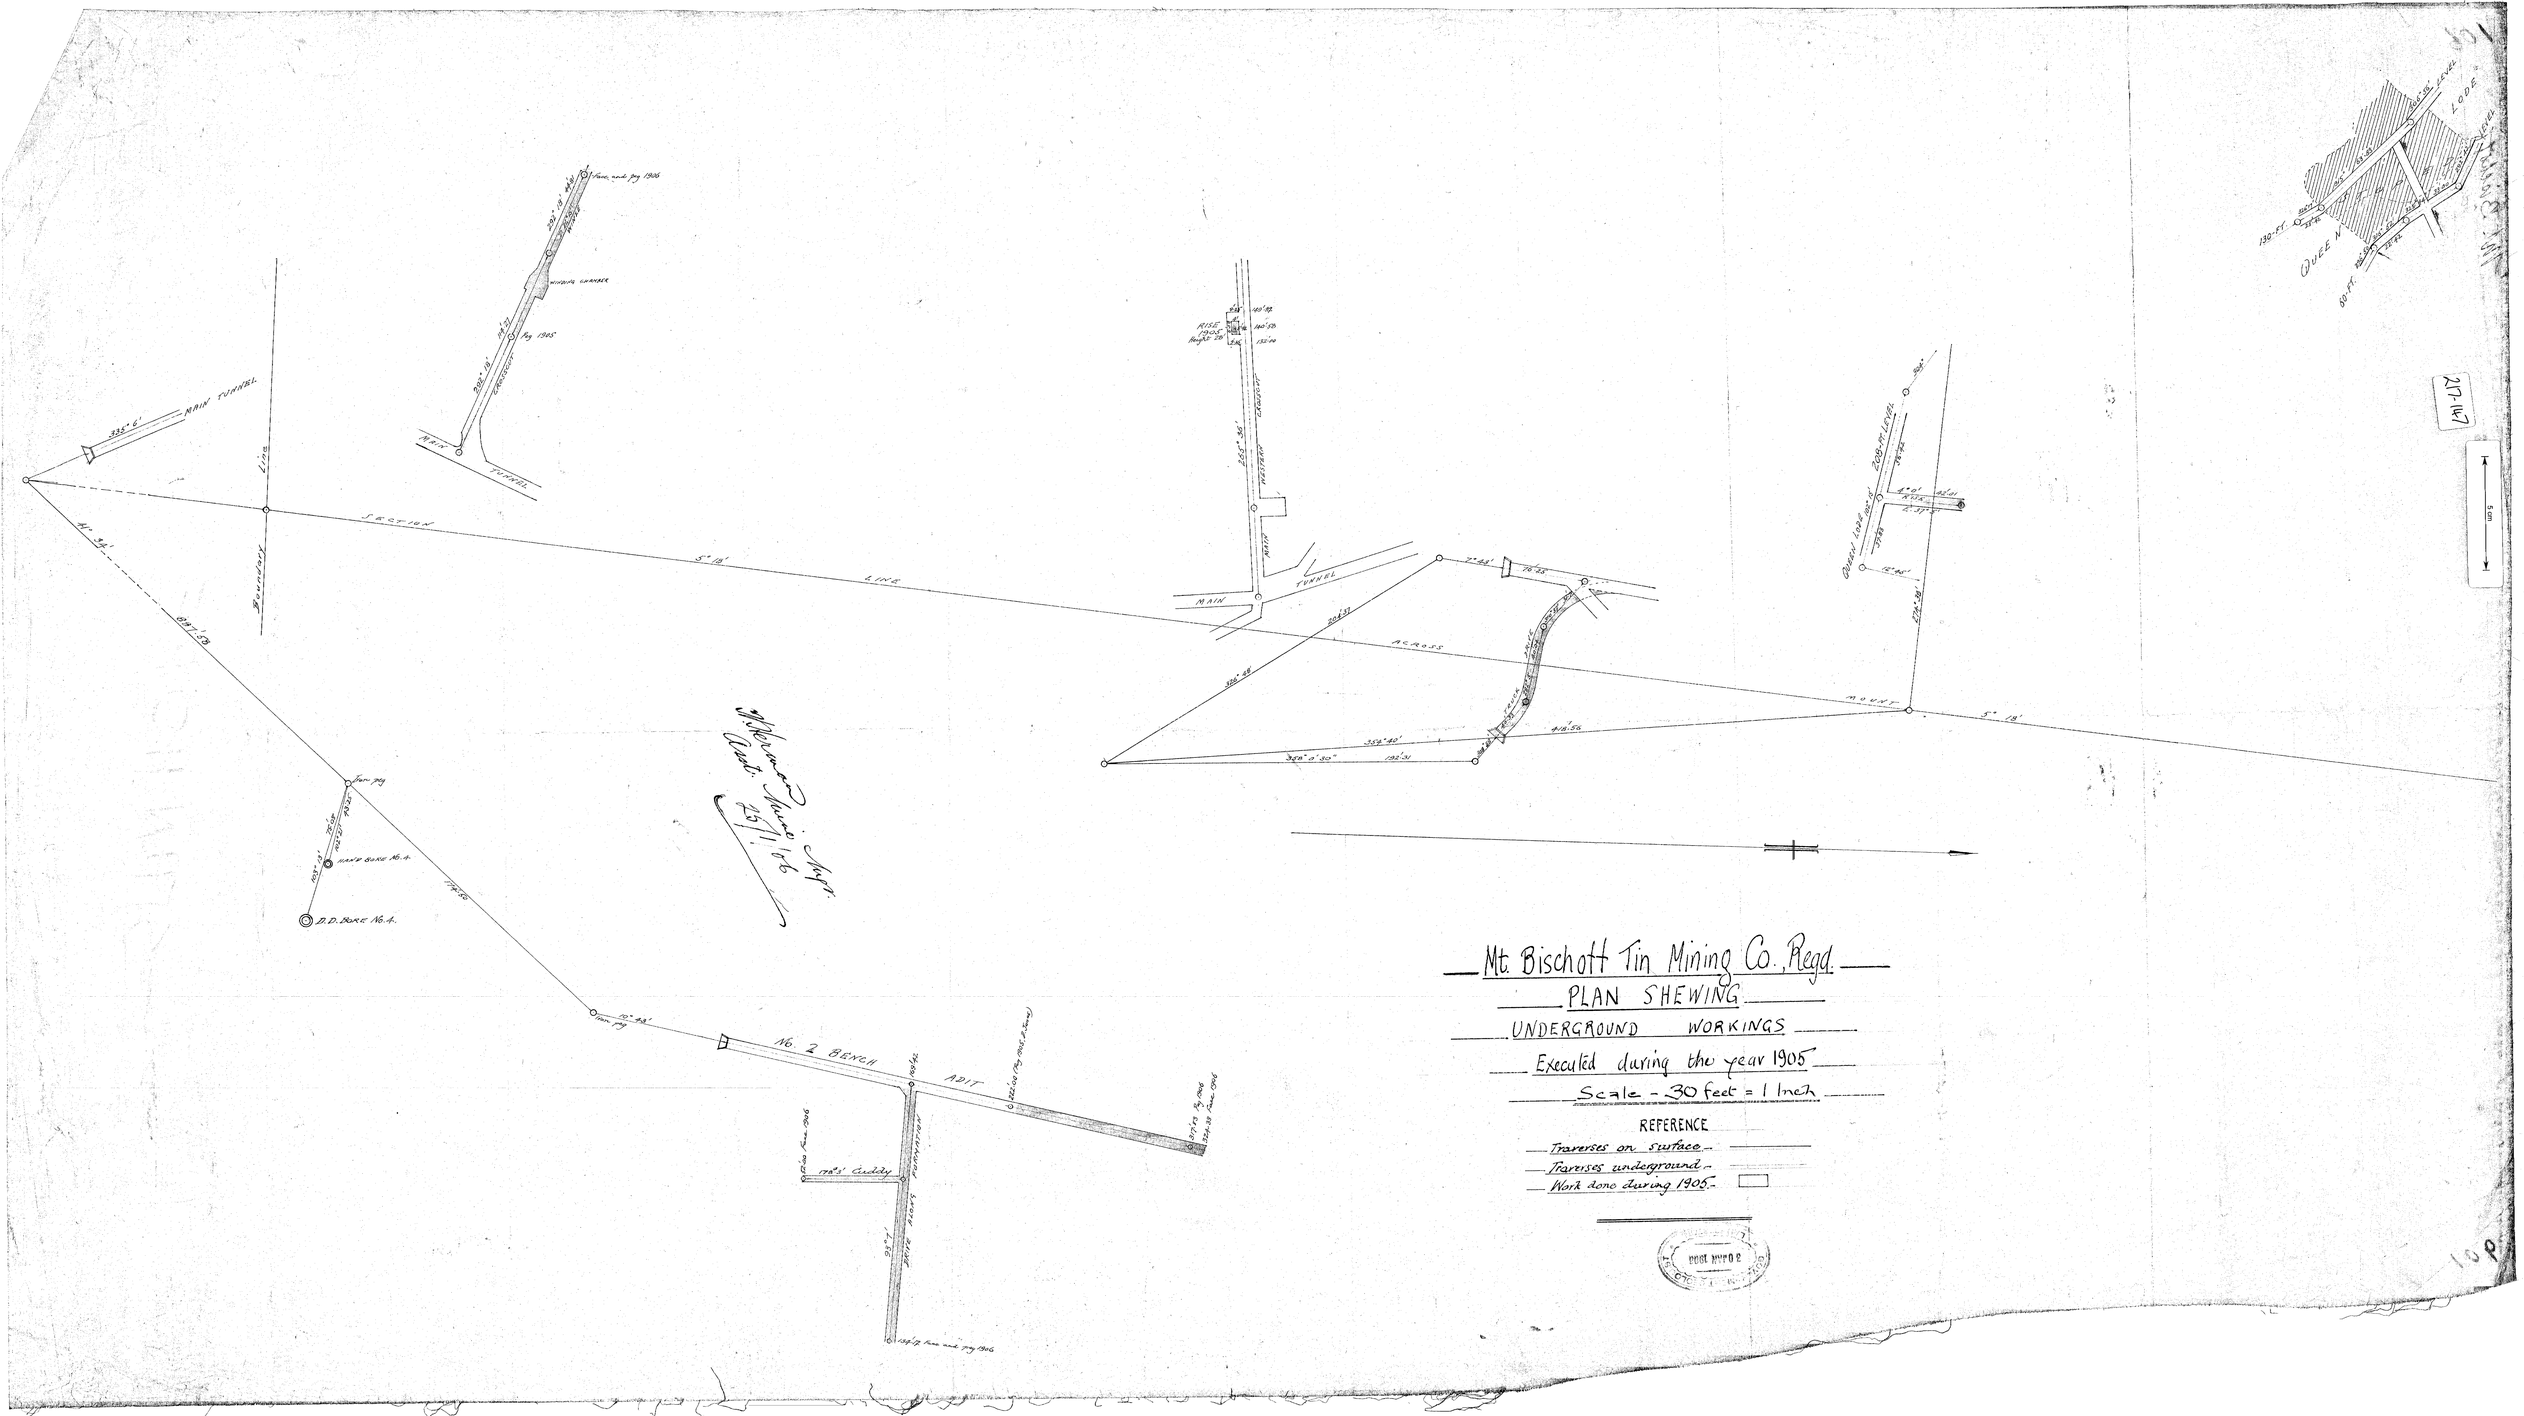
Mt. Bischoff Tin Mining Co., Regd.
PLAN SHEWING
UNDERGROUND WORKINGS
Executed during the year 1905
Scale - 30 feet = 1 Inch
REFERENCE
Traverses on surface
Traverses underground
Work done during 1905
MAIN TUNNEL
Boundary Line
SECTION
ACROSS
MOUNT
WESTERN CROSSCUT
MAIN TUNNEL
QUEEN LODE
No. 2 BENCH ADIT
