217-149

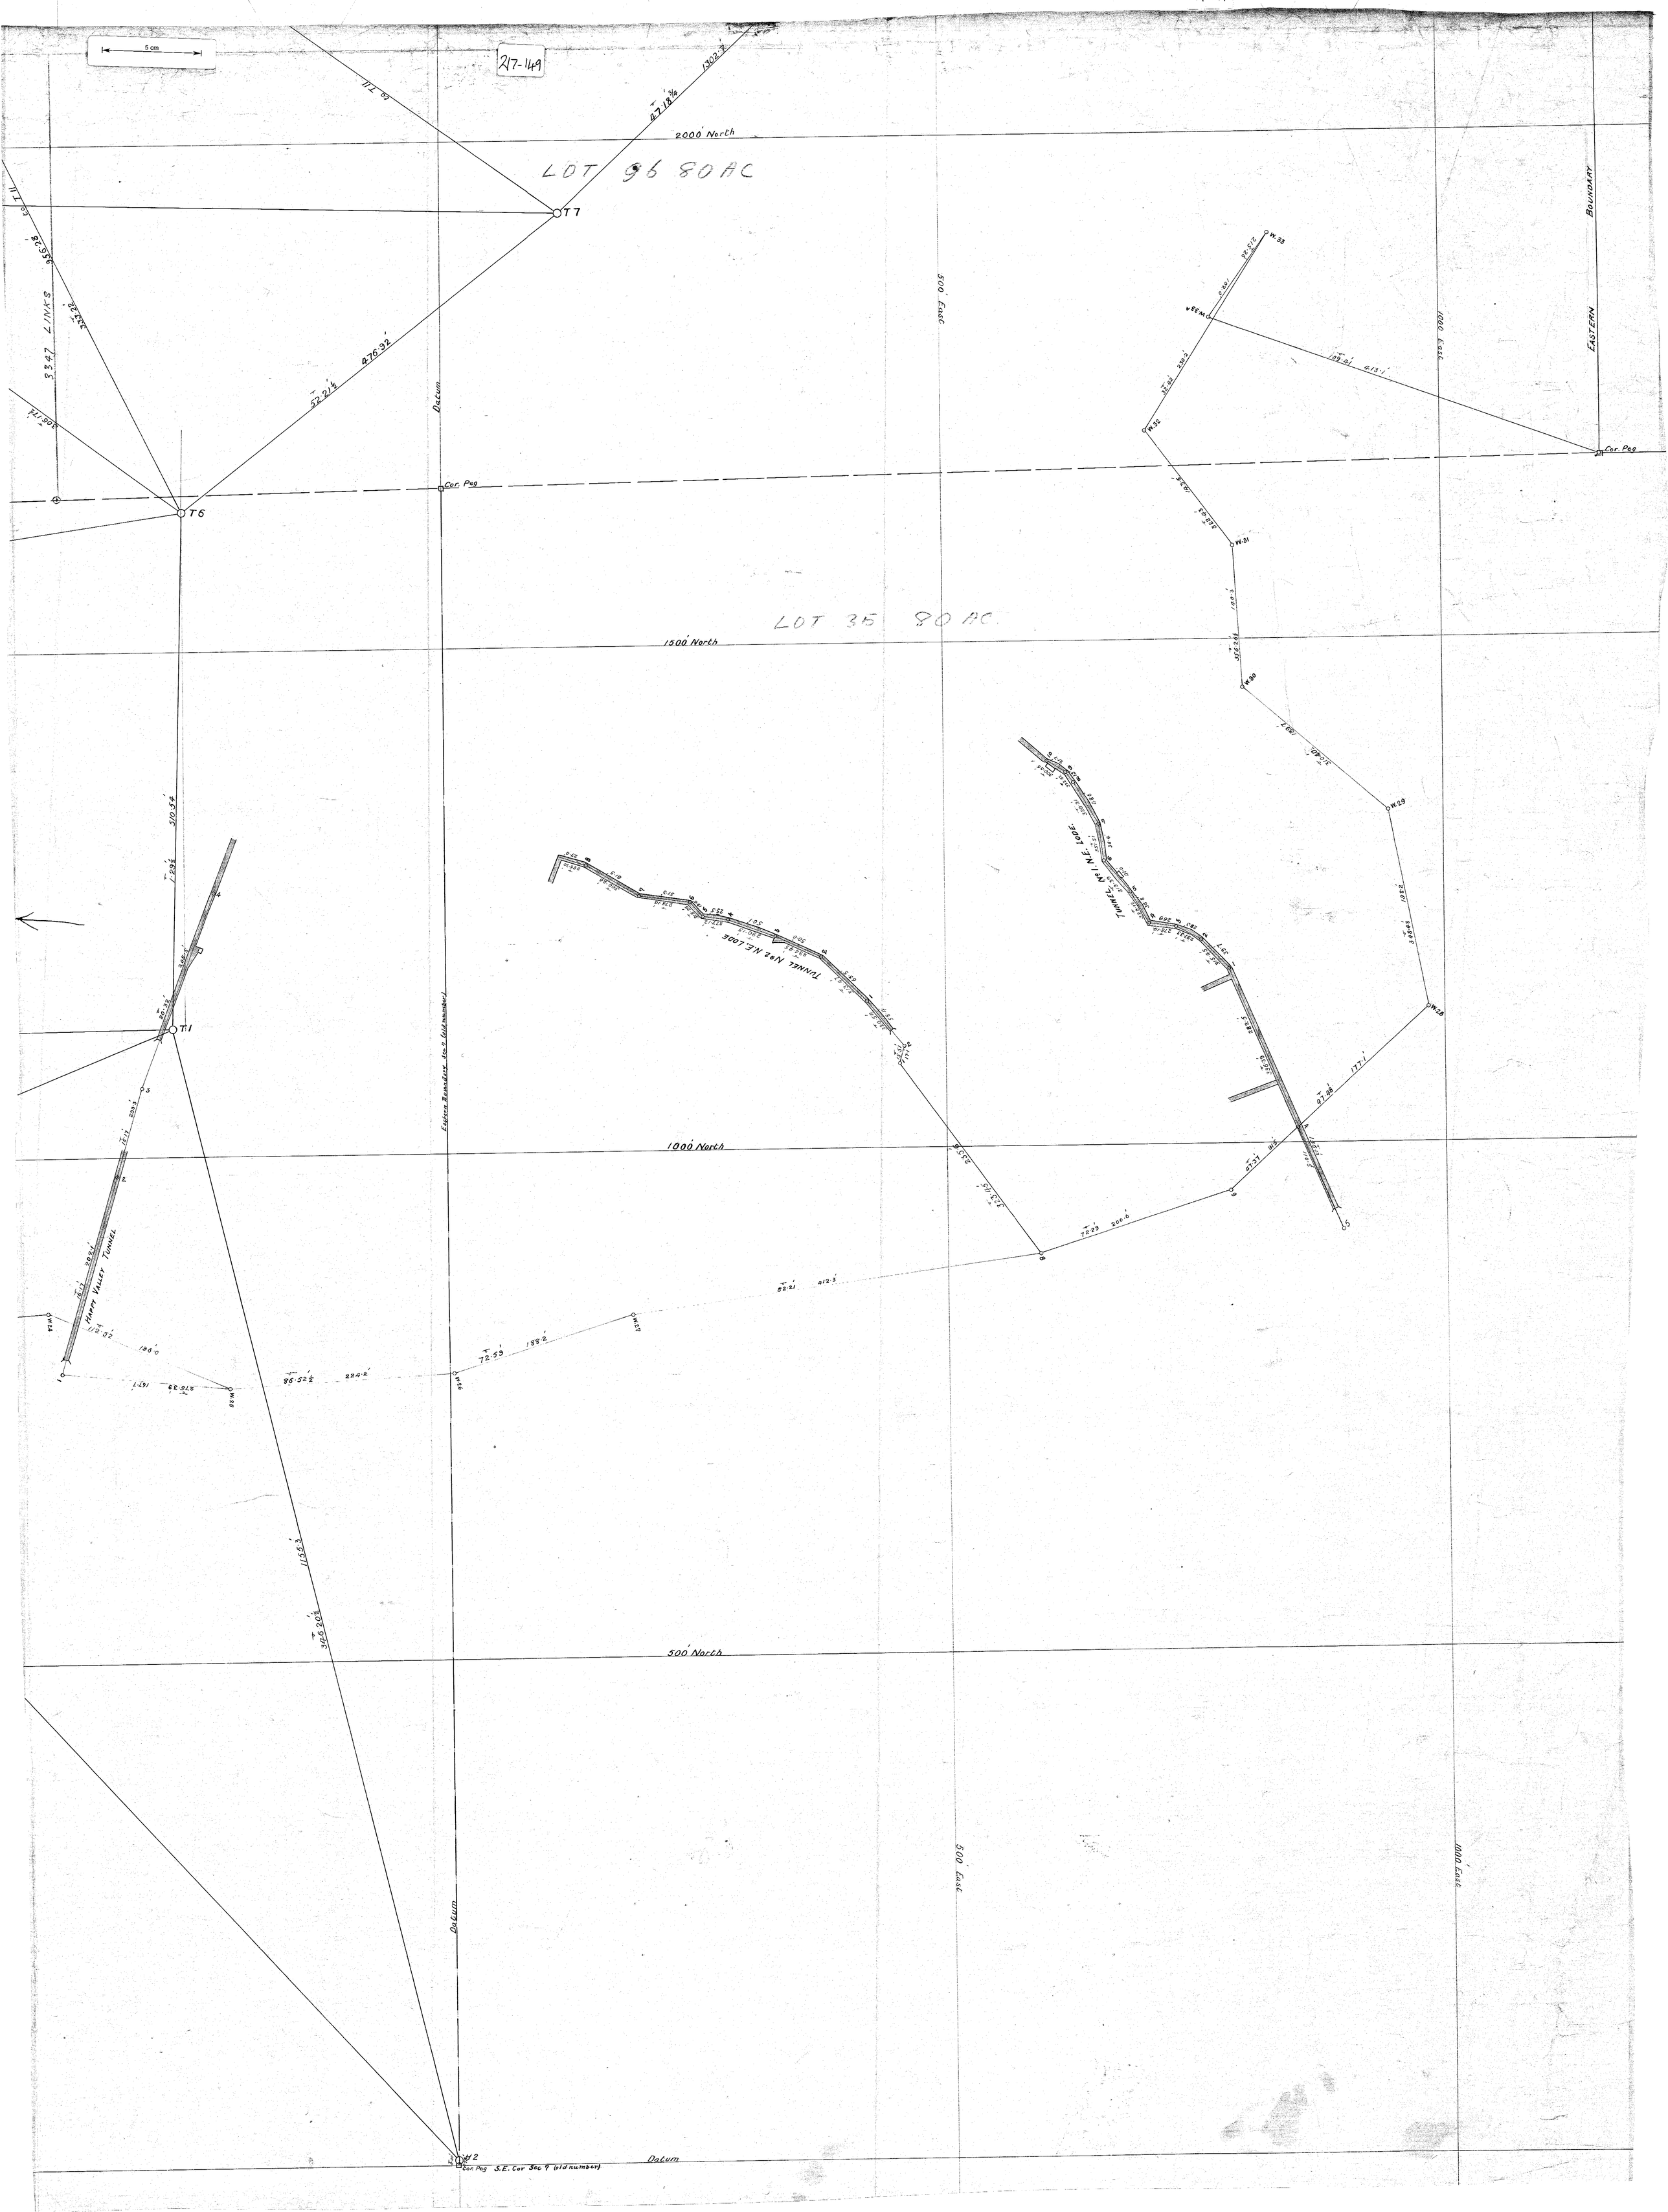
5 cm
217-149
2000' North
LOT 96 80 AC
T7
T6
T1
Cor. Peg
Datum
500' East
1000' East
EASTERN BOUNDARY
W.33
W.33A
W.32
W.31
W.30
W.29
W.28
W.27
W.26
W.25
W.24
TUNNEL No 1 N.E. LODE
TUNNEL No 2 N.E. LODE
HAPPY VALLEY TUNNEL
1500' North
1000' North
500' North
Eastern Boundary Sec 7 (old number)
#2
Cor. Peg S.E. Cor Sec 7 (old number)