


SCALE 50 FT = 1 IN.

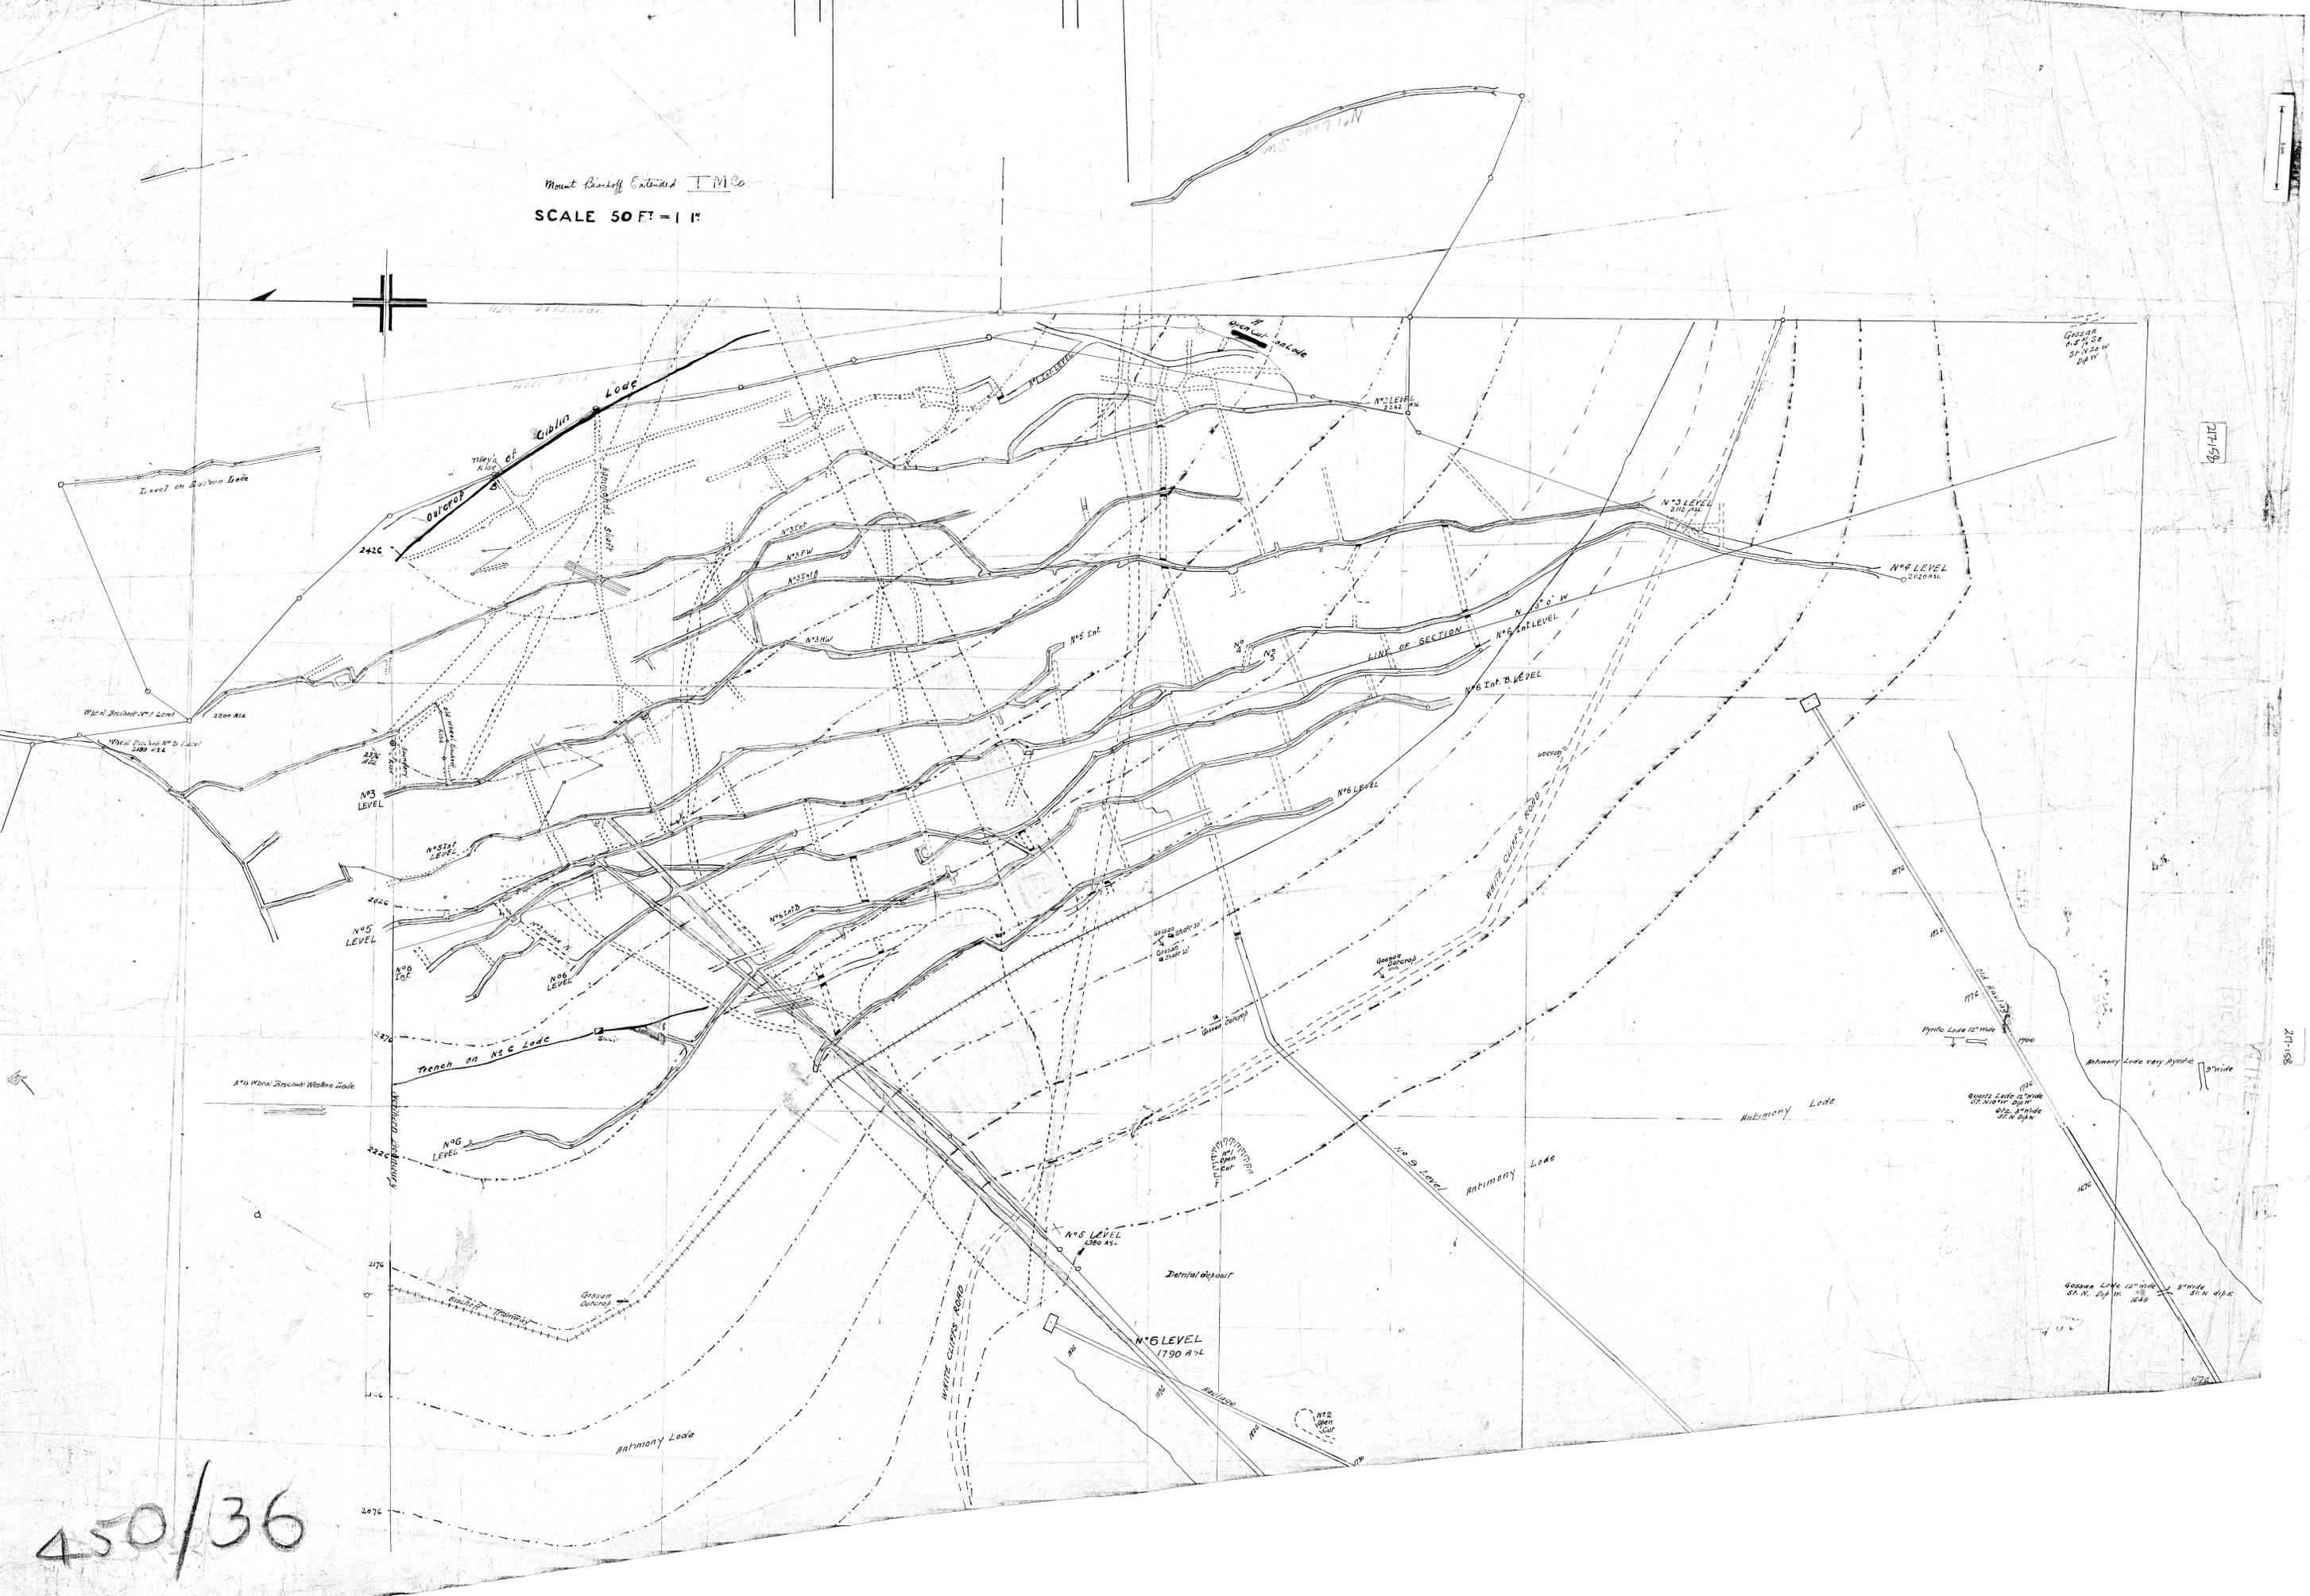

450/36

217-57

217-58