— MT BISCHOFF T.M.CO.REG. —

— QUEEN LODE WEST END —

— LONGITUDINAL SECTION —

— SCALE 25 FT TO 1 INCH —

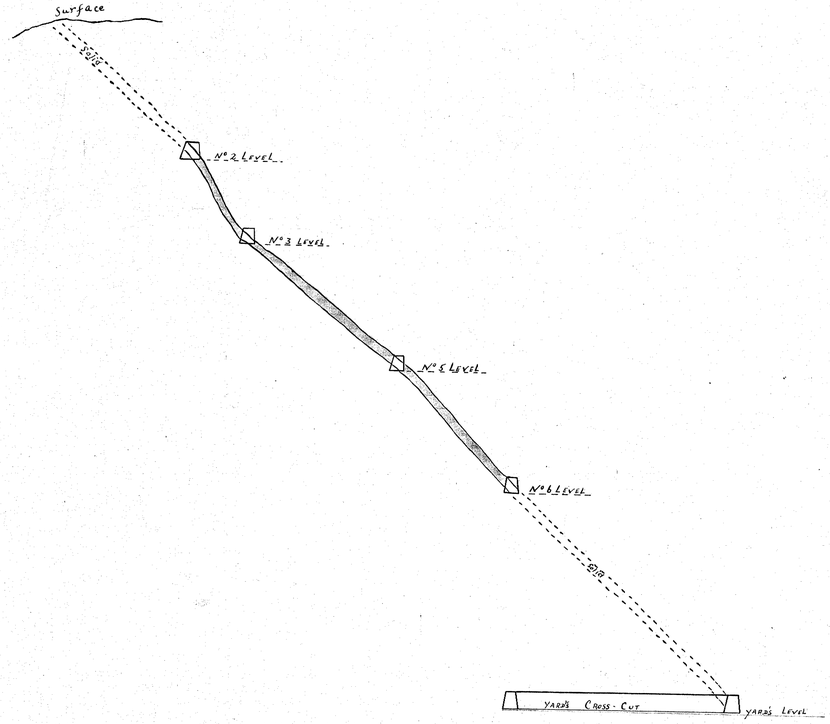

TRANSVERSE SECTION

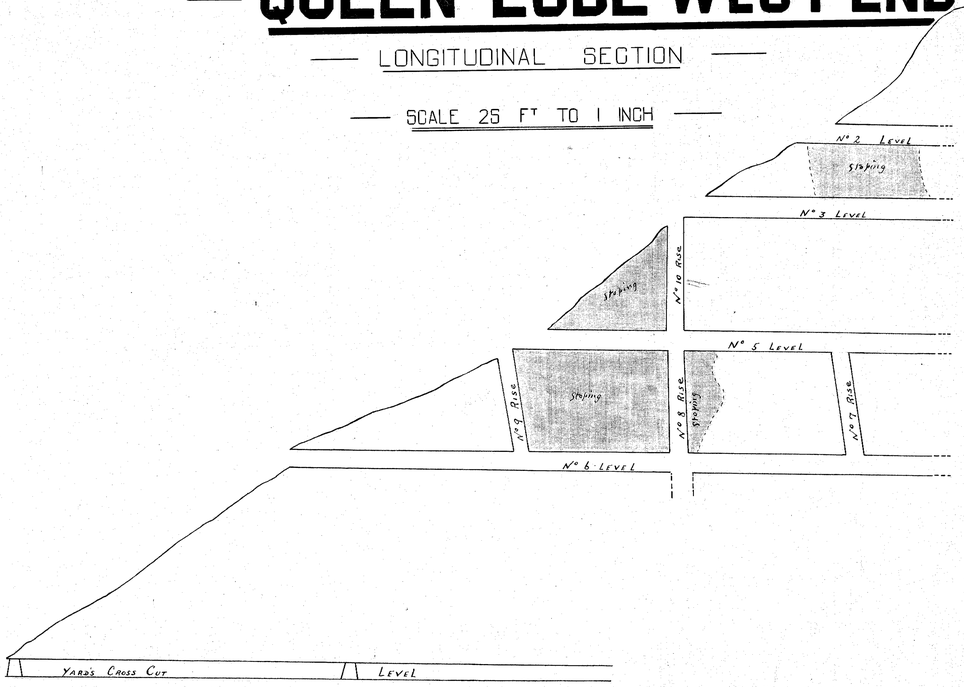

Mar 1934
Surveyor W Dates
Foot and 5th Head

217-180

217-180