


217-197

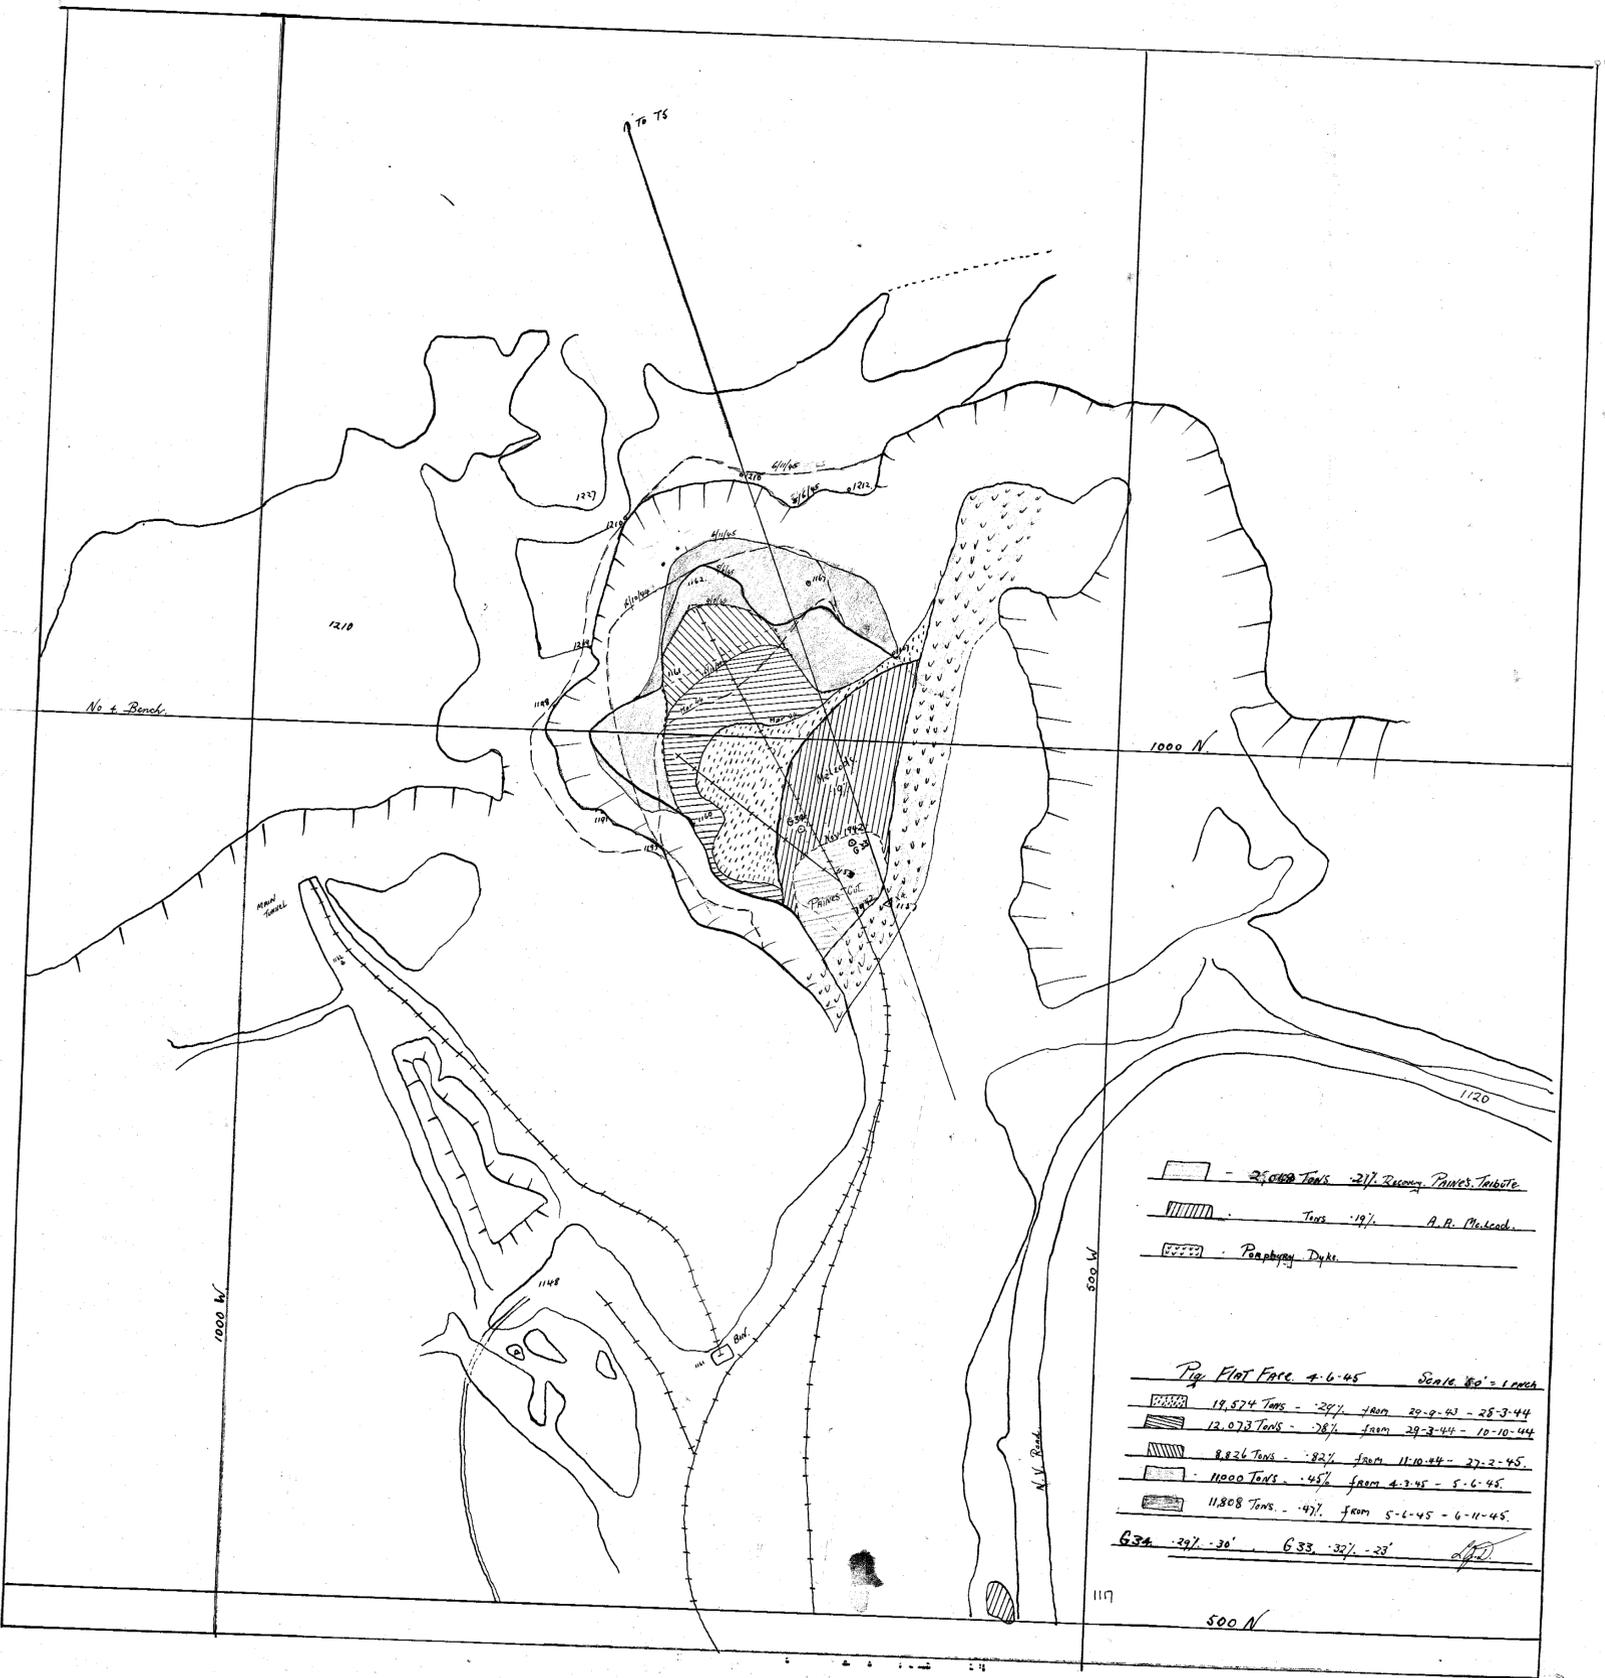

 Tons - 19% A. R. M. Lead.  
 - Porphyry Dyke

 12,073 Tons - 28% from 29-3-44 - 10-10-44  
 8,826 Tons - 82% from 11-10-44 - 27-2-45  
 11,000 Tons - 45% from 4-3-45 - 5-6-45  
 11,808 Tons - 47% from 5-6-45 - 6-11-45  
 G. 34 - 29% - 30'      G. 33 - 32% - 23'

117

500 N