Mt BISCHOFF T. M. Co REG.

NORTH WALL BROWN FACE

176 FEET LEVEL

— SCALE 25 FT = 1 INCH —

DEC 1926.

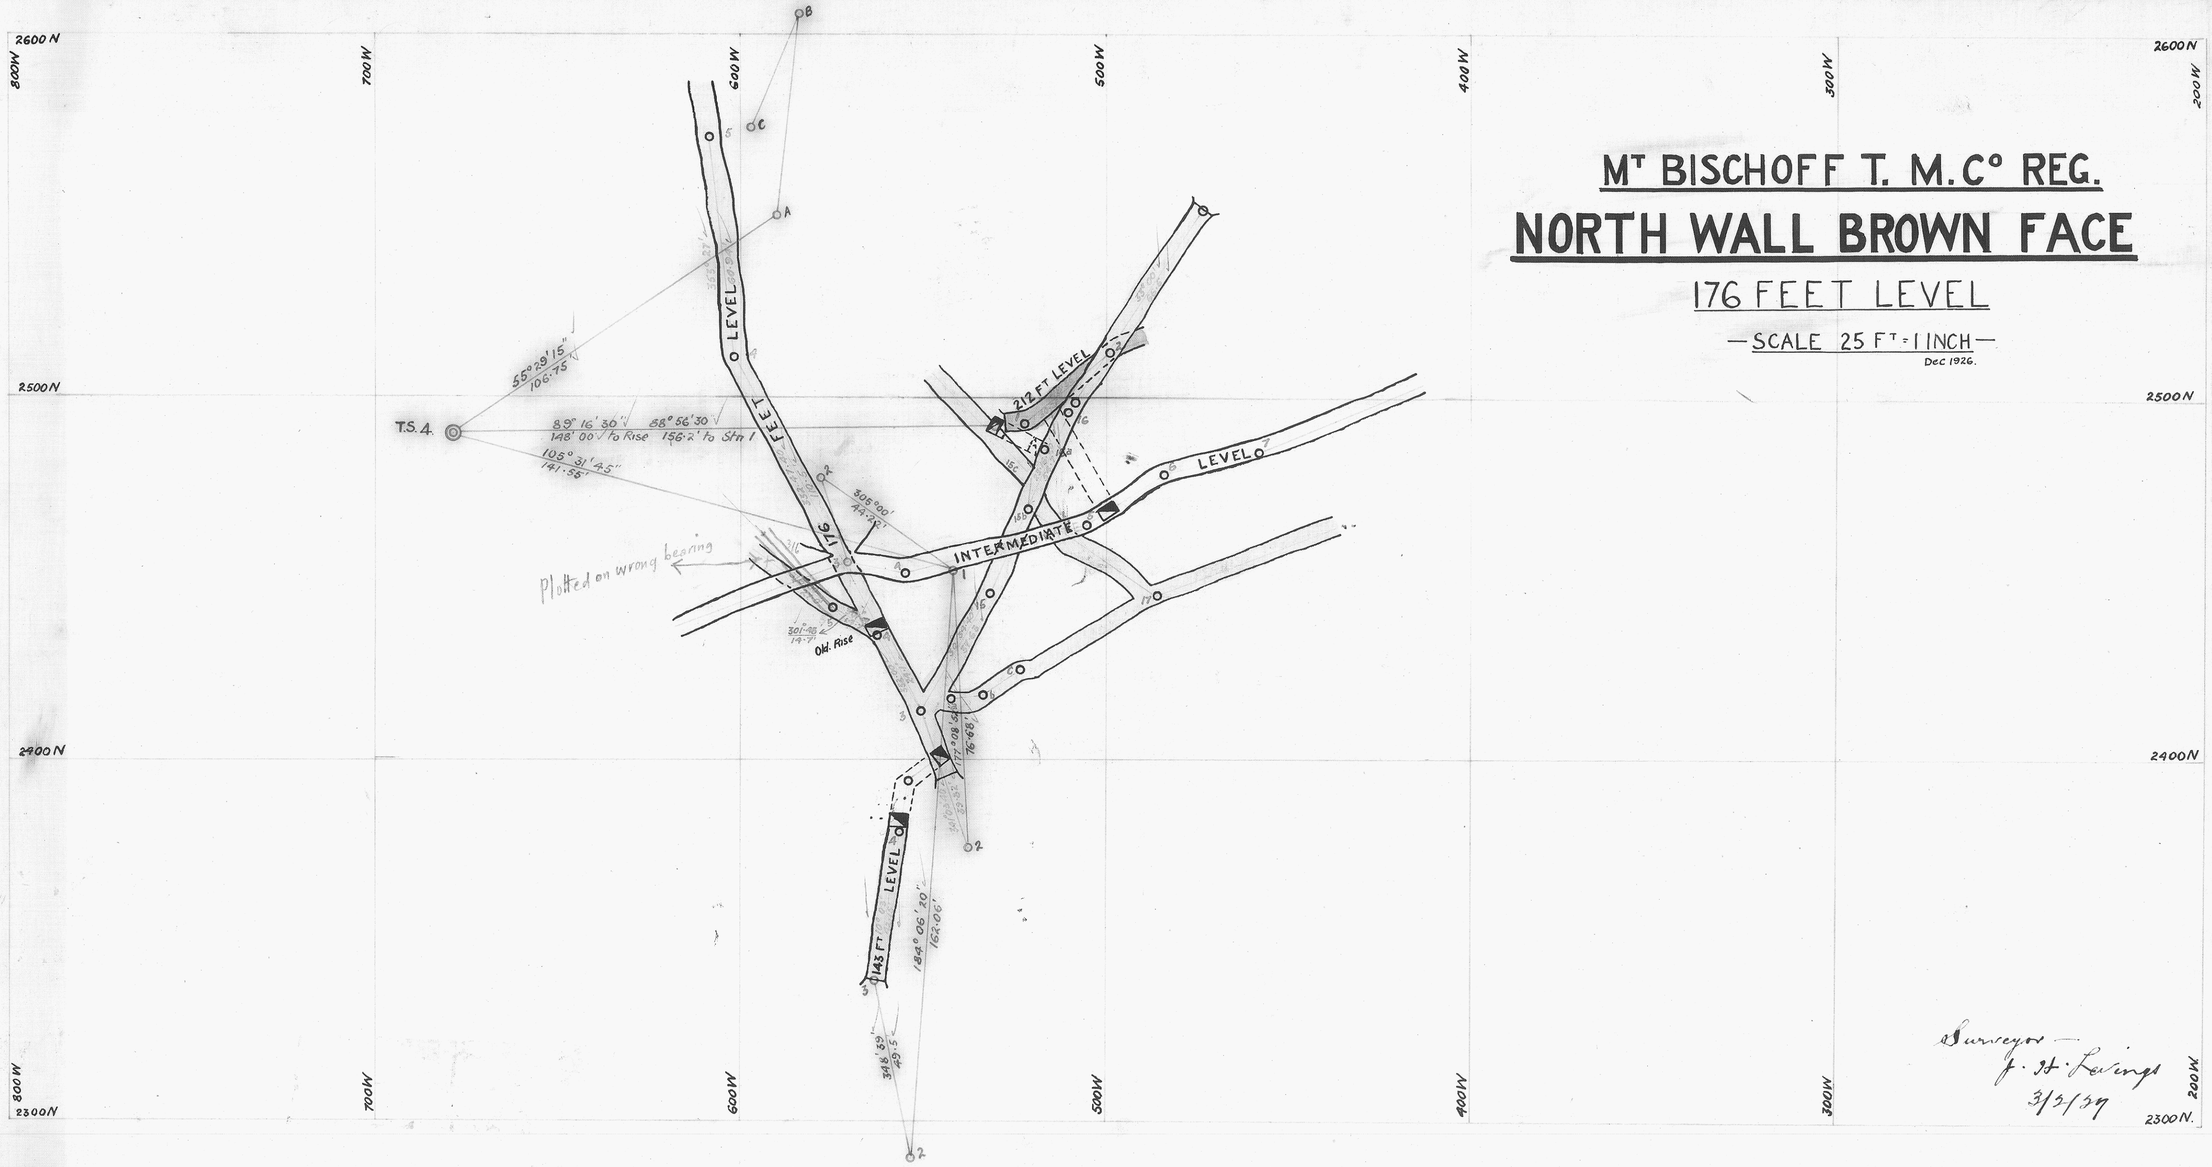

Surveyor —
J. St. Lawings
3/3/39

217-201

217-201