MT BISCHOFF T.M.CO.REG.

KEYSER LODE

SCALE 25 FT TO 1 INCH

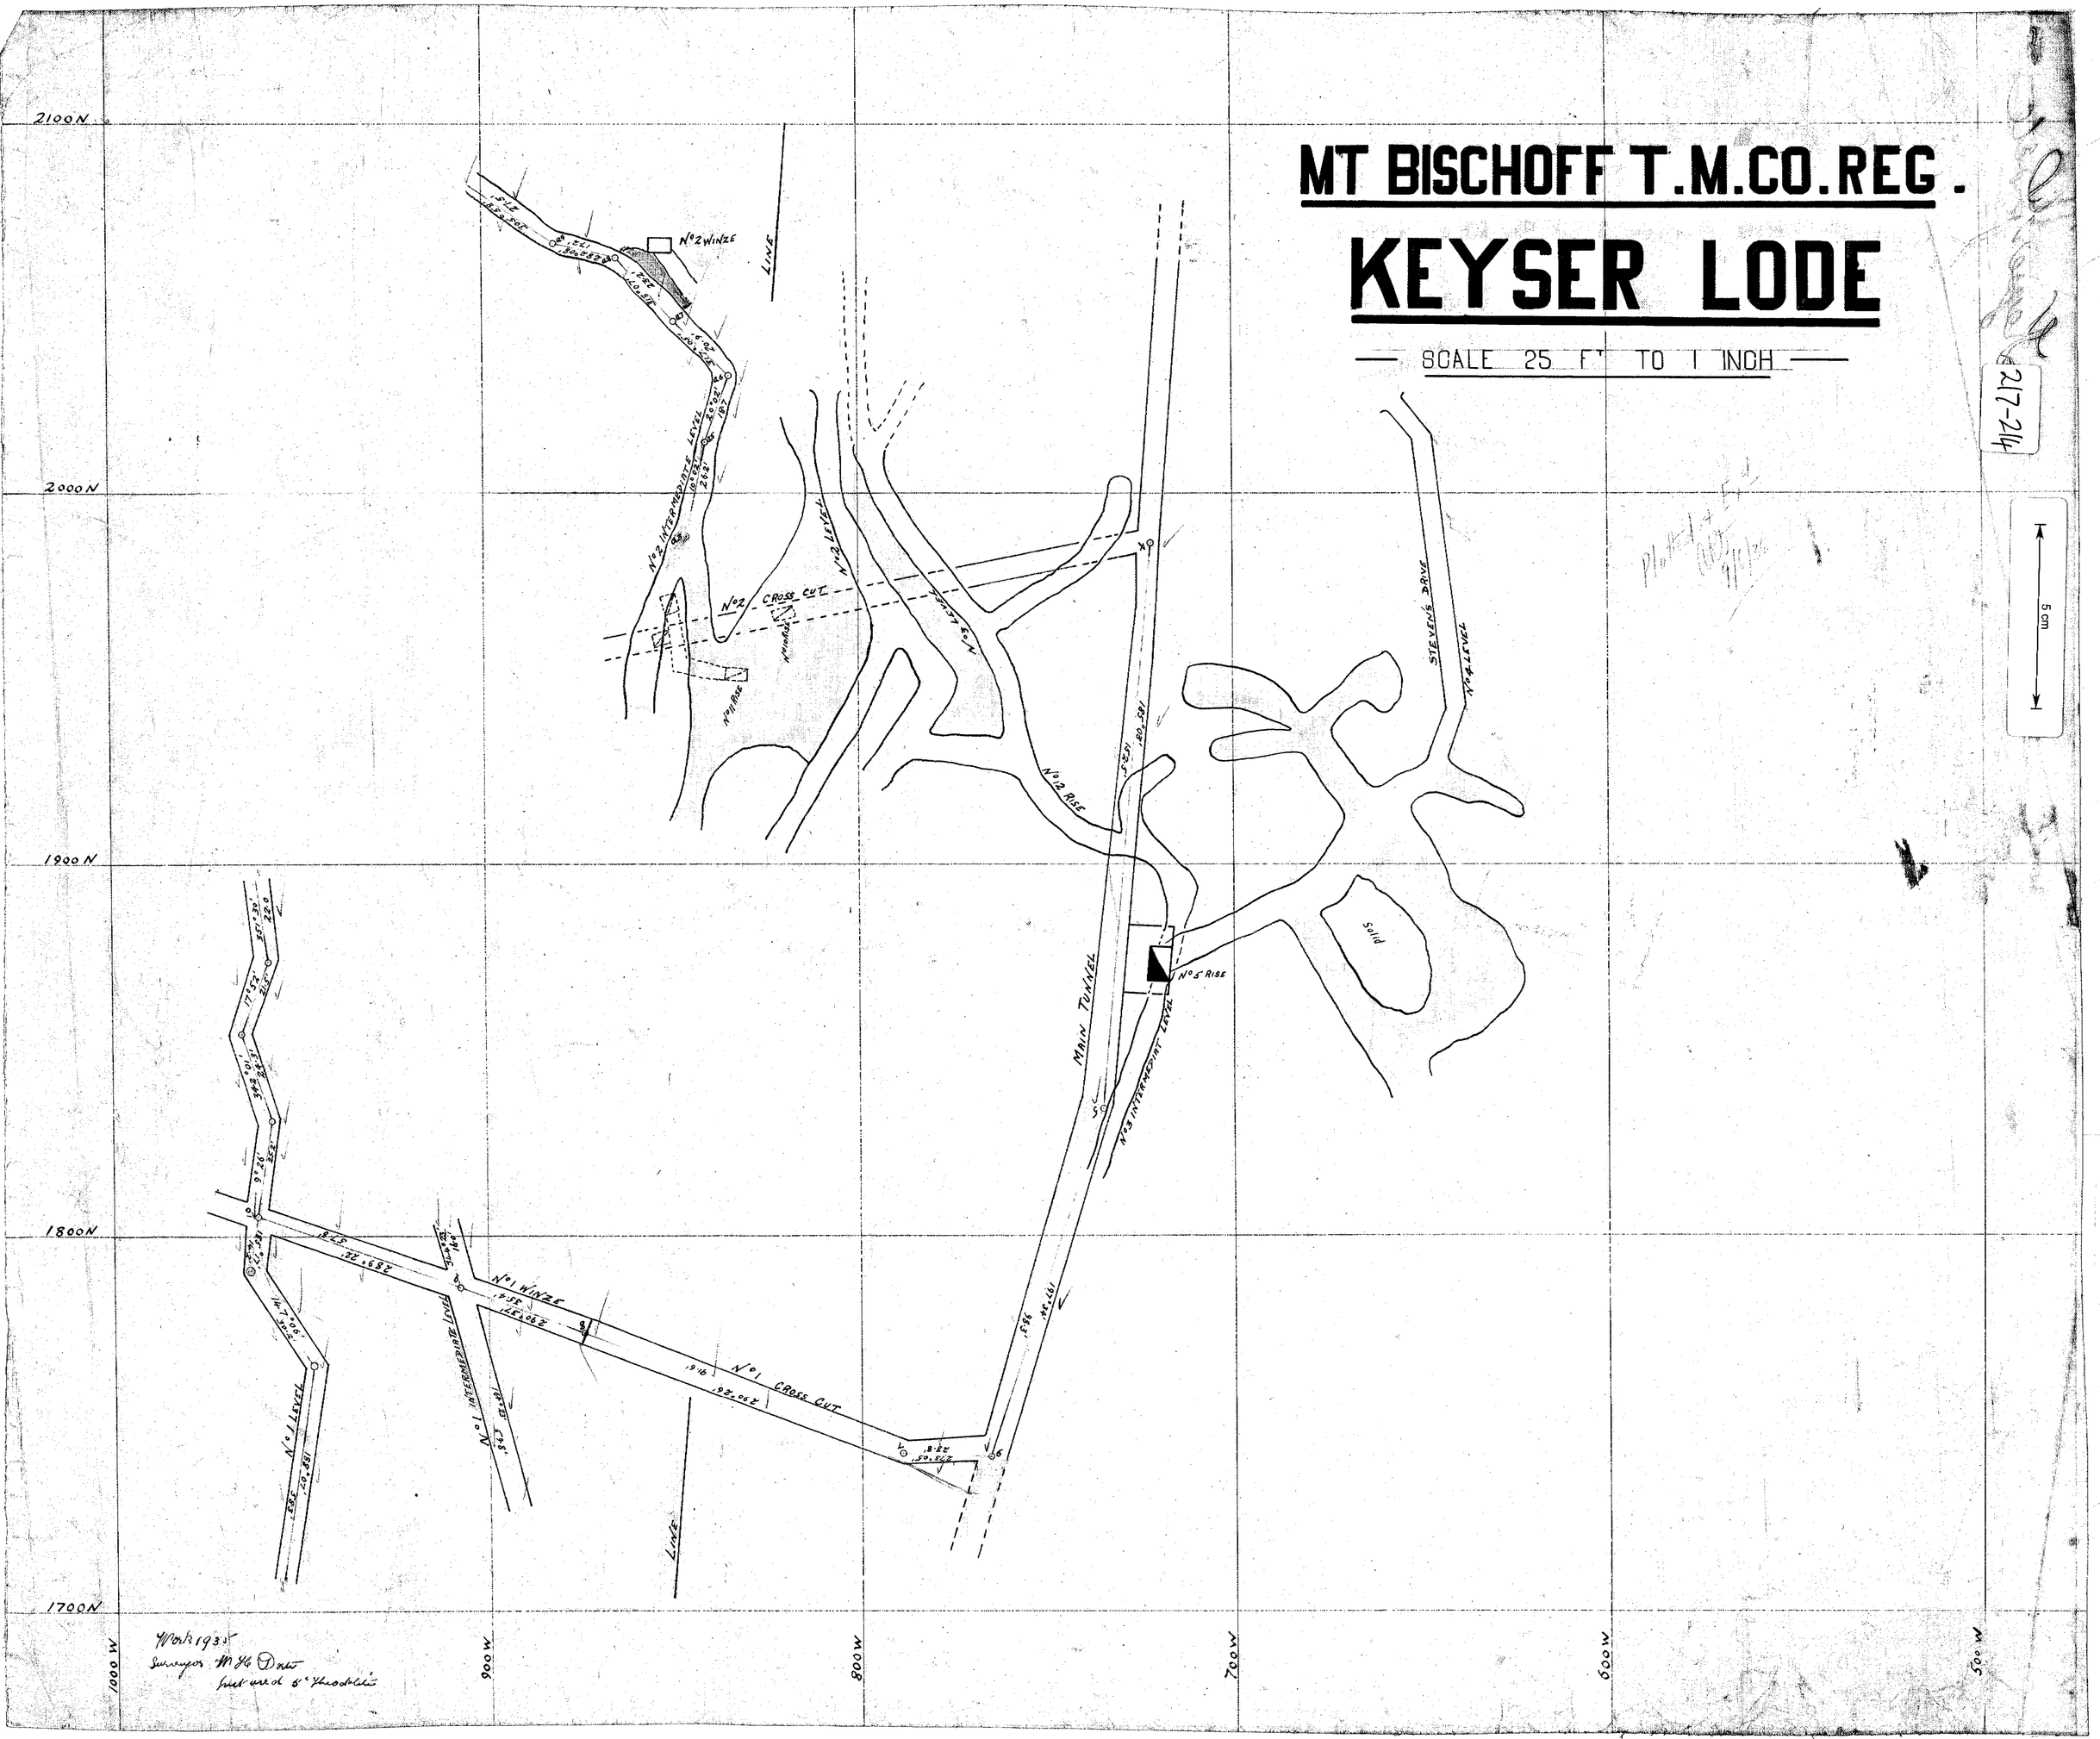

Work 1935
Surveyor W H Dixon
field work & Theodolite

217-214

217-214