


500 W
1100 N

500 W
1100 N

500 W
700 N

500 W
700 N

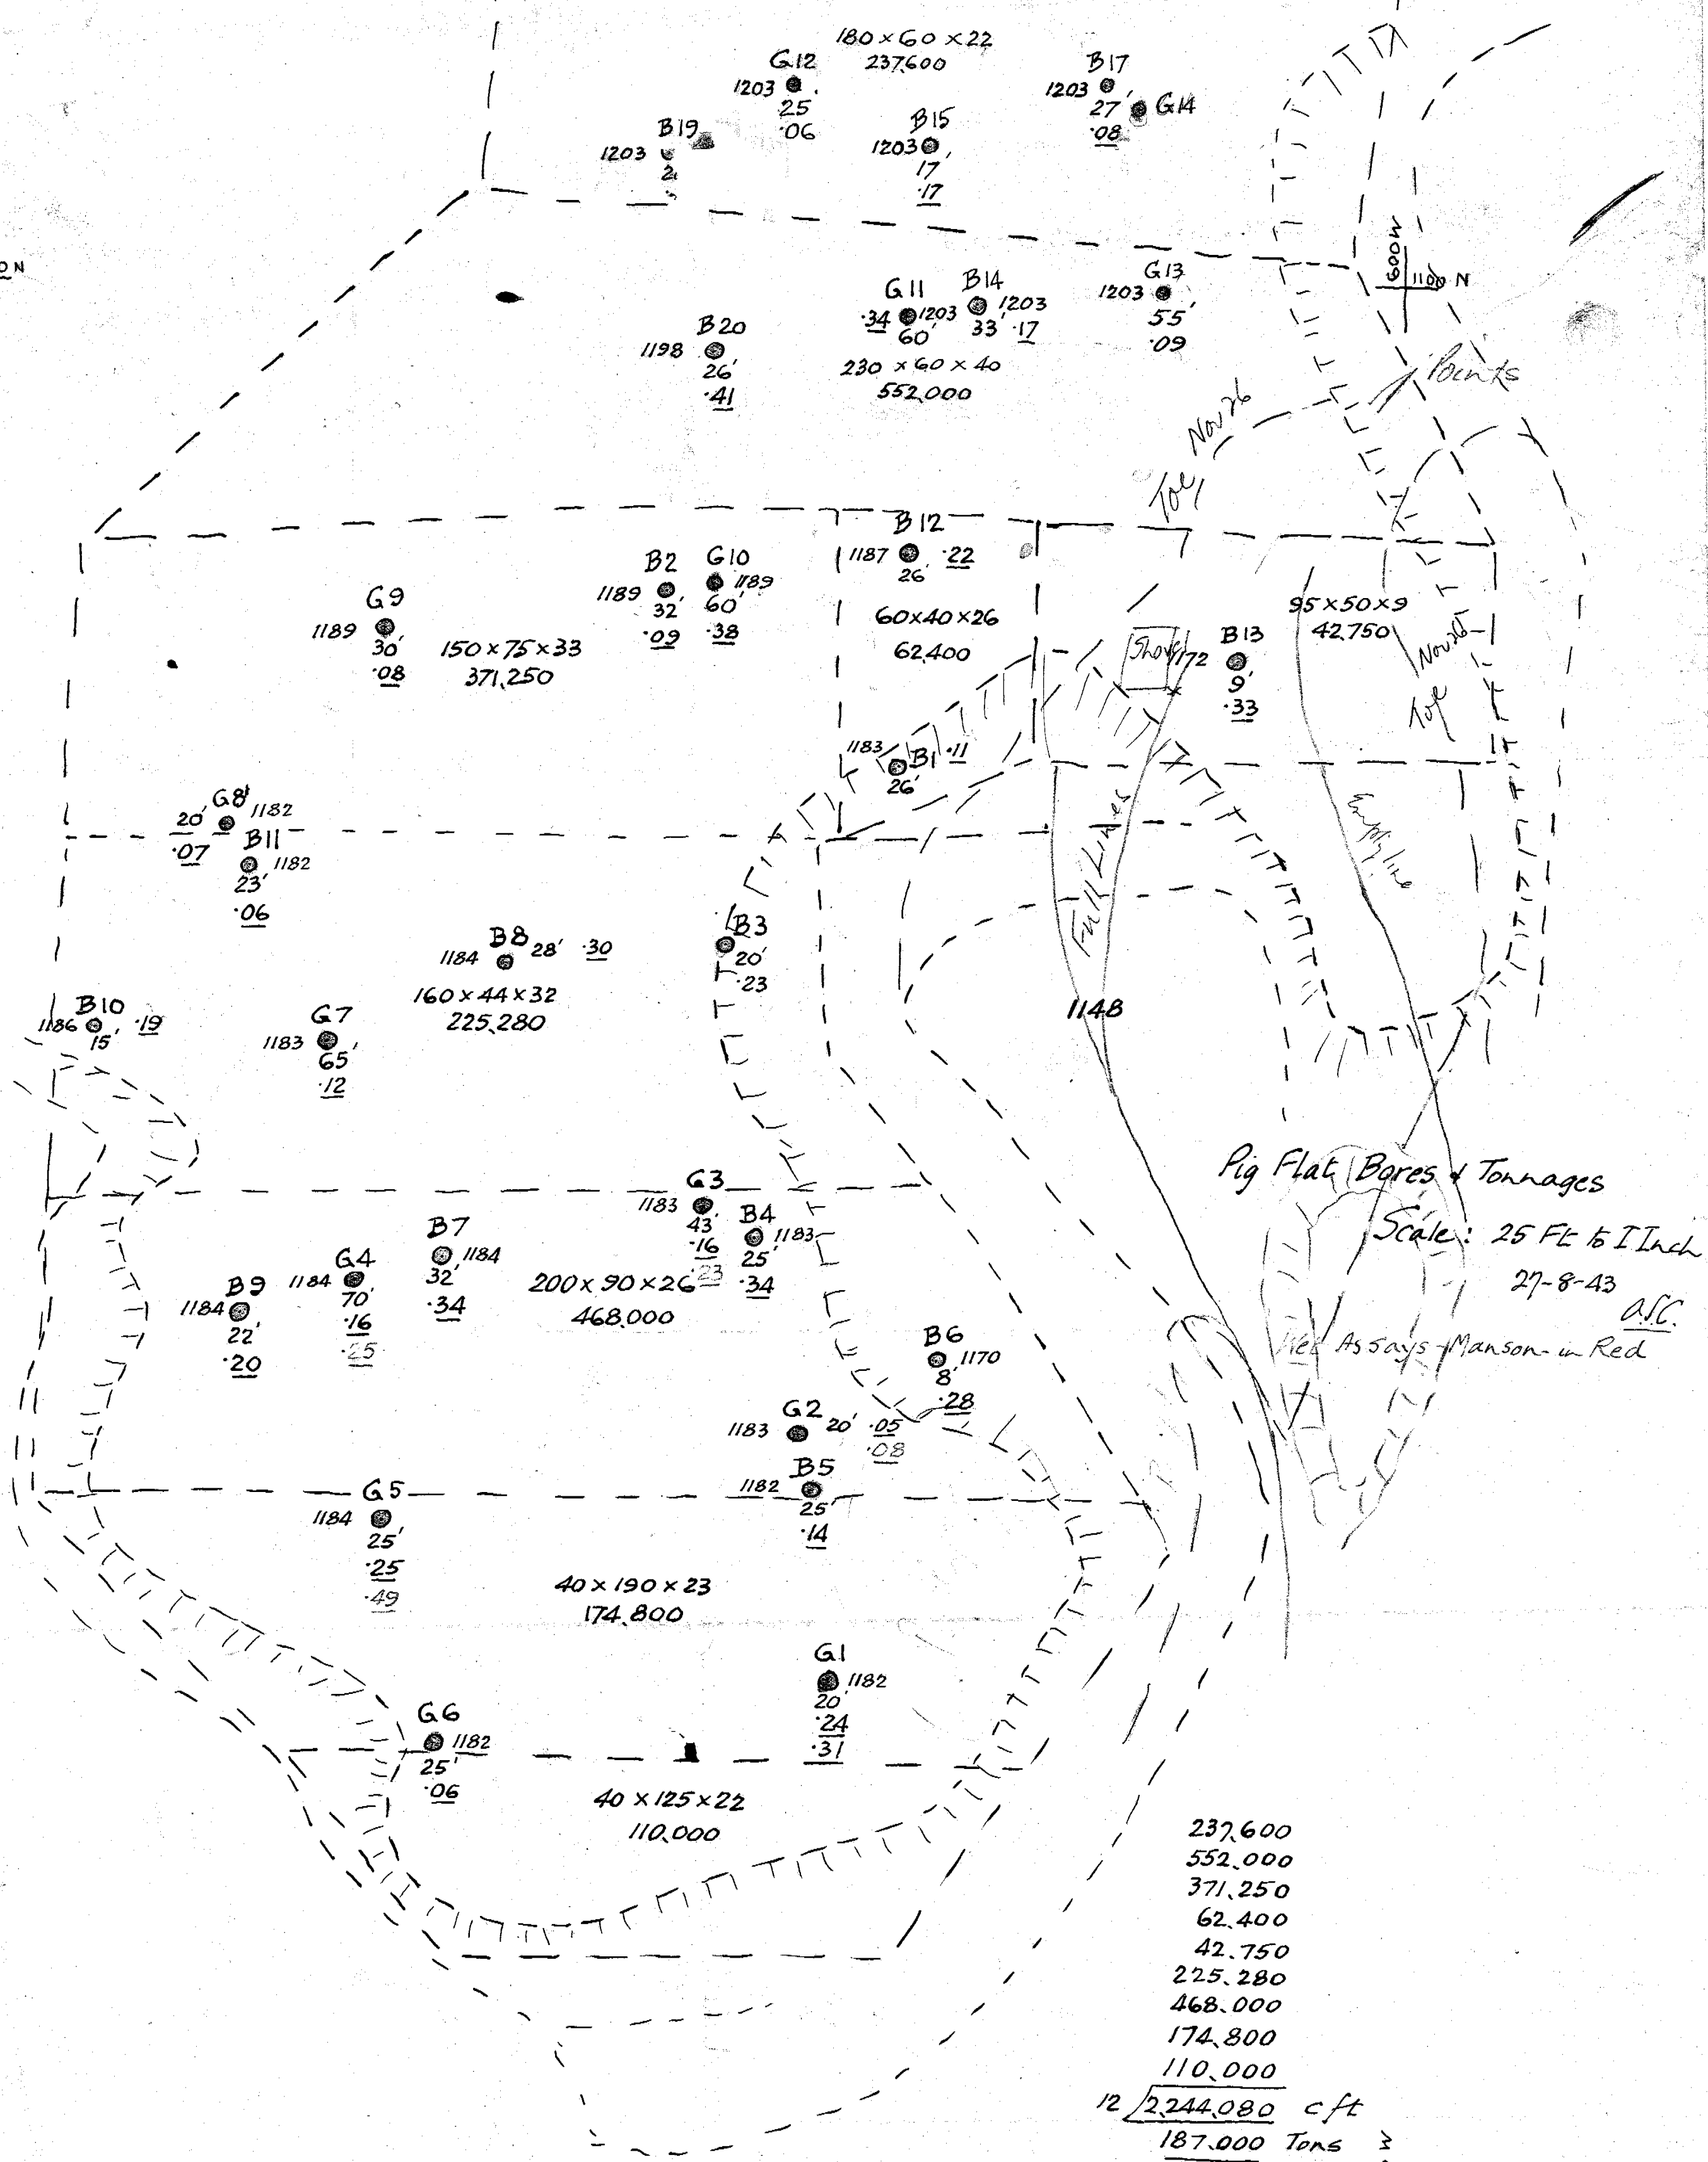

5 cm

27-222

27-222