


MOUNT BISCHOFF TIN MINE
PIG FLAT - HAPPY VALLEY
 Showing Contours as at July 1945
 Scale: 1 in. = 50 ft.

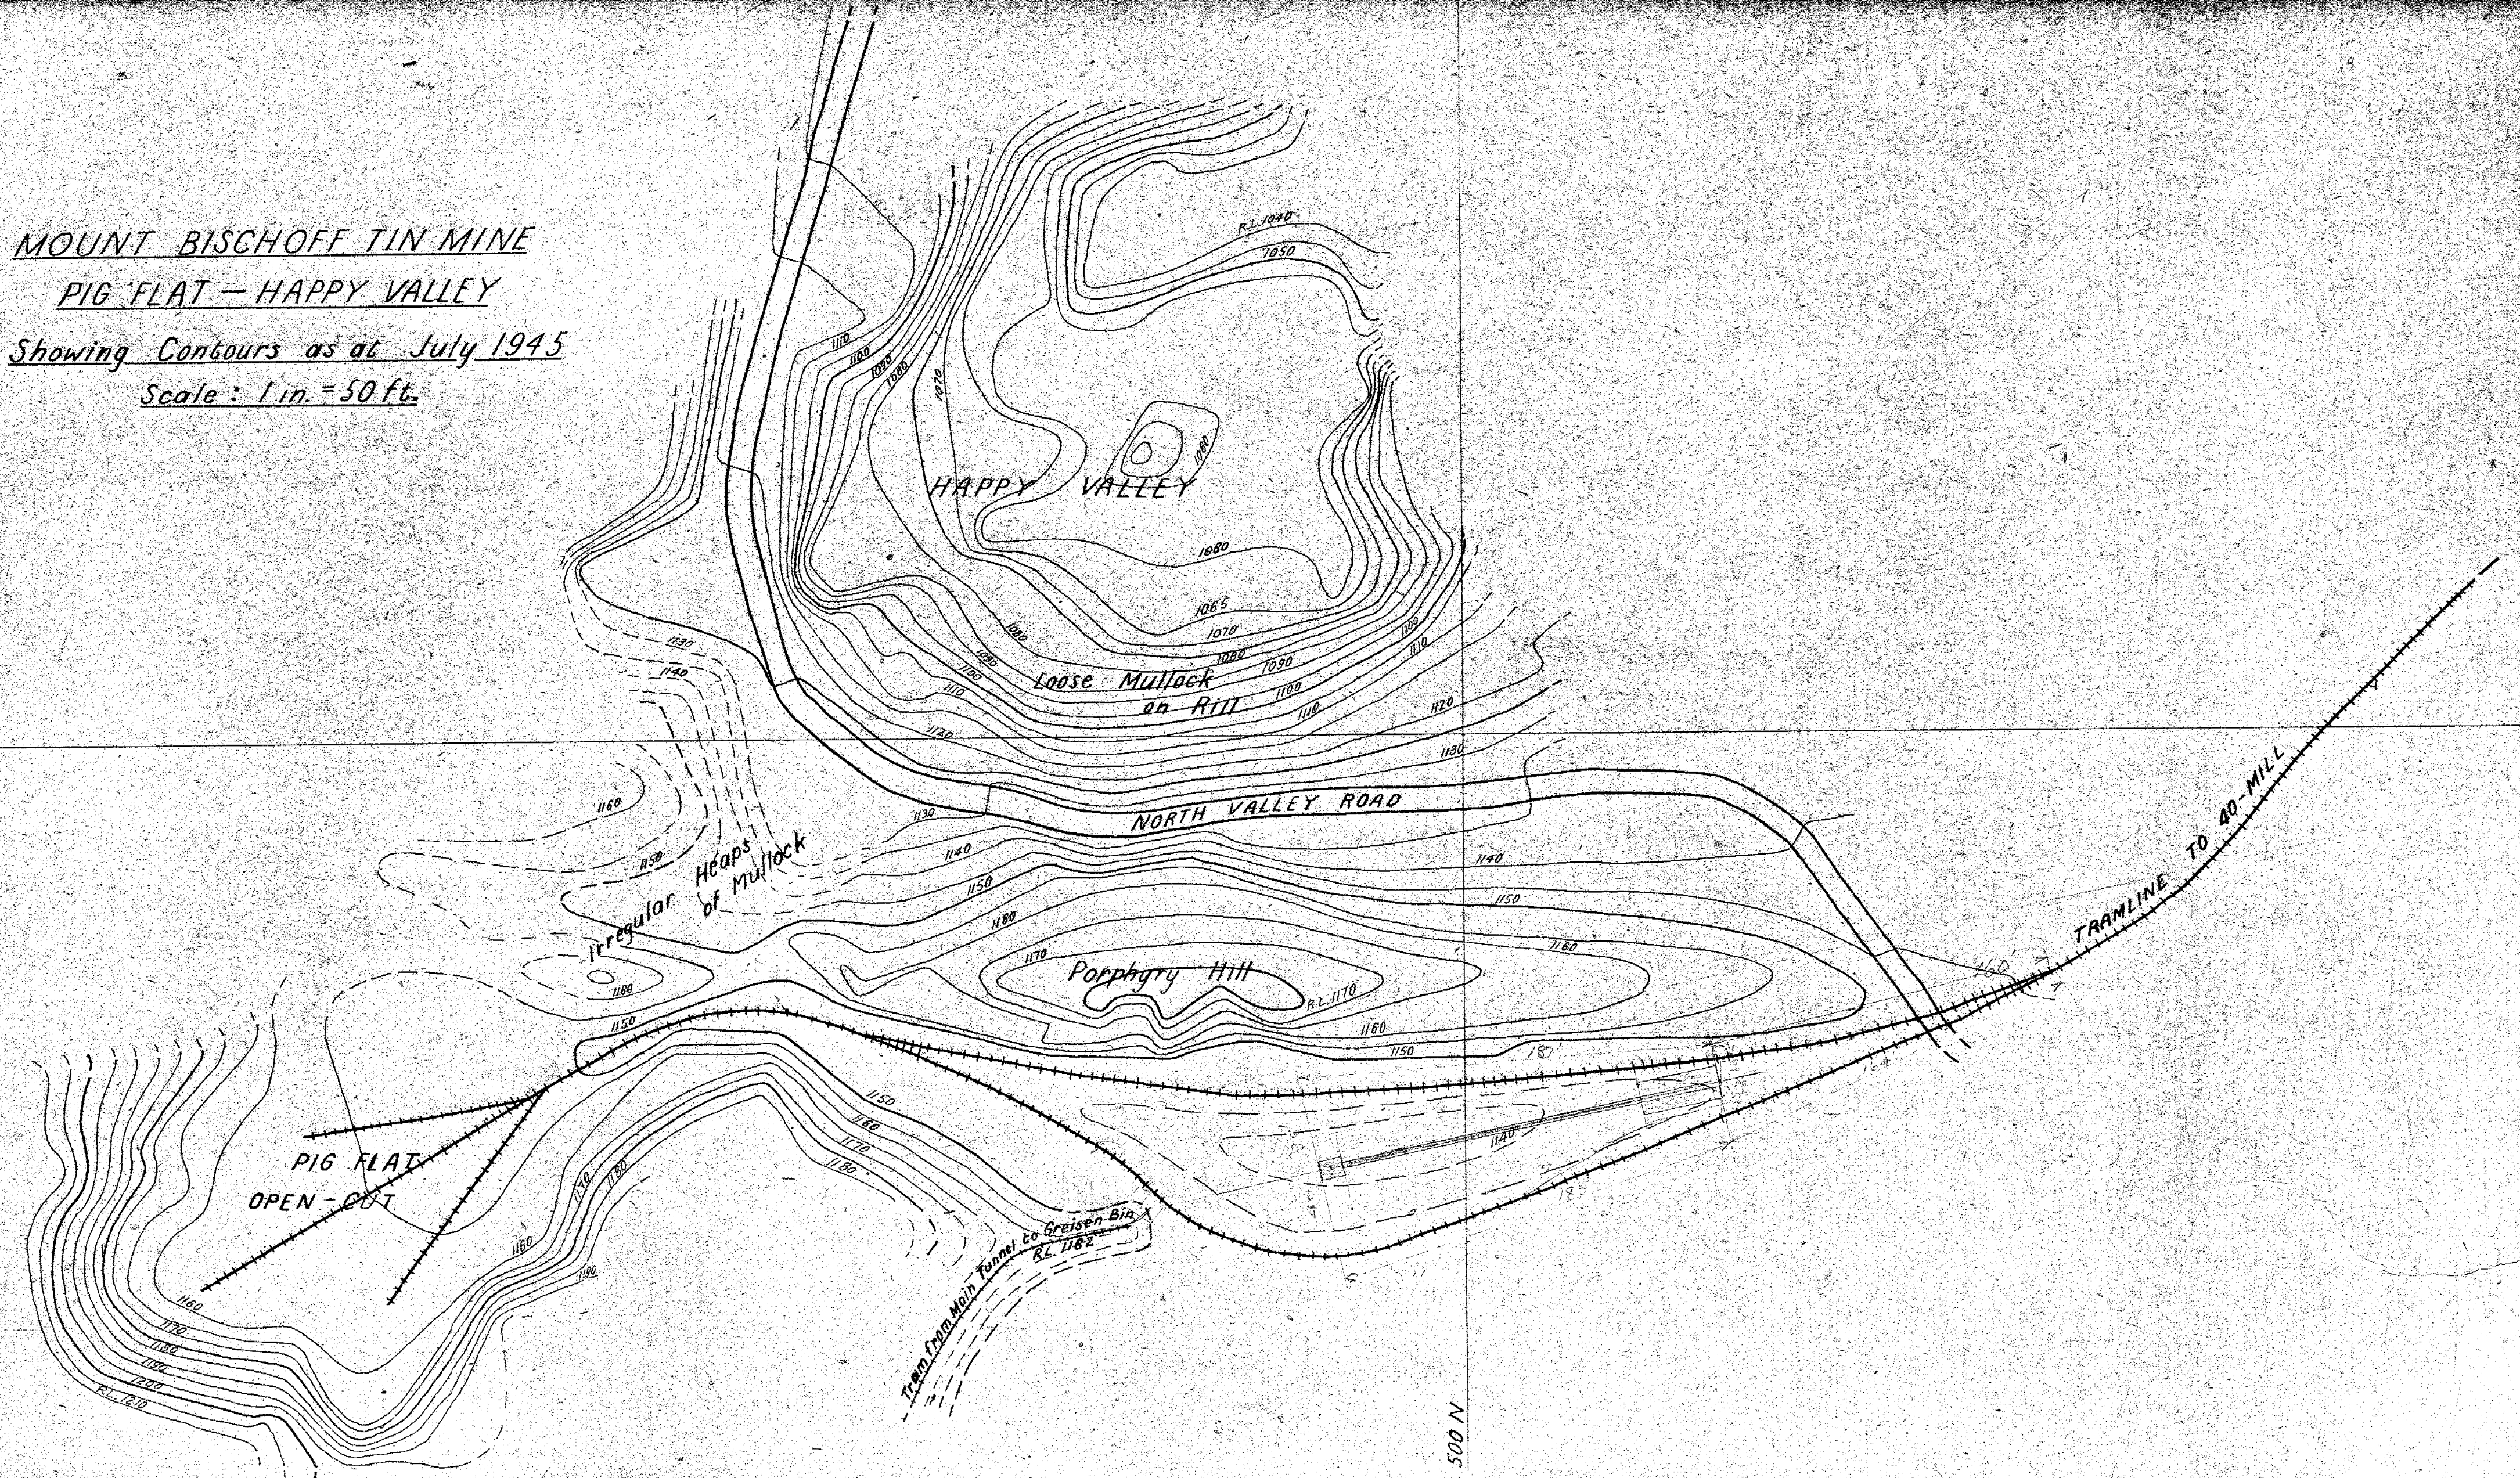

500 W

500 N

217-223

217-223

5 cm