


5 cm

217-224

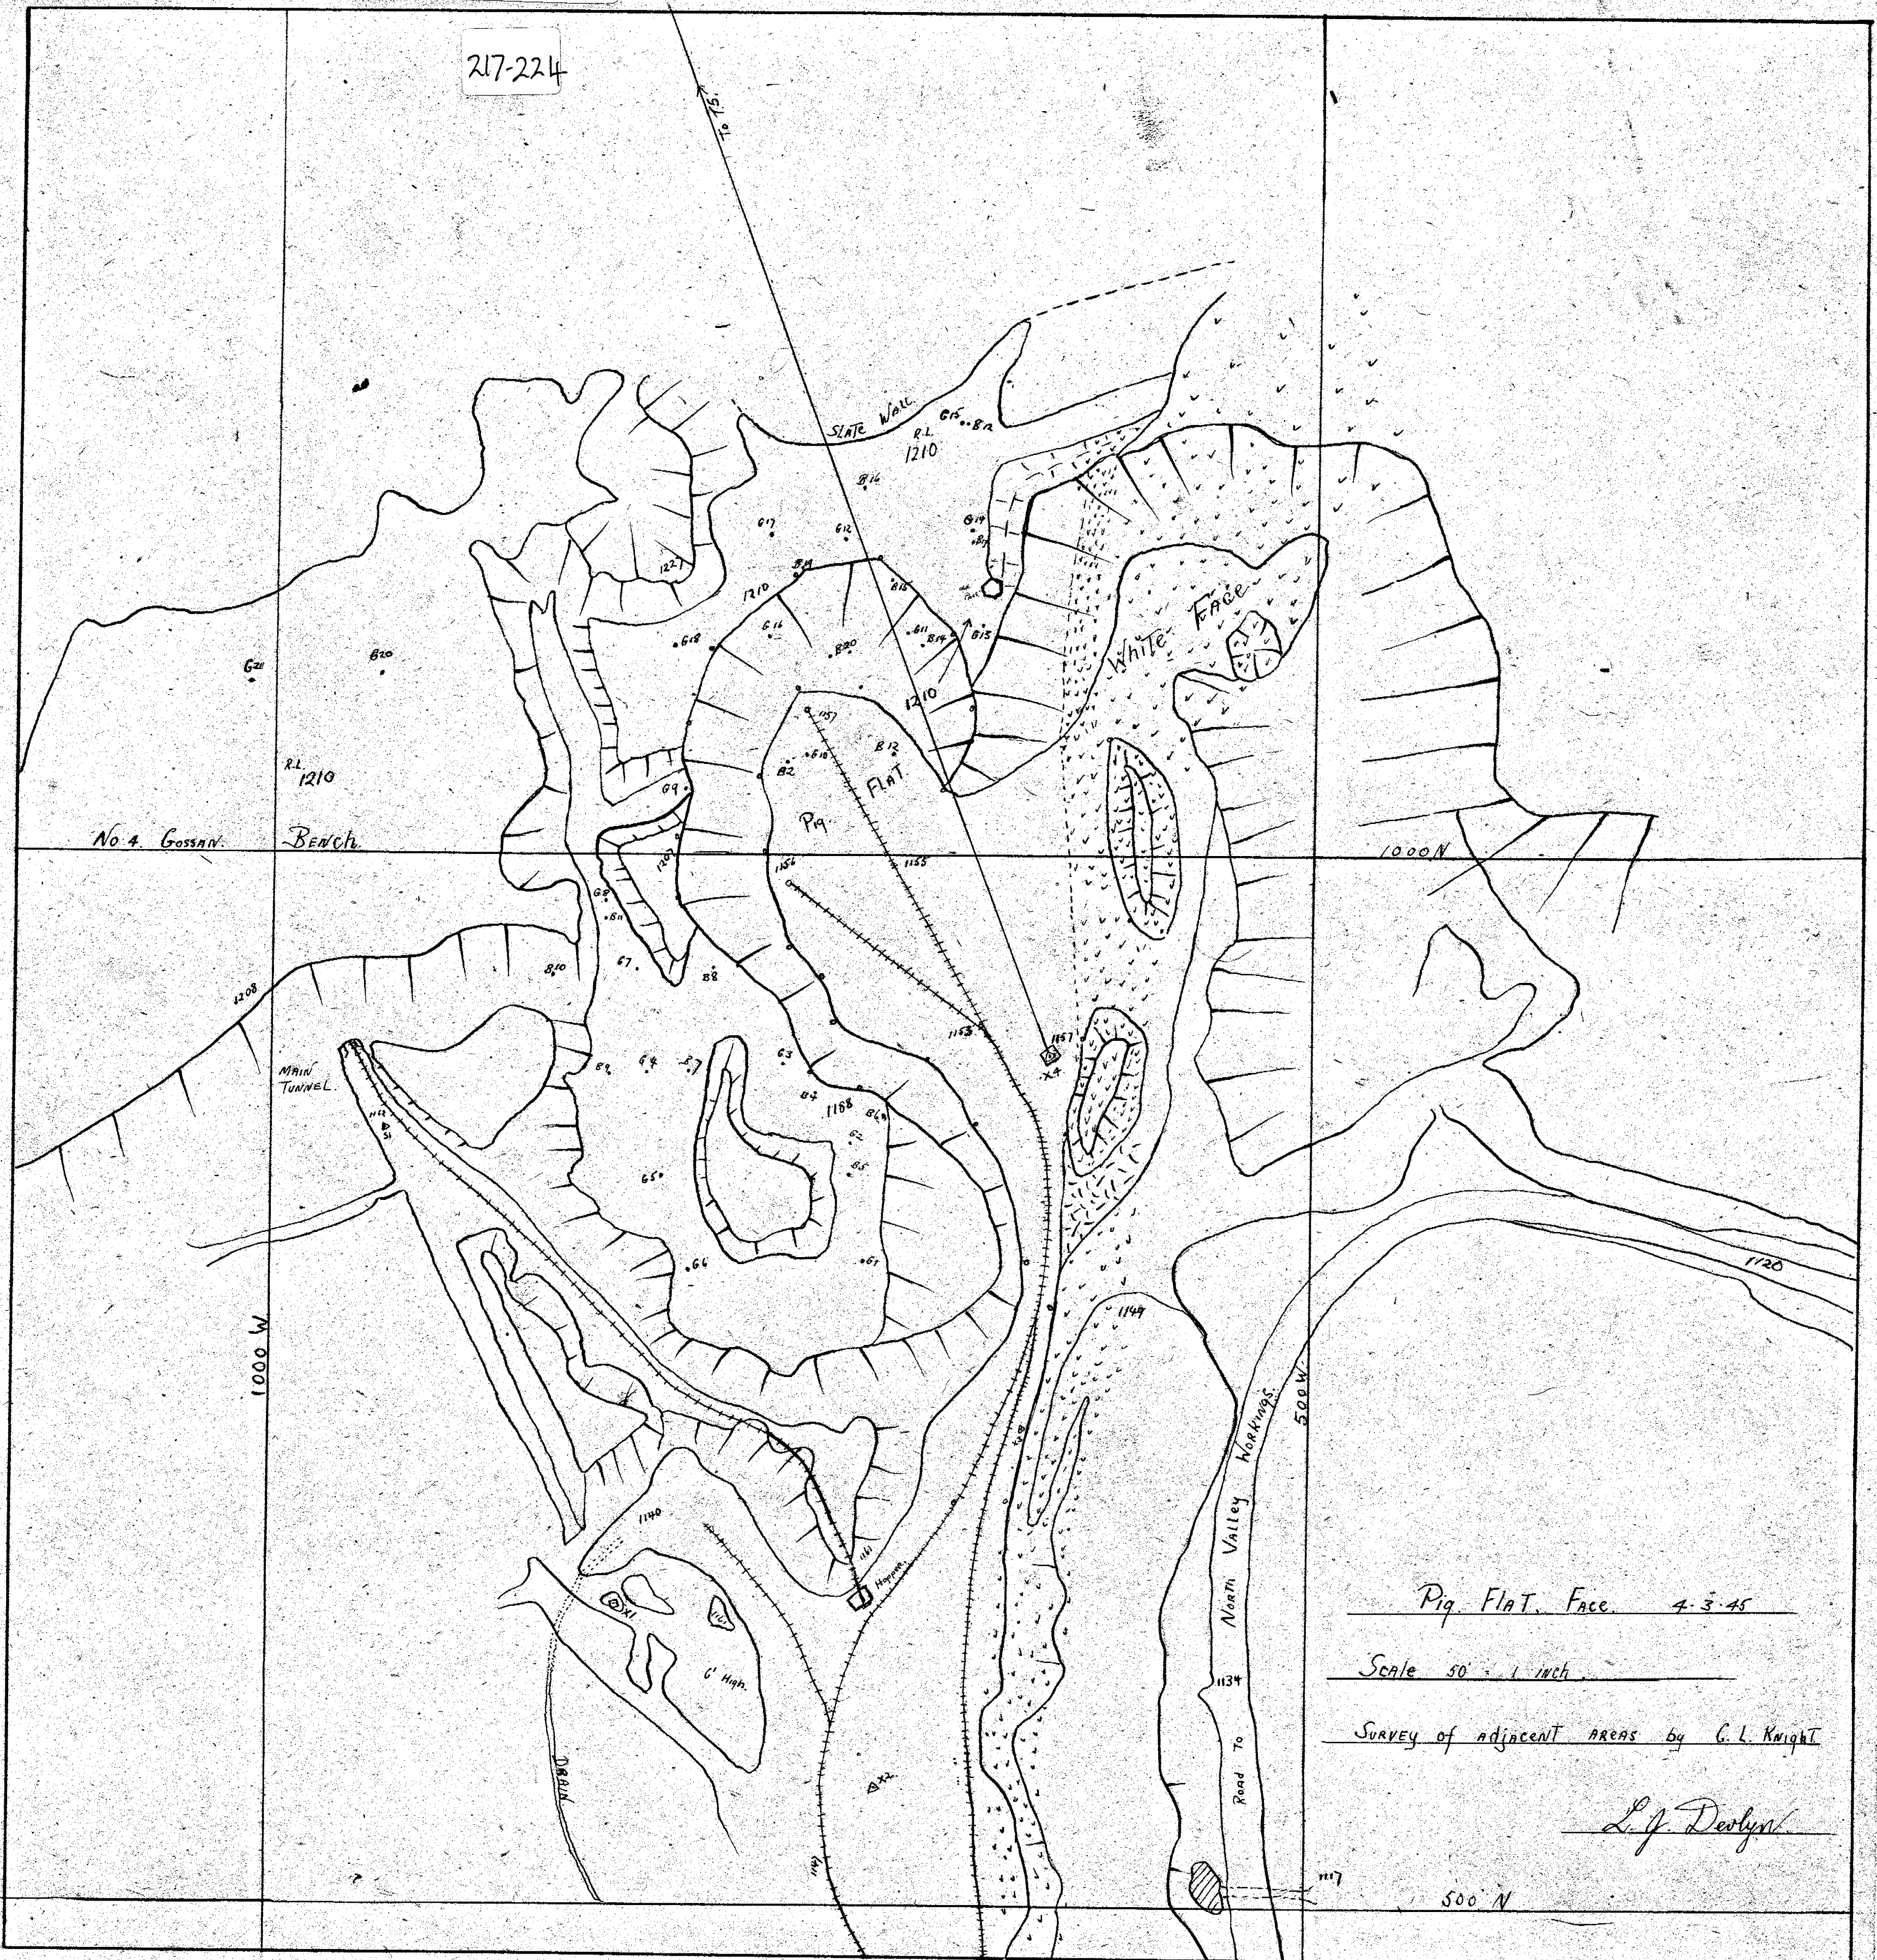

Pig Flat, Face. 4-3-45

Scale 50' = 1 inch

Survey of adjacent areas by G. L. Knight

L. J. Devlyn

500' N