


217232

NV Lode
Slopes July 1945

5 cm

217232

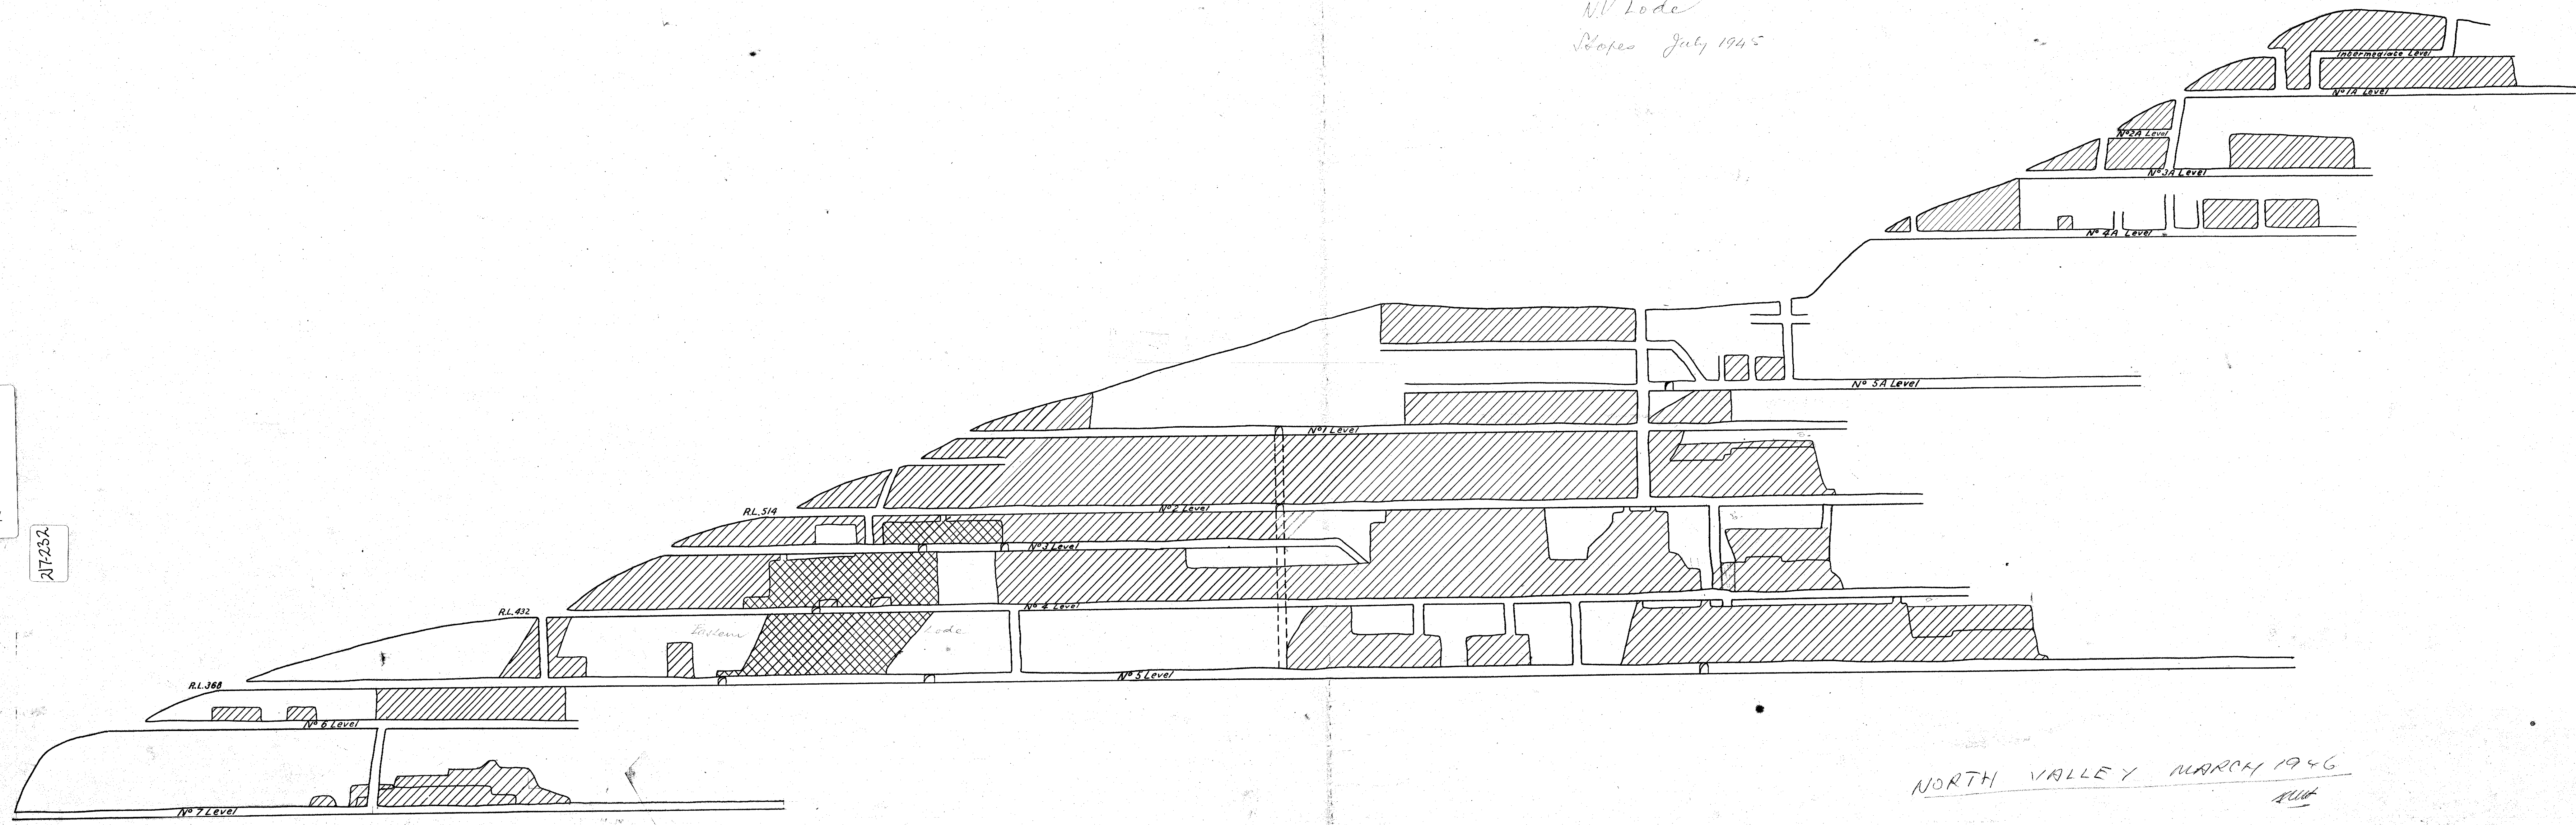

NORTH VALLEY MARCH 1946
J.M.H.