MT BISCHOFF T. M. CO. REC.

THOMPSON LODE

SCALE: 25 FT TO 1 INCH

217-257

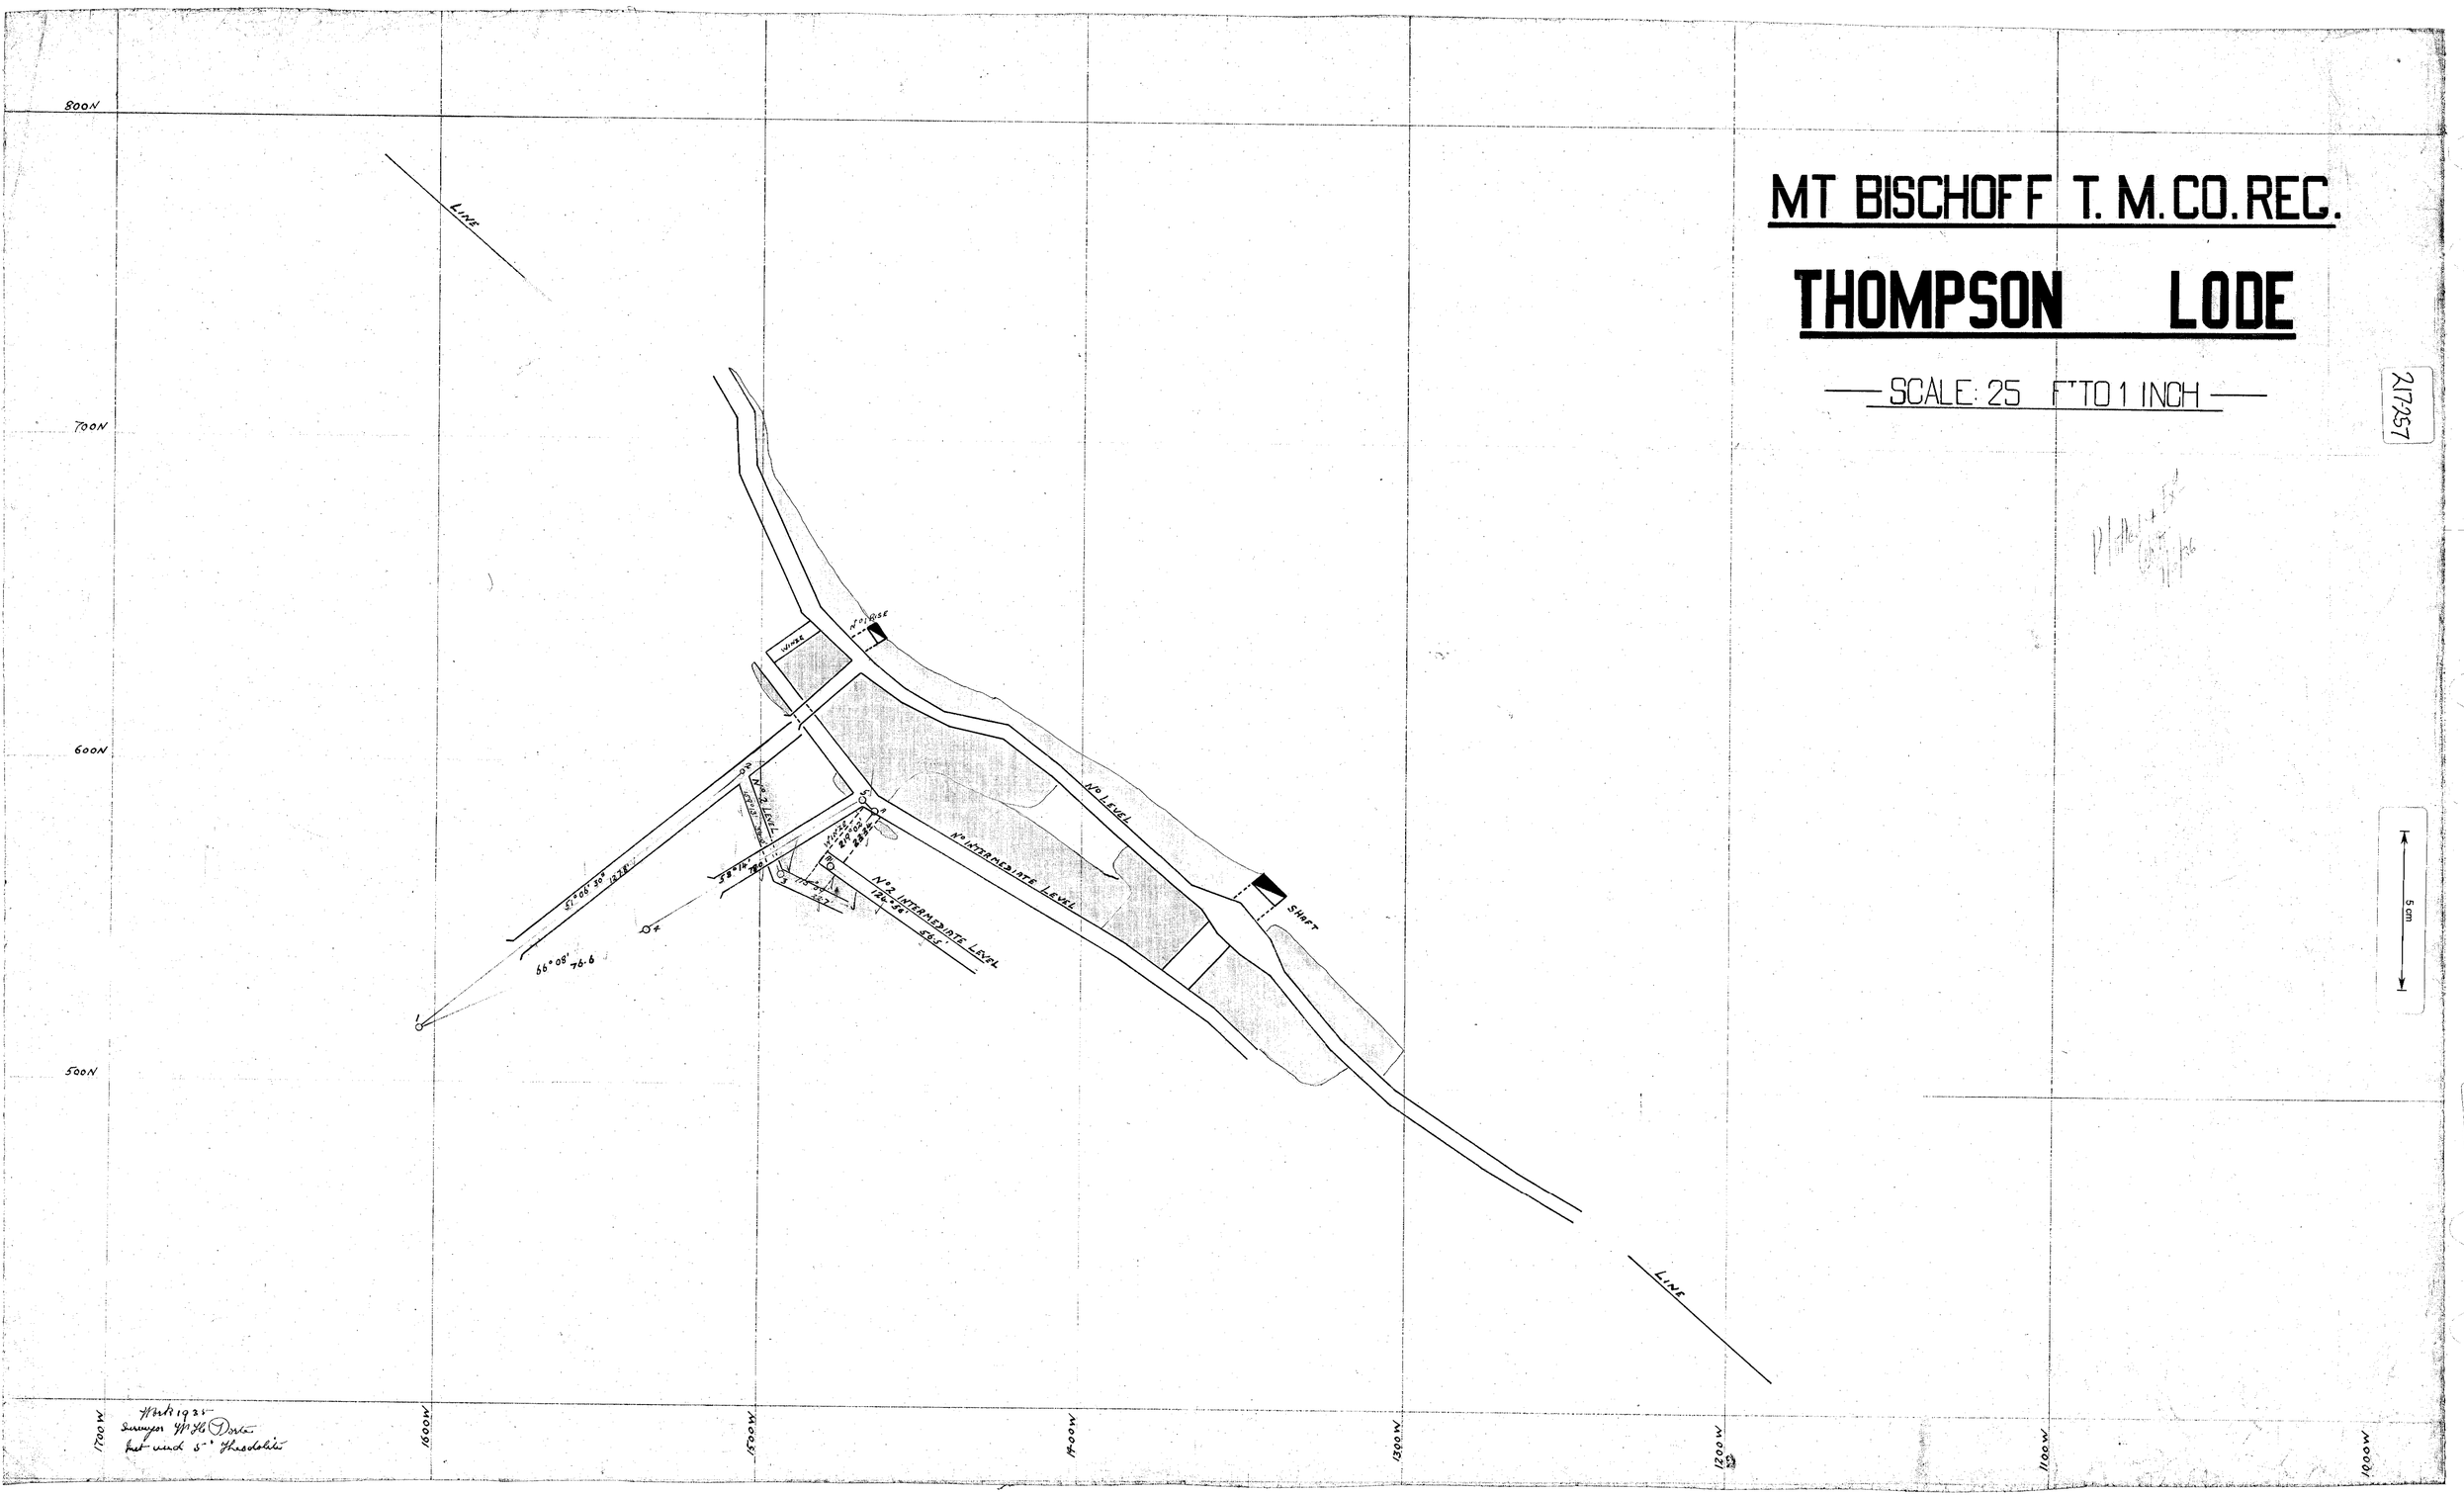

Work 1921
Surveyor W. H. Doran
Tape and 5" Theodolite