MT BISCHOFF T. M. CO. REG.

THOMPSON LODE
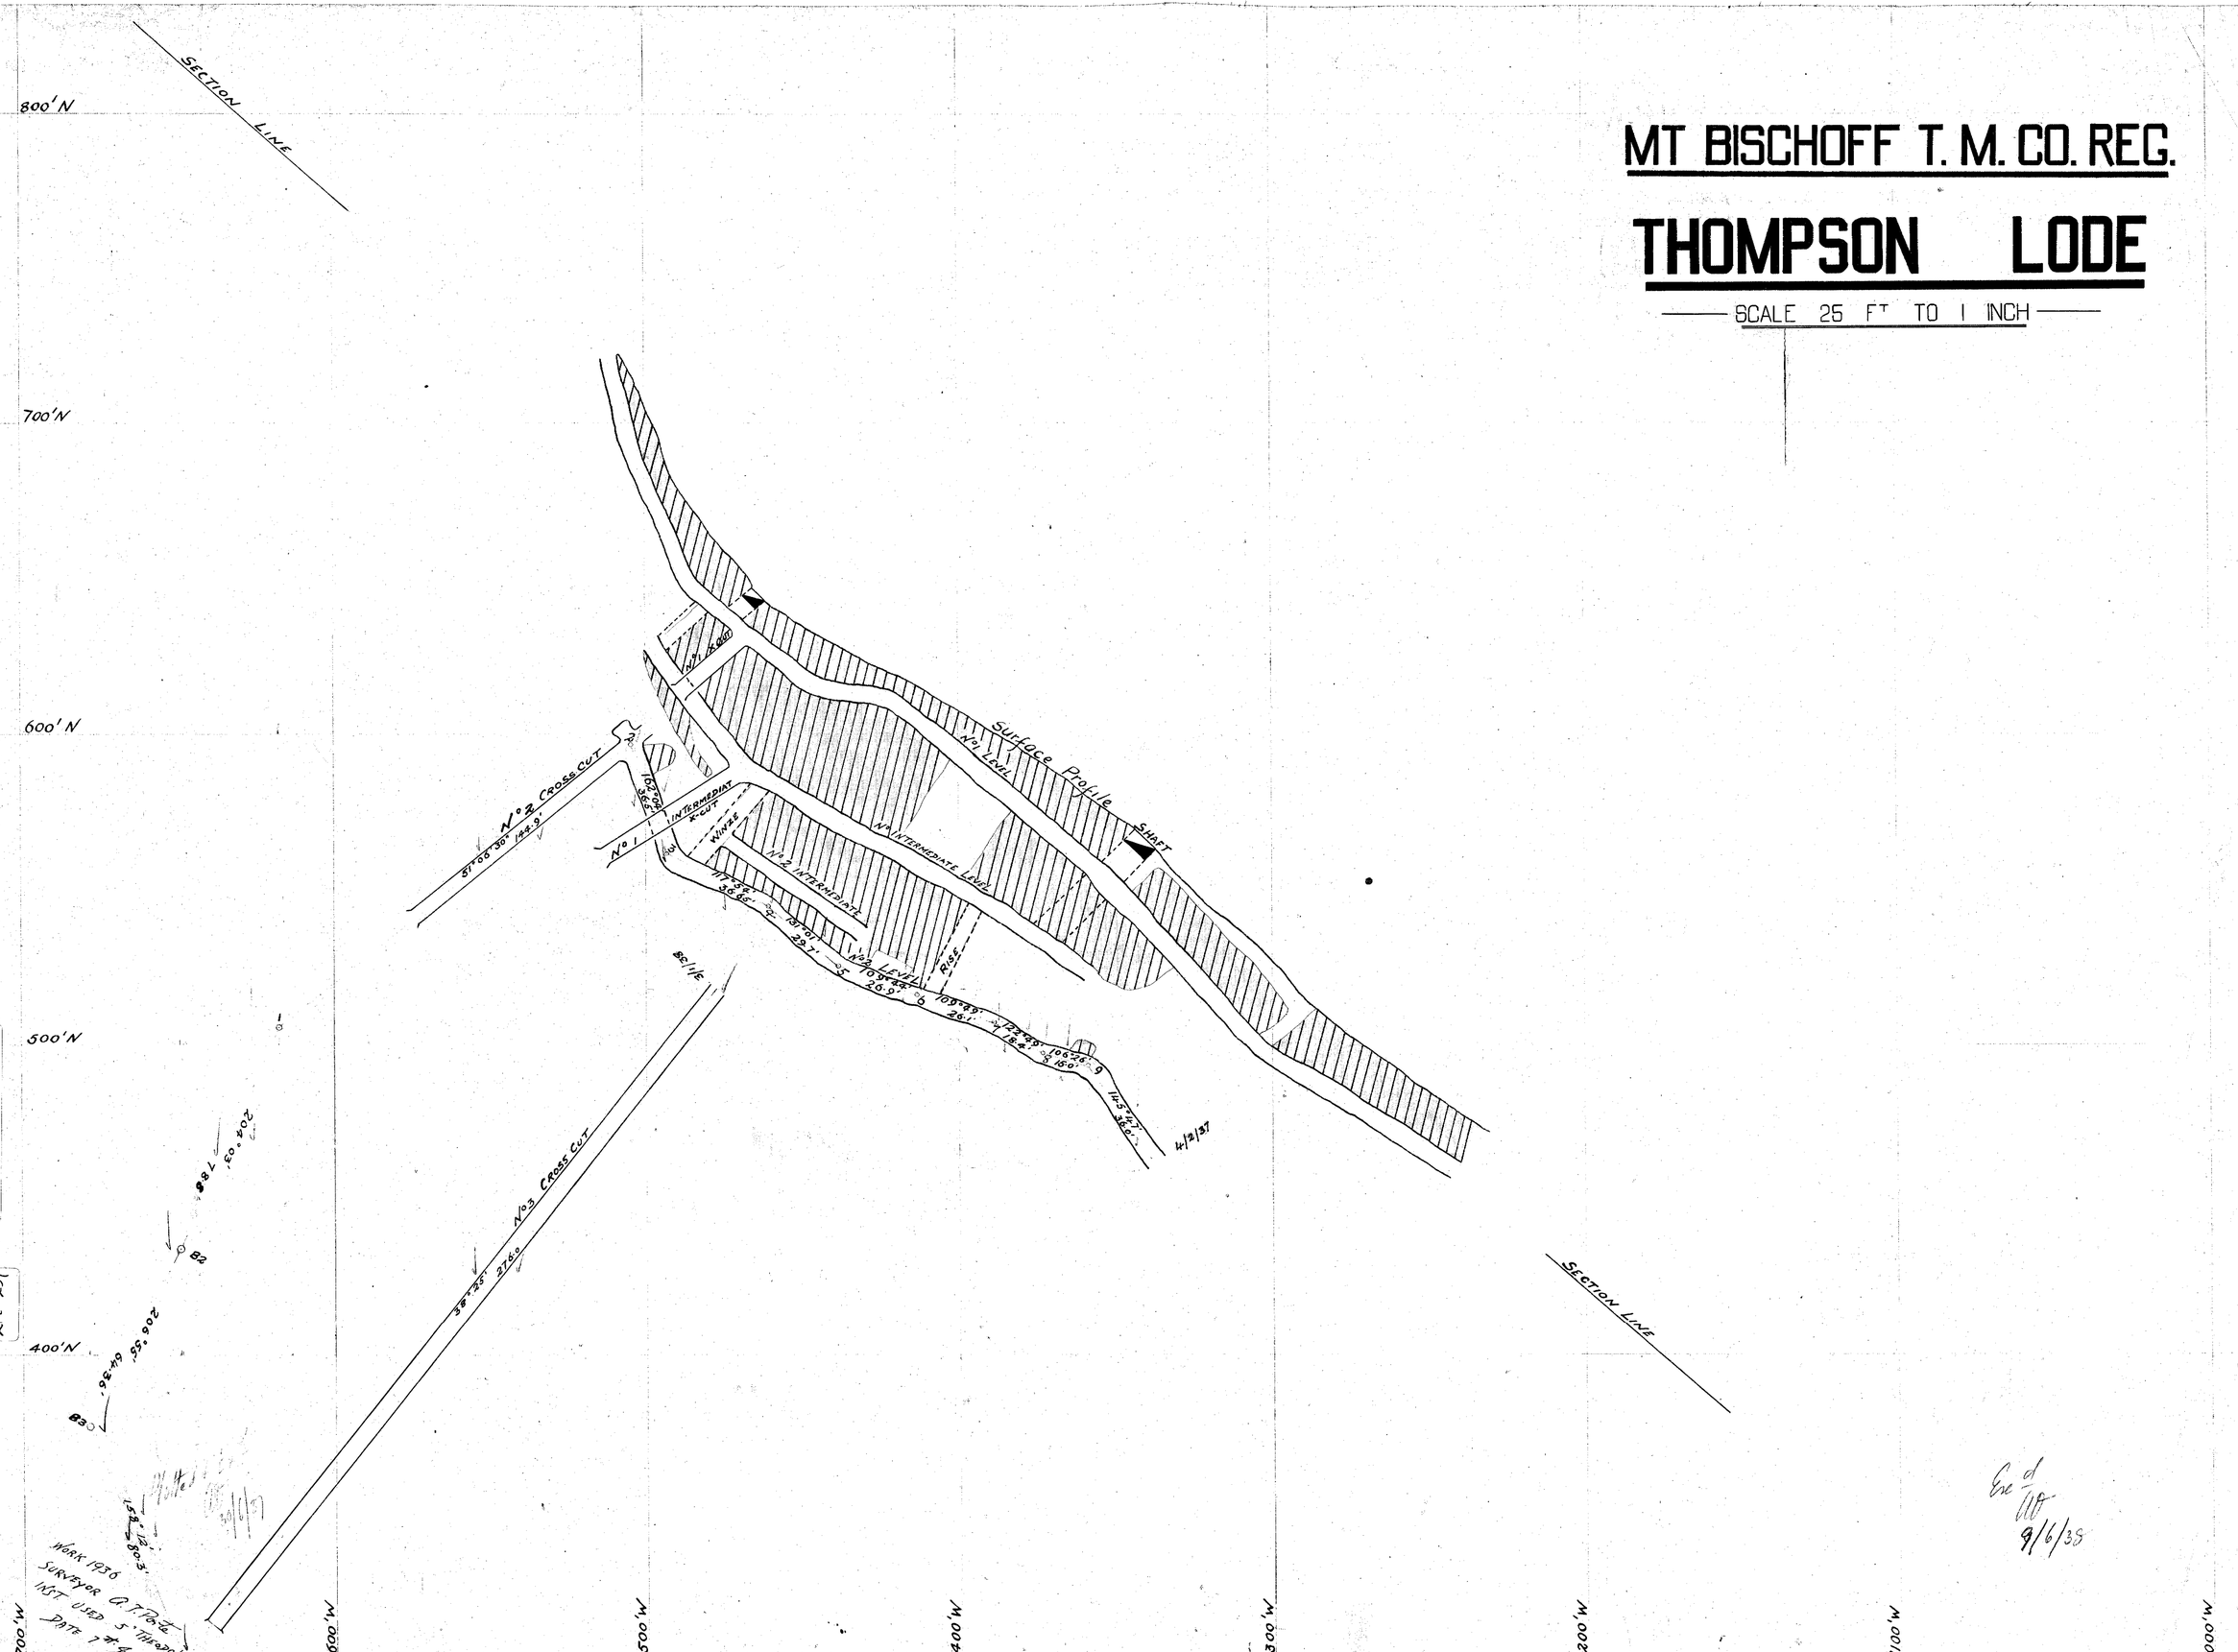
SCALE 25 FT TO 1 INCH