217-266

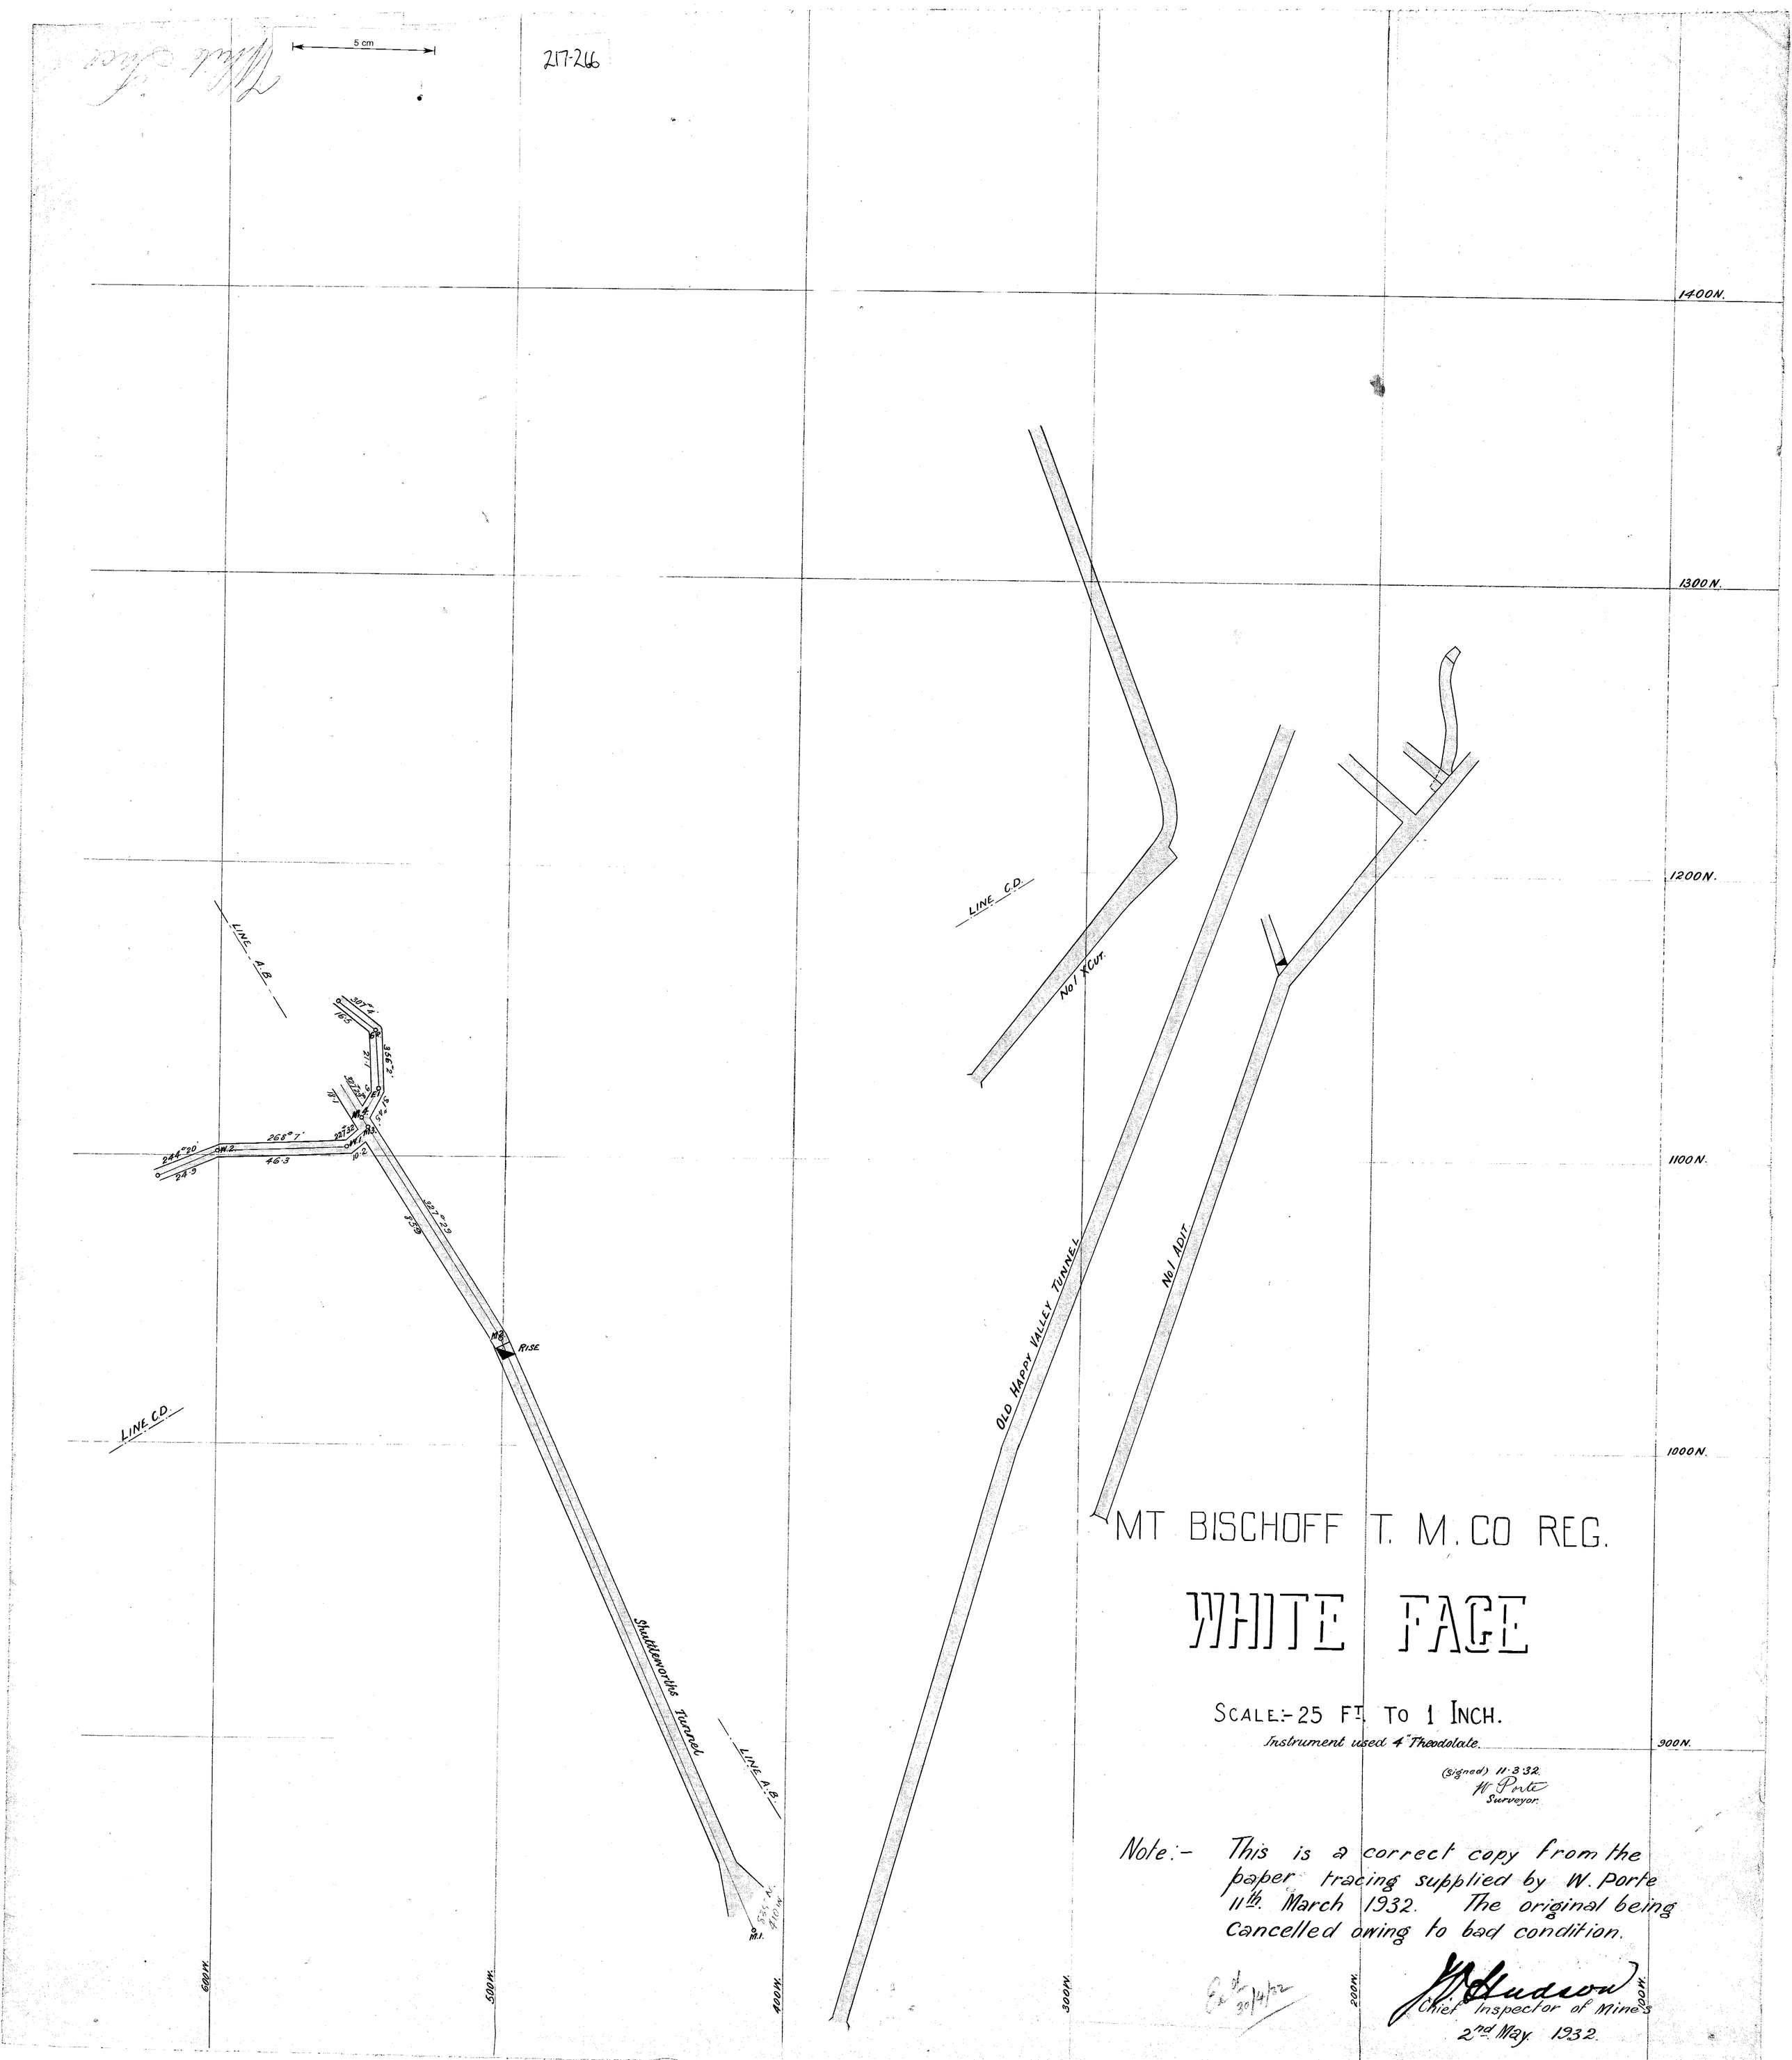
5 cm
217-266
1400N.
1300N.
1200N.
1100N.
1000N.
900N.
600W.
500W.
400W.
300W.
200W.
100W.
LINE A.B.
LINE C.D.
LINE C.D.
LINE A.B.
No1 X CUT.
OLD HAPPY VALLEY TUNNEL
No1 ADIT
Shuttleworths Tunnel
RISE
MT BISCHOFF T. M. CO REG.
WHITE FACE
SCALE:- 25 FT. TO 1 INCH.
Instrument used 4" Theodolite.
(Signed) 11.3.32.
W. Porte
Surveyor.
Note:- This is a correct copy from the paper tracing supplied by W. Porte 11th March 1932. The original being cancelled owing to bad condition.
Chief Inspector of Mines
2nd May 1932.