


5 cm

217-280



No	Depth	Value
1.	12"	.85%
2.	9"	.40%
3.	24"	.70%
4.	18"	.10%
5.	24"	.10%
6.	24"	.15%
7.	30"	1.00
8.	24"	.48%
9.	36"	.35%
10.	24"	.12%
11.	21"	.21%
12.	18"	.58%
13.		
14.		
15.		
16.		
17.		
18.		
19.		
20.		

217-280

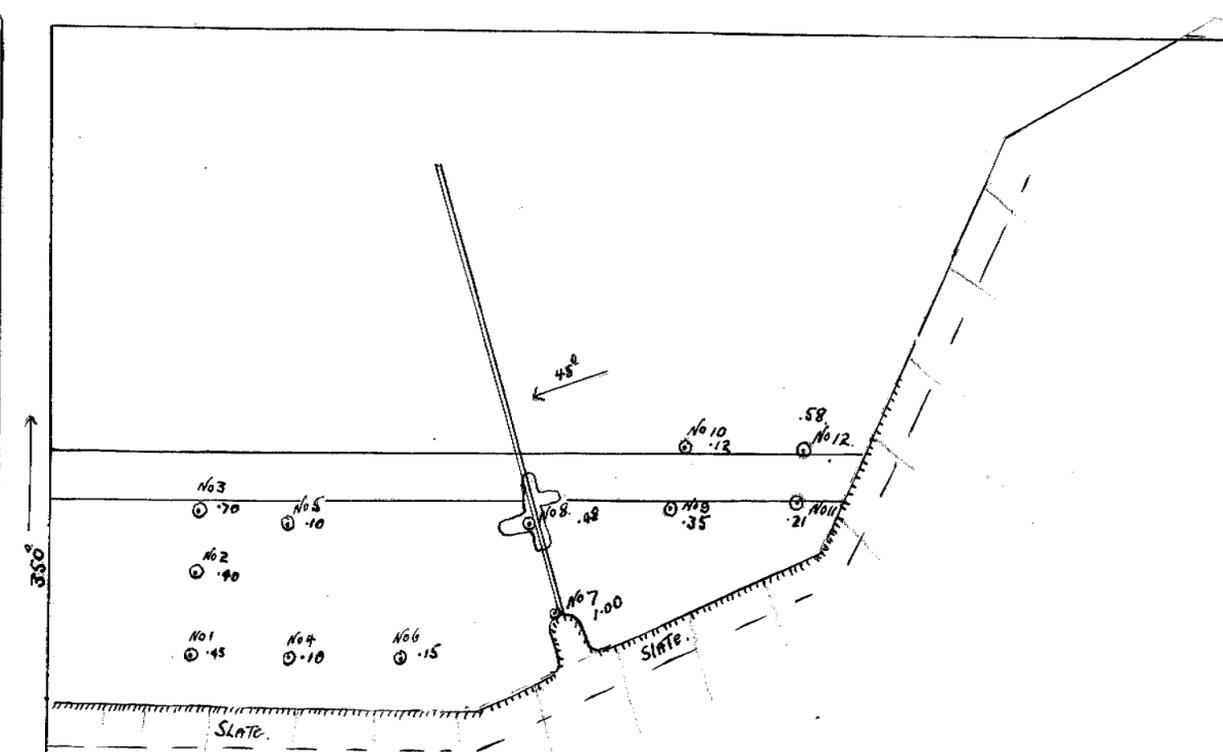

Griesen. Ore body

Sampling of Wash Above Griesen.
 Scale 20' = 1" 6-2-46

[Signature]



Haulage