279-281

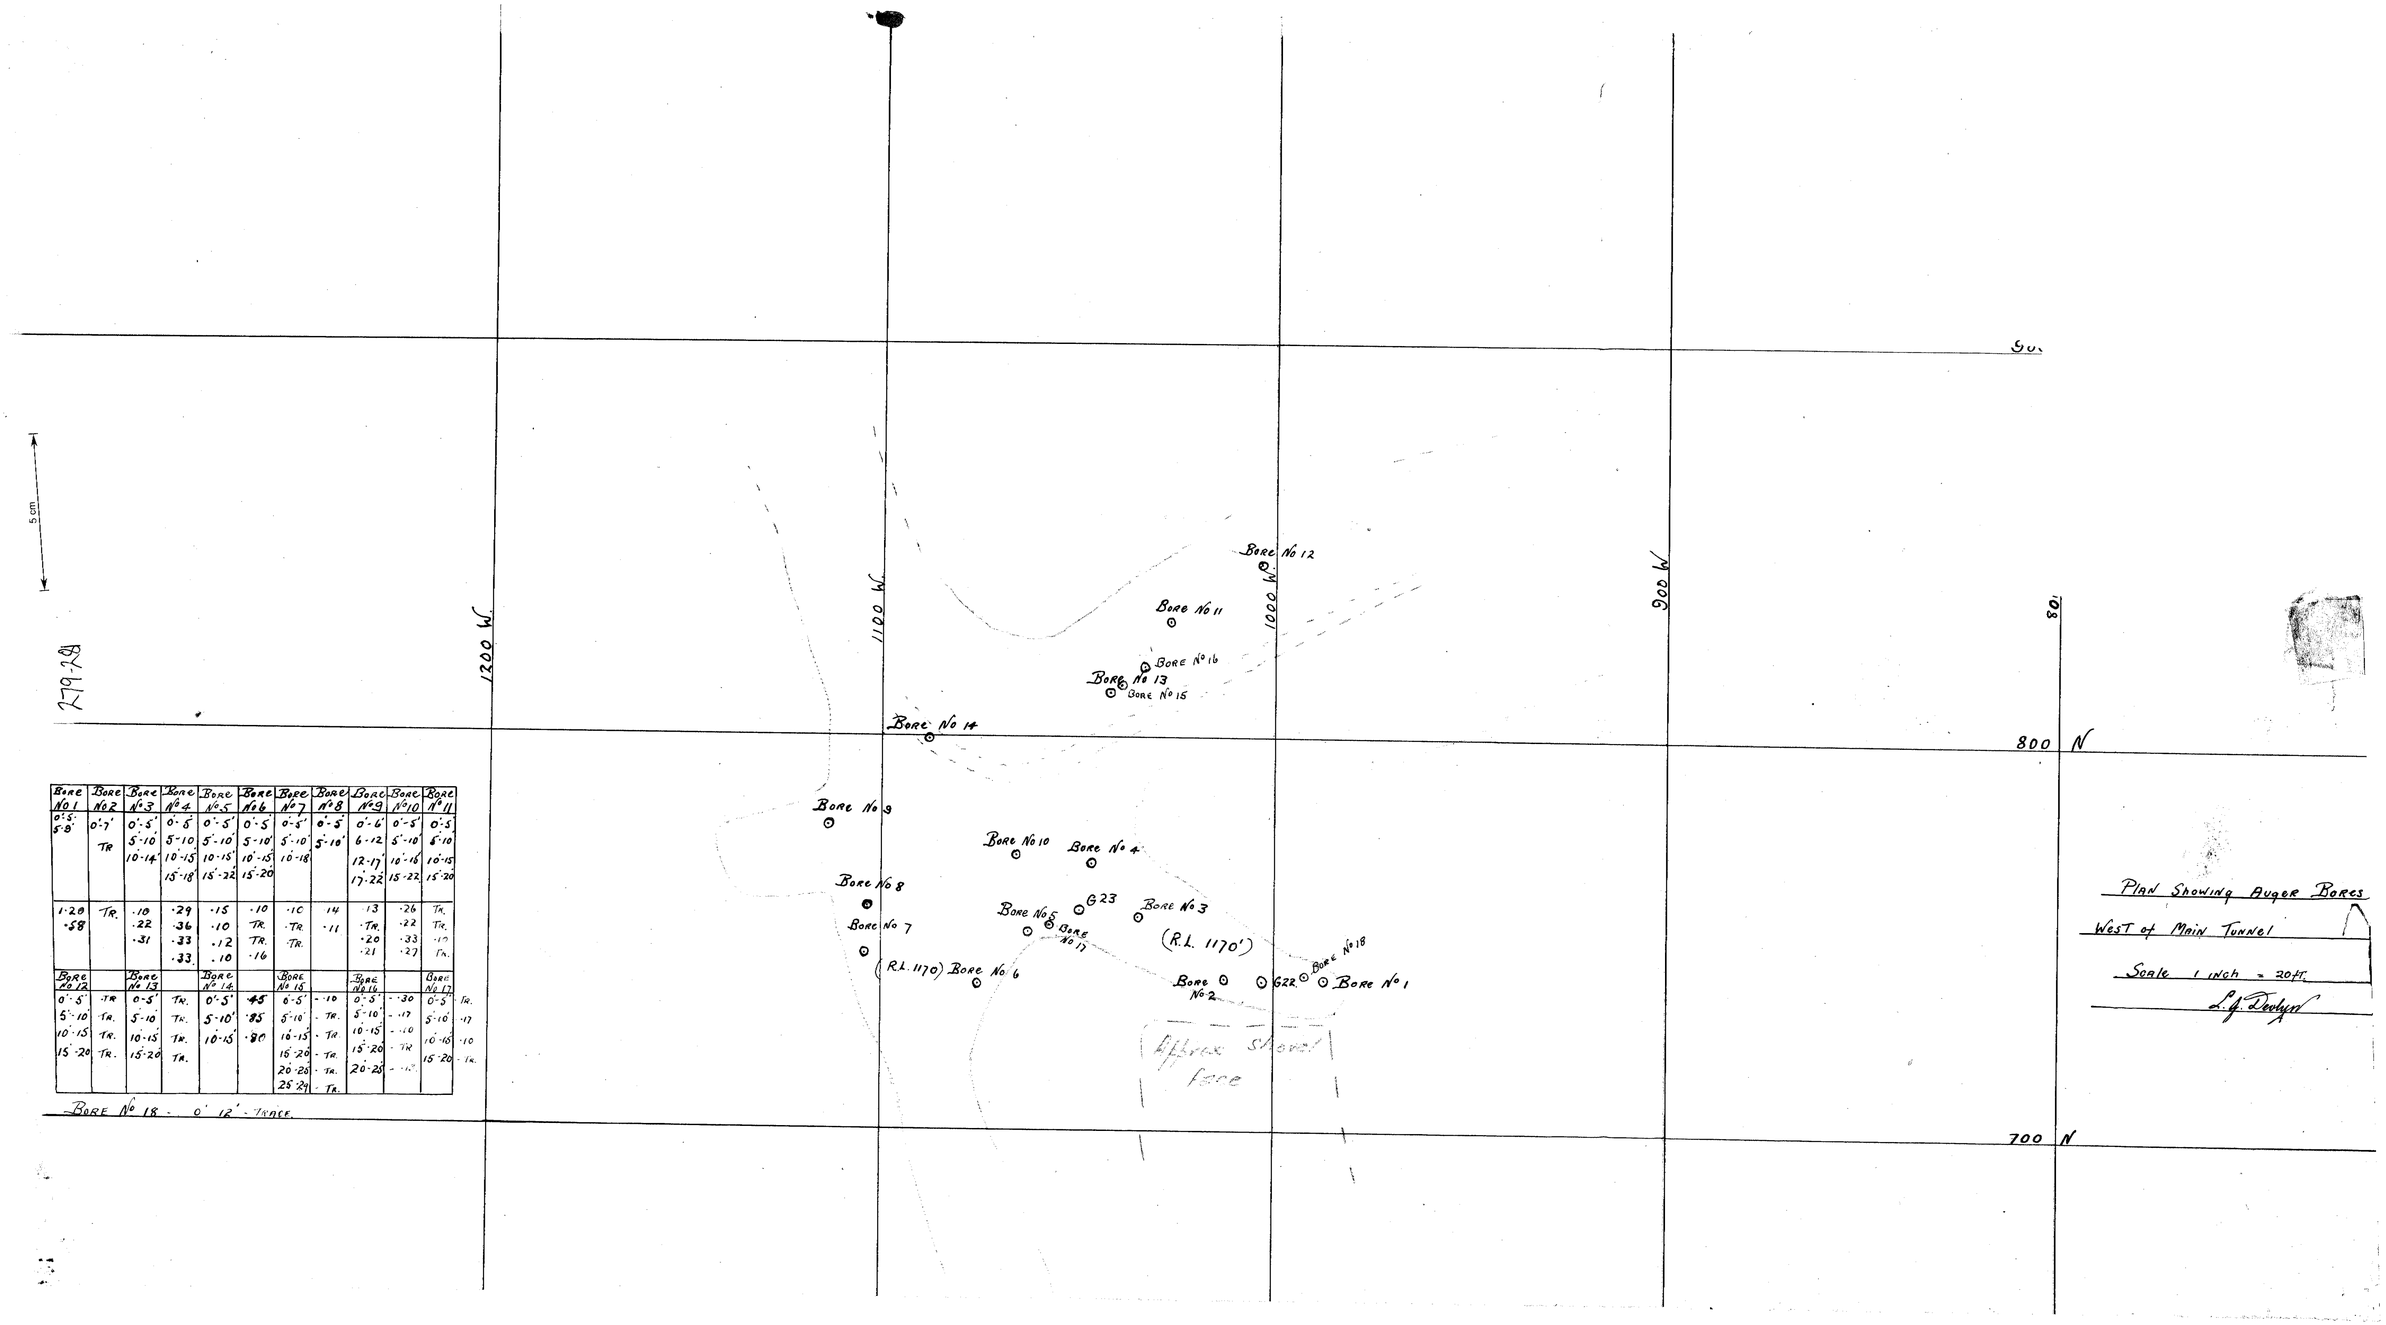

Bore No 1	Bore No 2	Bore No 3	Bore No 4	Bore No 5	Bore No 6	Bore No 7	Bore No 8	Bore No 9	Bore No 10	Bore No 11
0'-5' 5-8'	0'-7' TR	0'-5' 5'-10' 10'-14'	0'-5' 5'-10 10'-15' 15'-18'	0'-5' 5'-10' 10'-15' 15'-22'	0'-5' 5'-10' 10'-15' 15'-20	0'-5' 5'-10' 10'-18	0'-5' 5'-10'	0'-6' 6'-12 12'-17' 17'-22'	0'-5' 5'-10' 10'-16 15'-22	0'-5 5'-10 10'-15 15'-20
1·20 ·58	TR.	·10 ·22 ·31	·29 ·36 ·33 ·33	·15 ·10 ·12 ·10	·10 TR. TR. ·16	·10 ·TR TR.	·14 ·11	·13 ·TR. ·20 ·21	·26 ·22 ·33 ·27	TR. TR. ·17 TR.

Bore No 12		Bore No 13		Bore No 14		Bore No 15		Bore No 16		Bore No 17	
0'-5' 5'-10' 10'-15 15'-20	·TR ·TR. TR. TR.	0'-5' 5'-10 10'-15 15'-20	TR. TR. TR. TR.	0'-5' 5'-10' 10'-15'	·45 ·85 ·80	0'-5' 5'-10 10'-15 15'-20 20'-25 25'-29	- ·10 - TR. - TR. - TR. - TR. - TR.	0'-5' 5'-10' 10'-15' 15'-20 20'-25'	- ·30 - ·17 - ·10 - TR - ·12	0'-5' 5'-10' 10'-15 15'-20	TR. ·17 ·10 - TR.

Bore No 18 - 0' 12' - TRACE.

Plan Showing Auger Bores
West of Main Tunnel
Scale 1 inch = 20 ft.
L. J. Doolyn