Mt BISCHOFF EXTENDED T.M.Co

MINE SECTION

50 — 1'

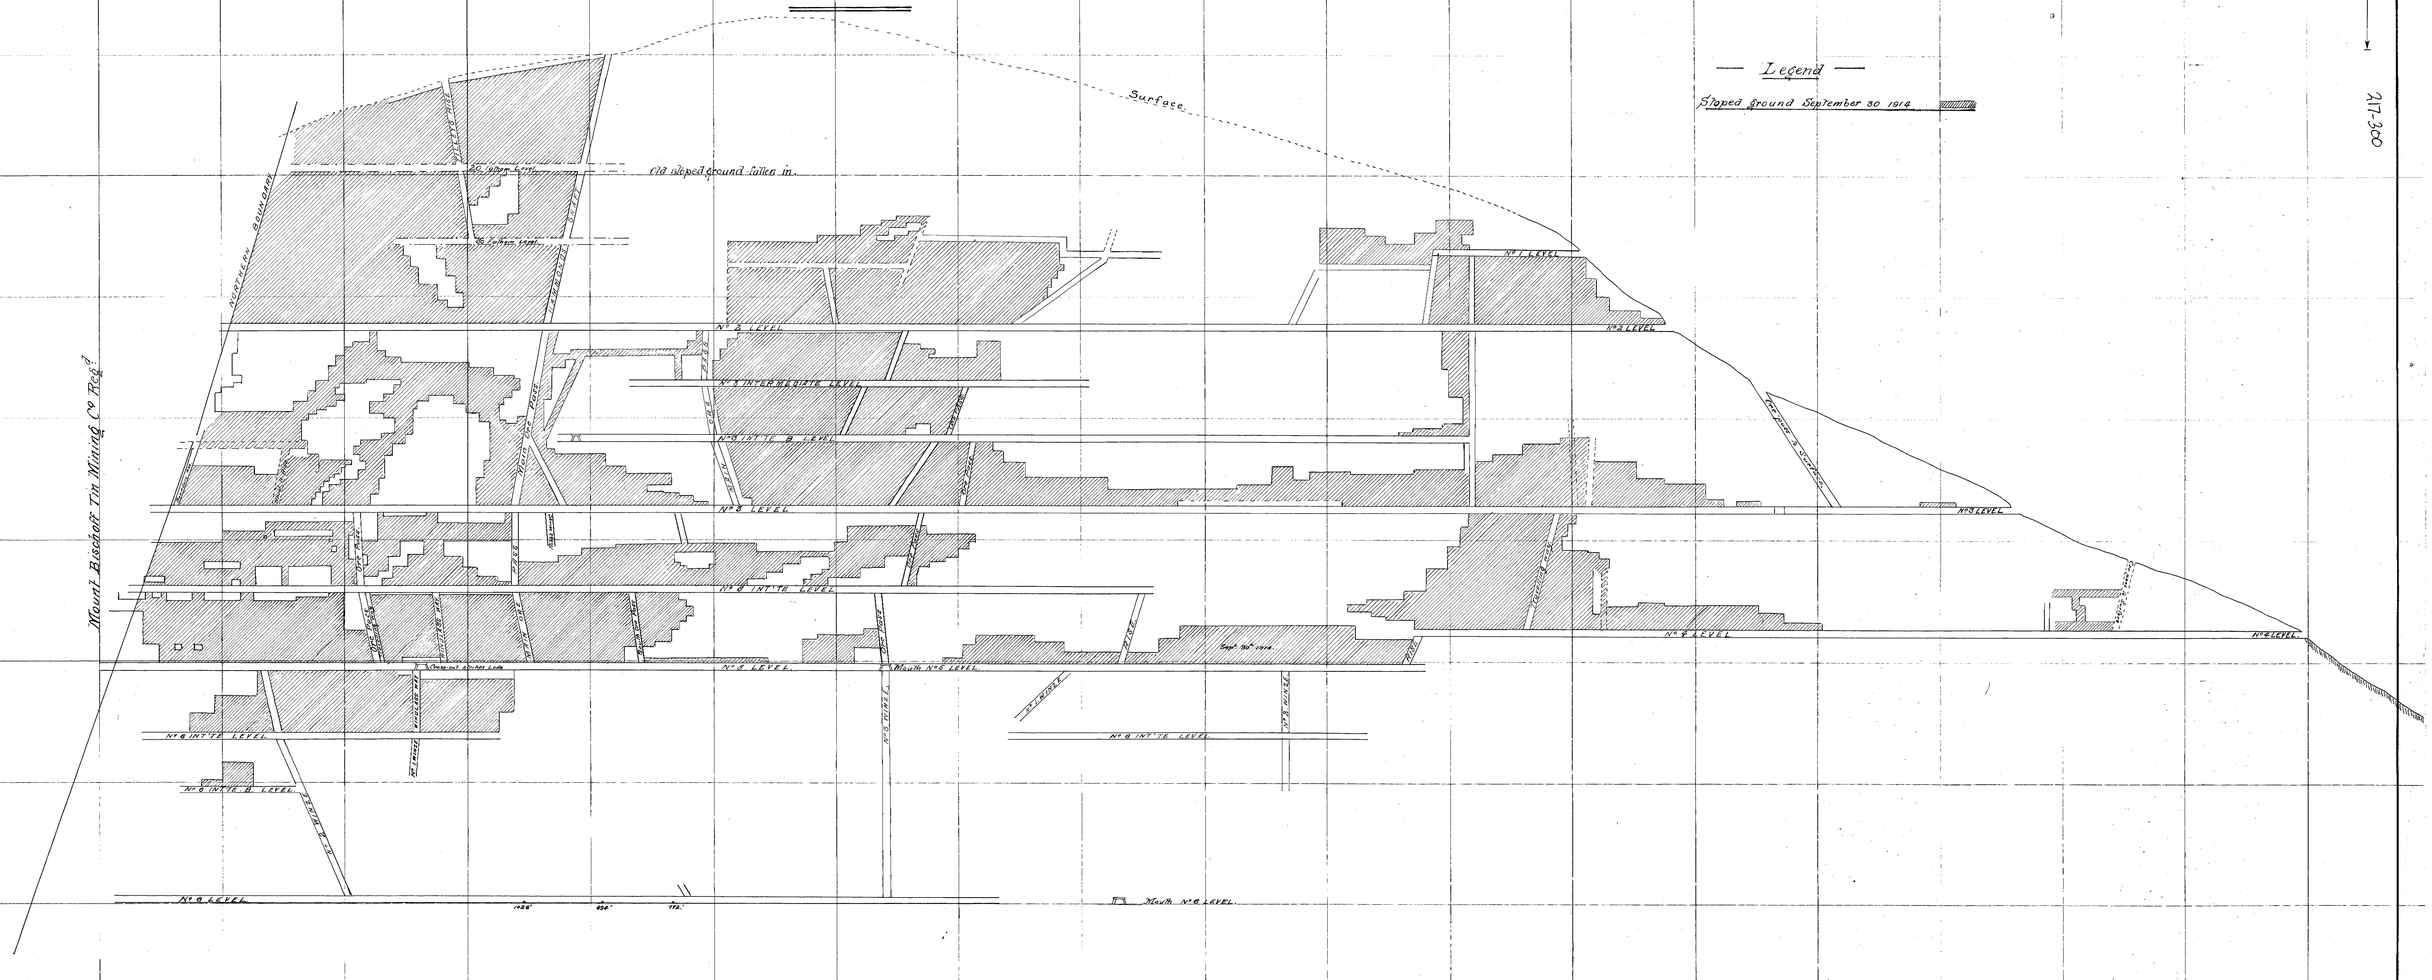

H. J. Schell. Mine Surveyor.

MOUNT BISCHOFF EXTENDED TIN MINING COMPANY
NO LIABILITY
Chas. Jeffrey
MINE MANAGER

Sept 30th 1914

217-300

217-300