Mt. BISCHOFF EXTD. TM Co NL

MINE PLAN

SCALE 50 FT. = 1 IN.

1914

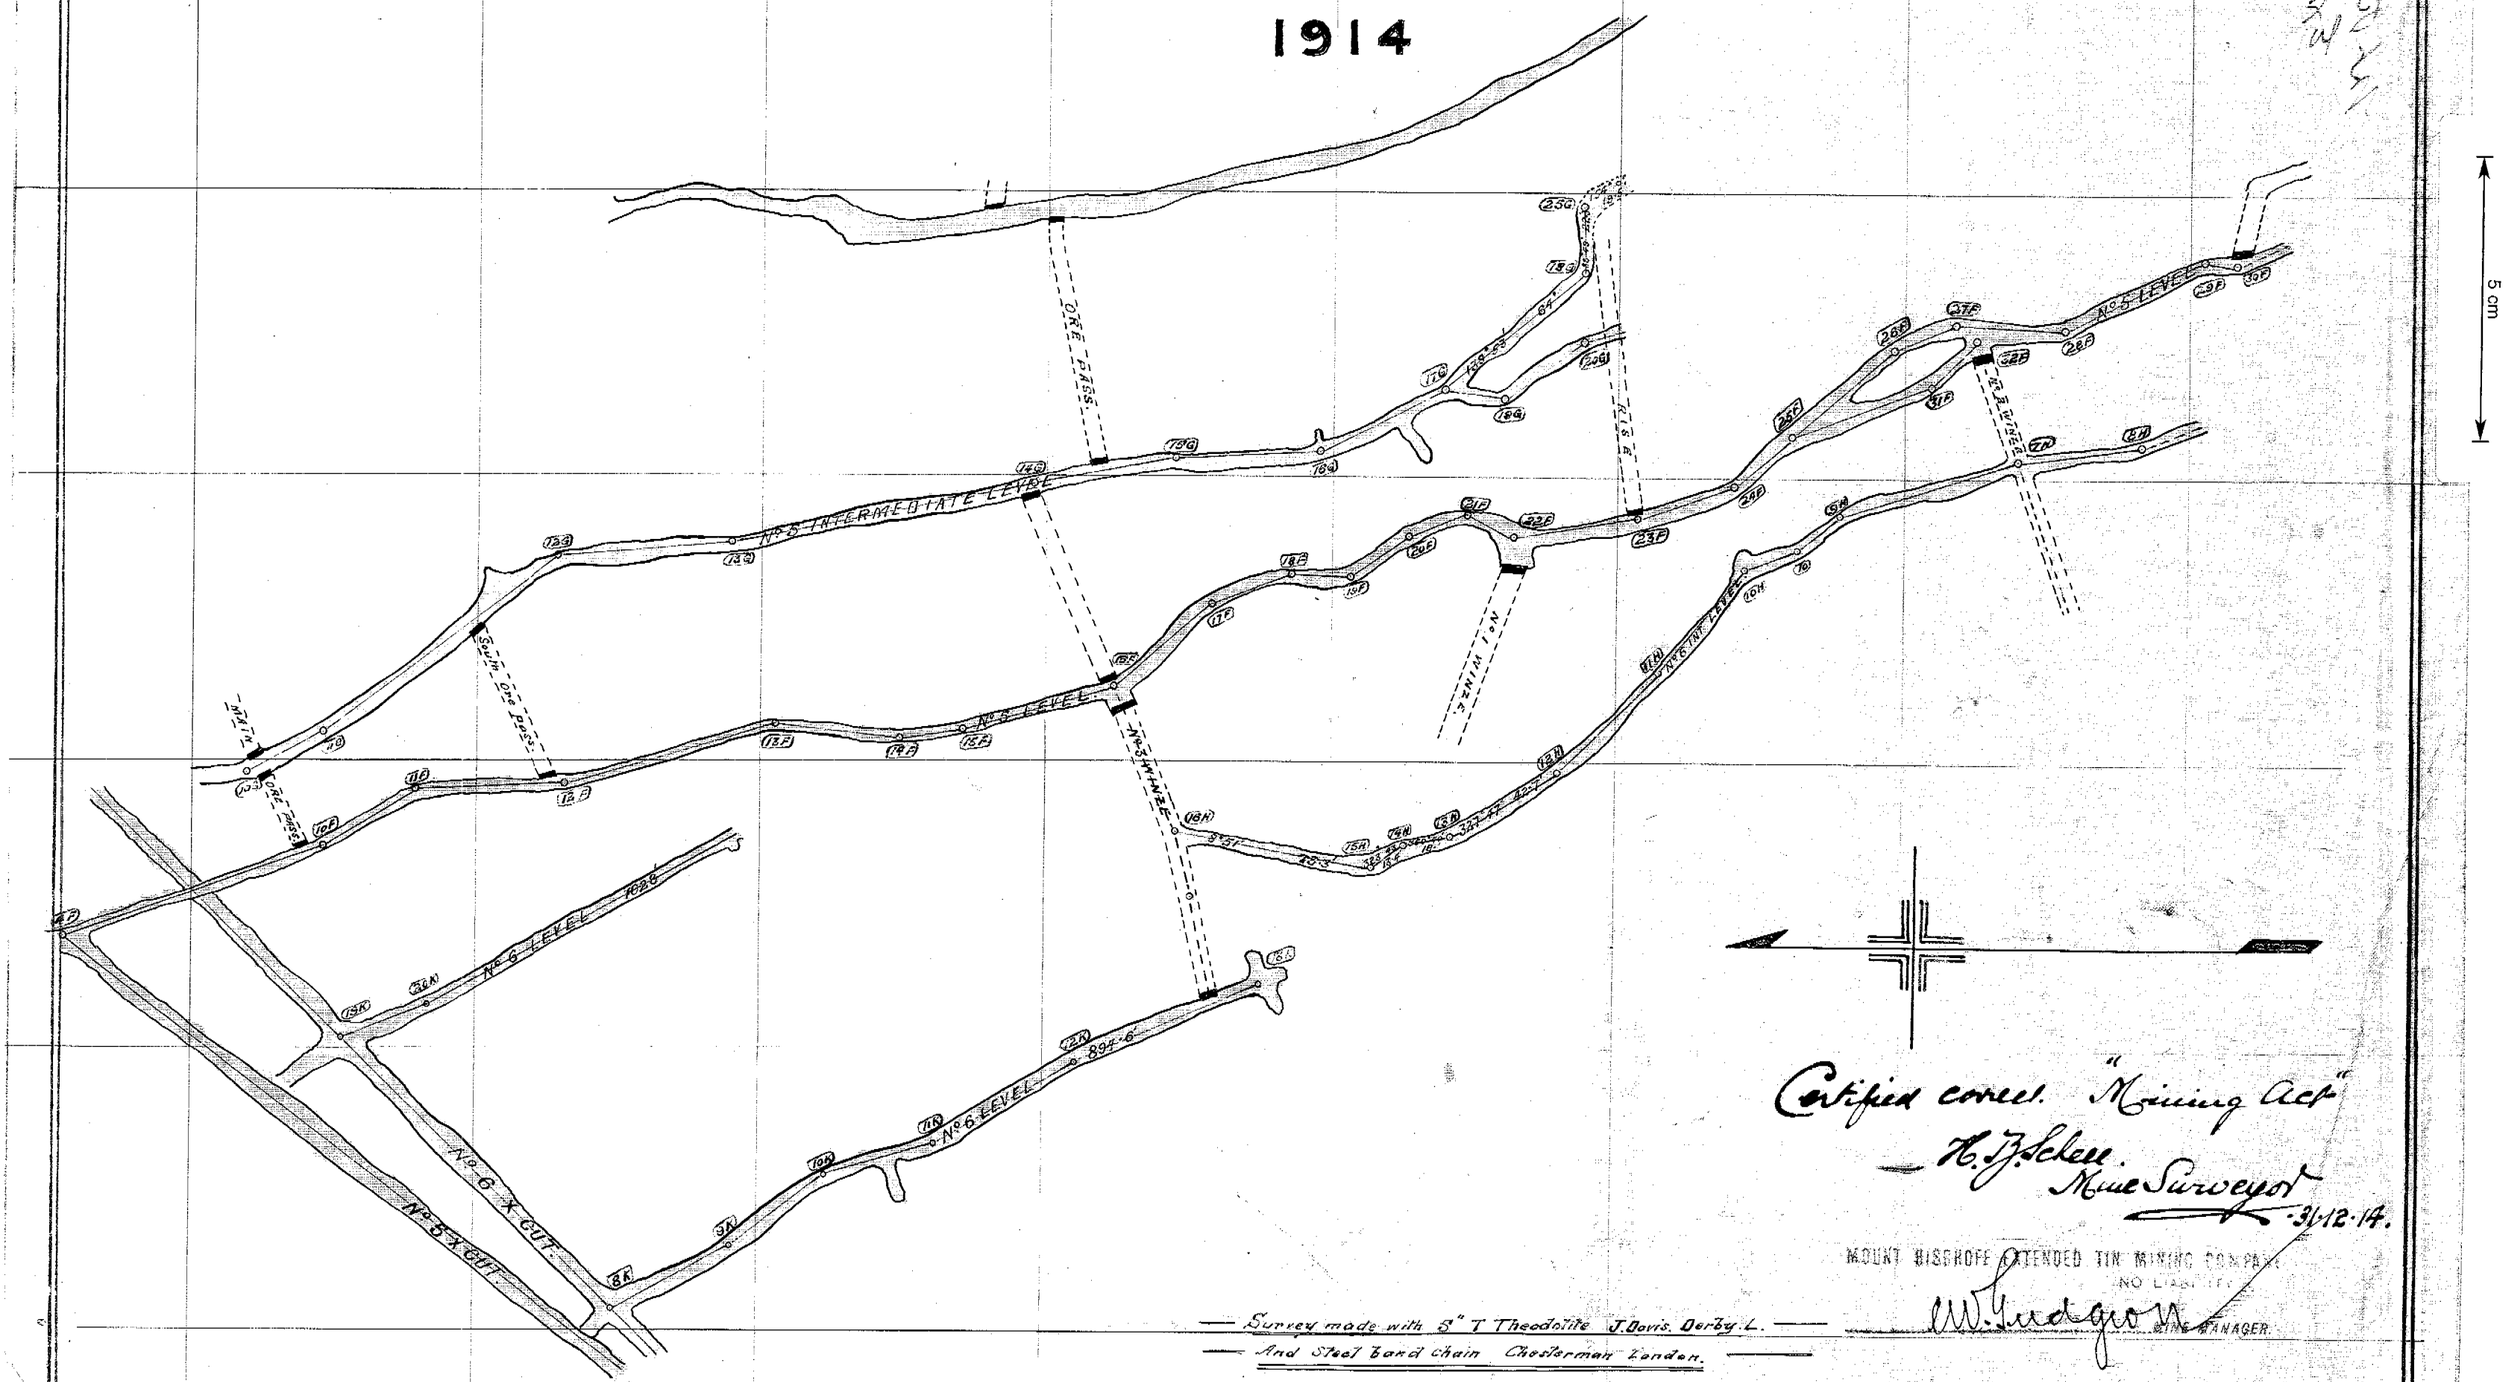

Certified correct. "Mining Act"
H. J. Scholl
Mine Surveyor
31-12-14.

MOUNT BISCHOFF EXTENDED TIN MINING COMPANY
NO LIABILITY
W. Hudgson
MINE MANAGER.

Survey made with 8" T Theodolite J. Davis. Derby L.
And Steel Band chain Chesterman London.

217-306

217-306