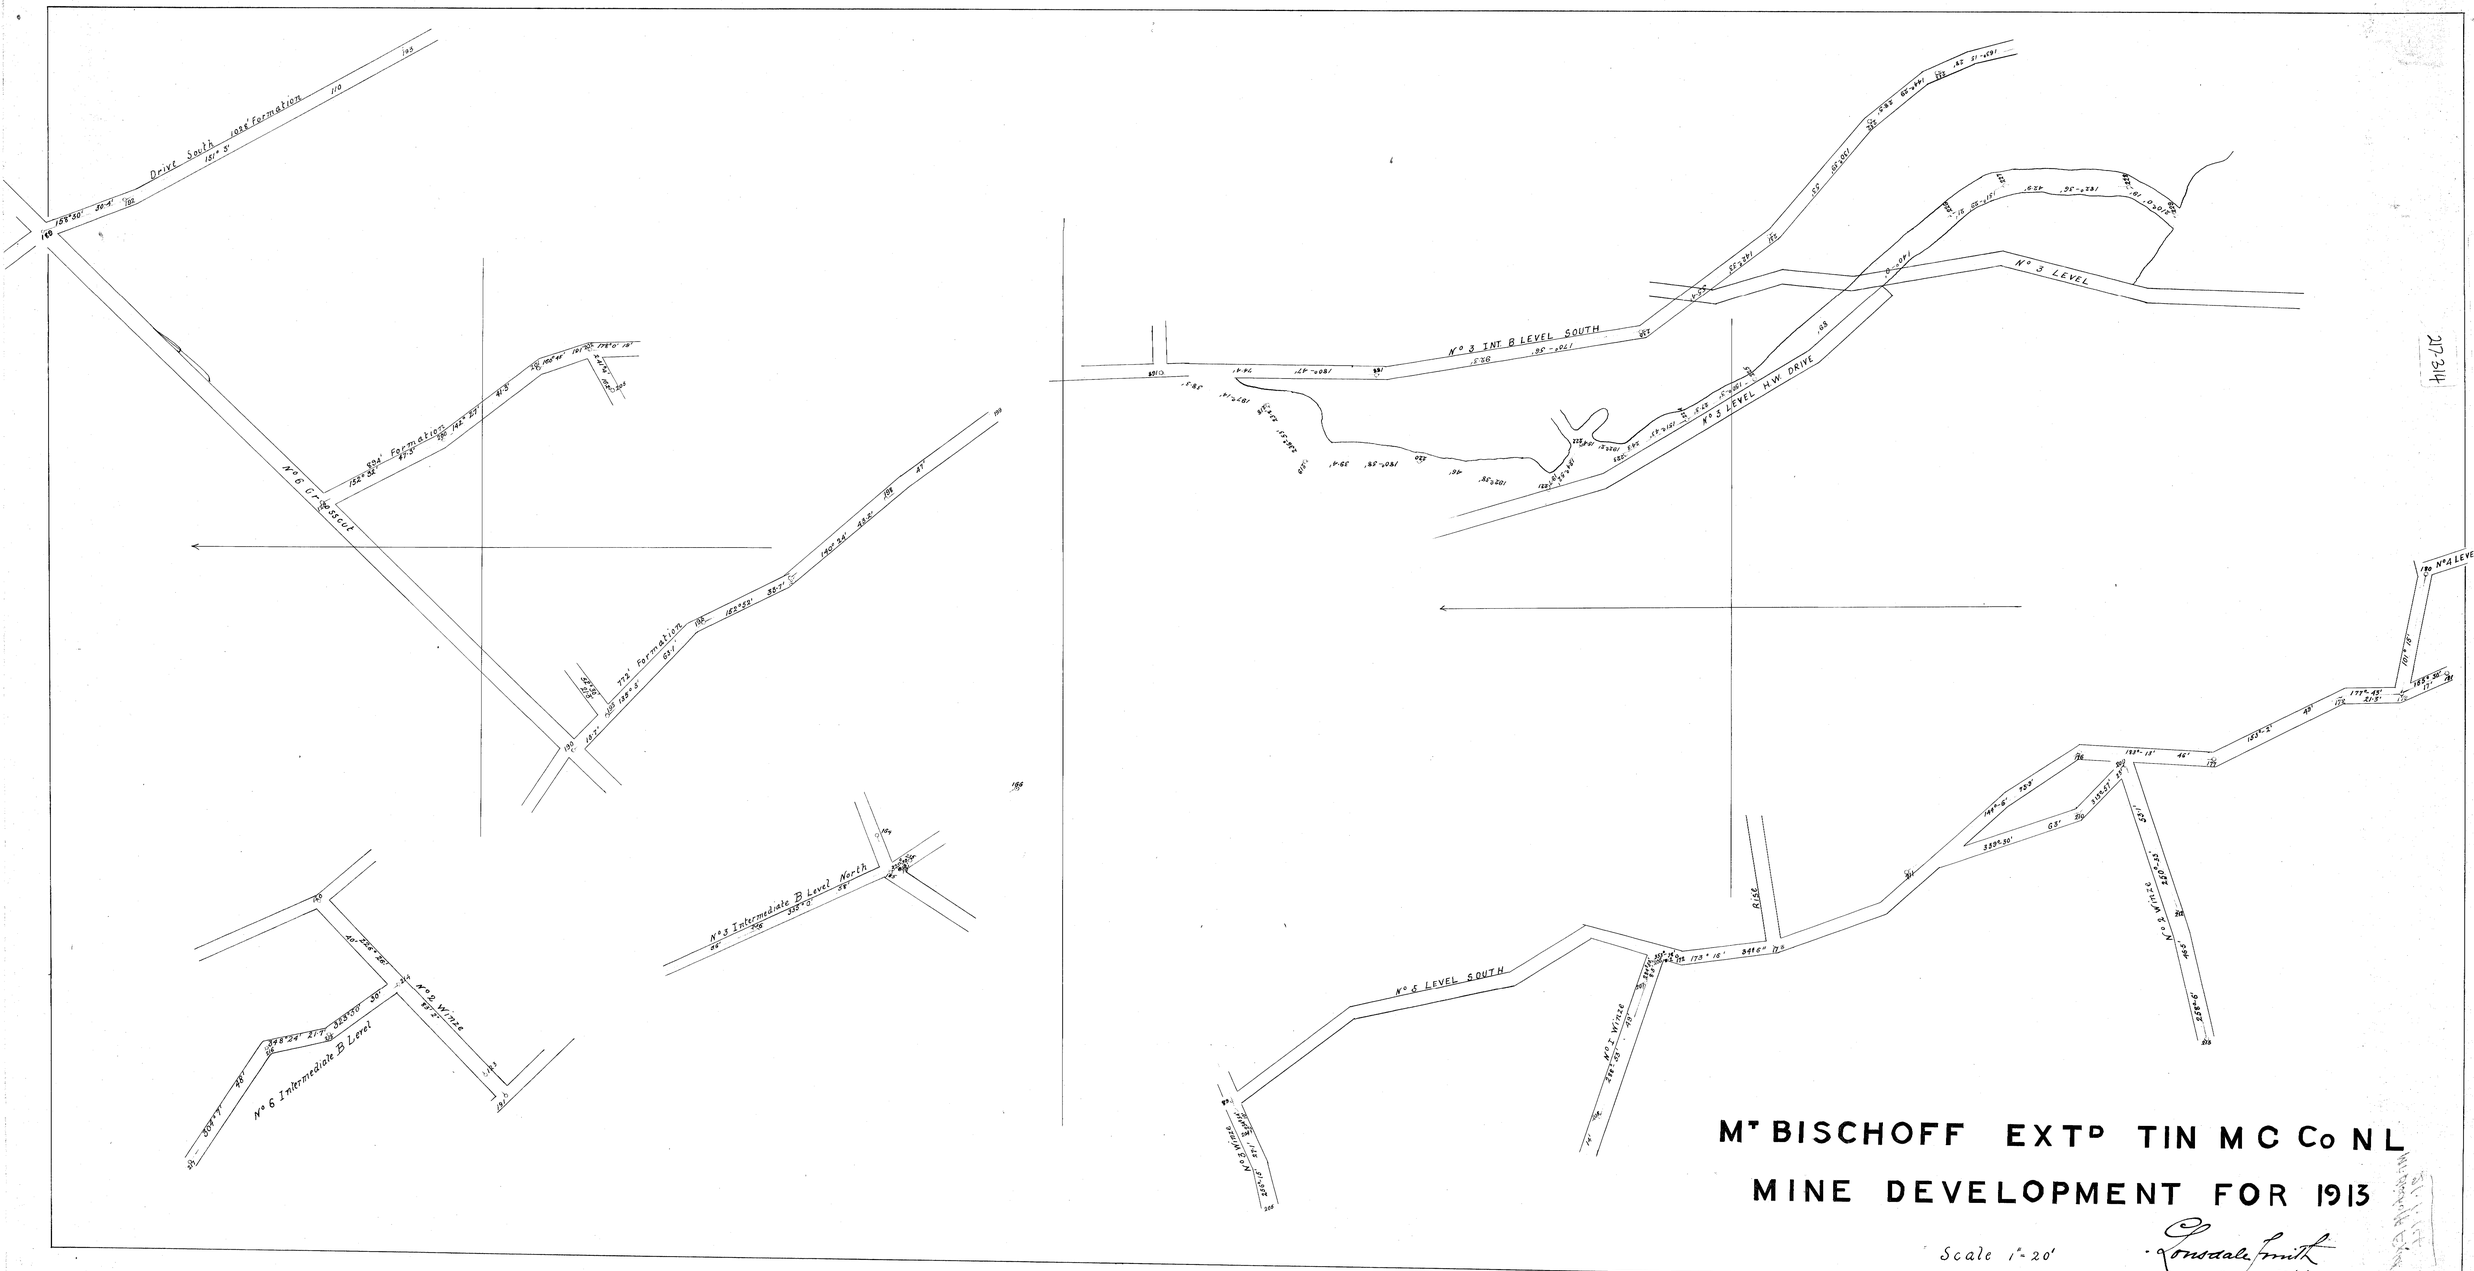

Mt BISCHOFF EXTD TIN MC Co NL

MINE DEVELOPMENT FOR 1913

Scale 1" = 20'

Lonsdale Smith
22/1/14

217-314