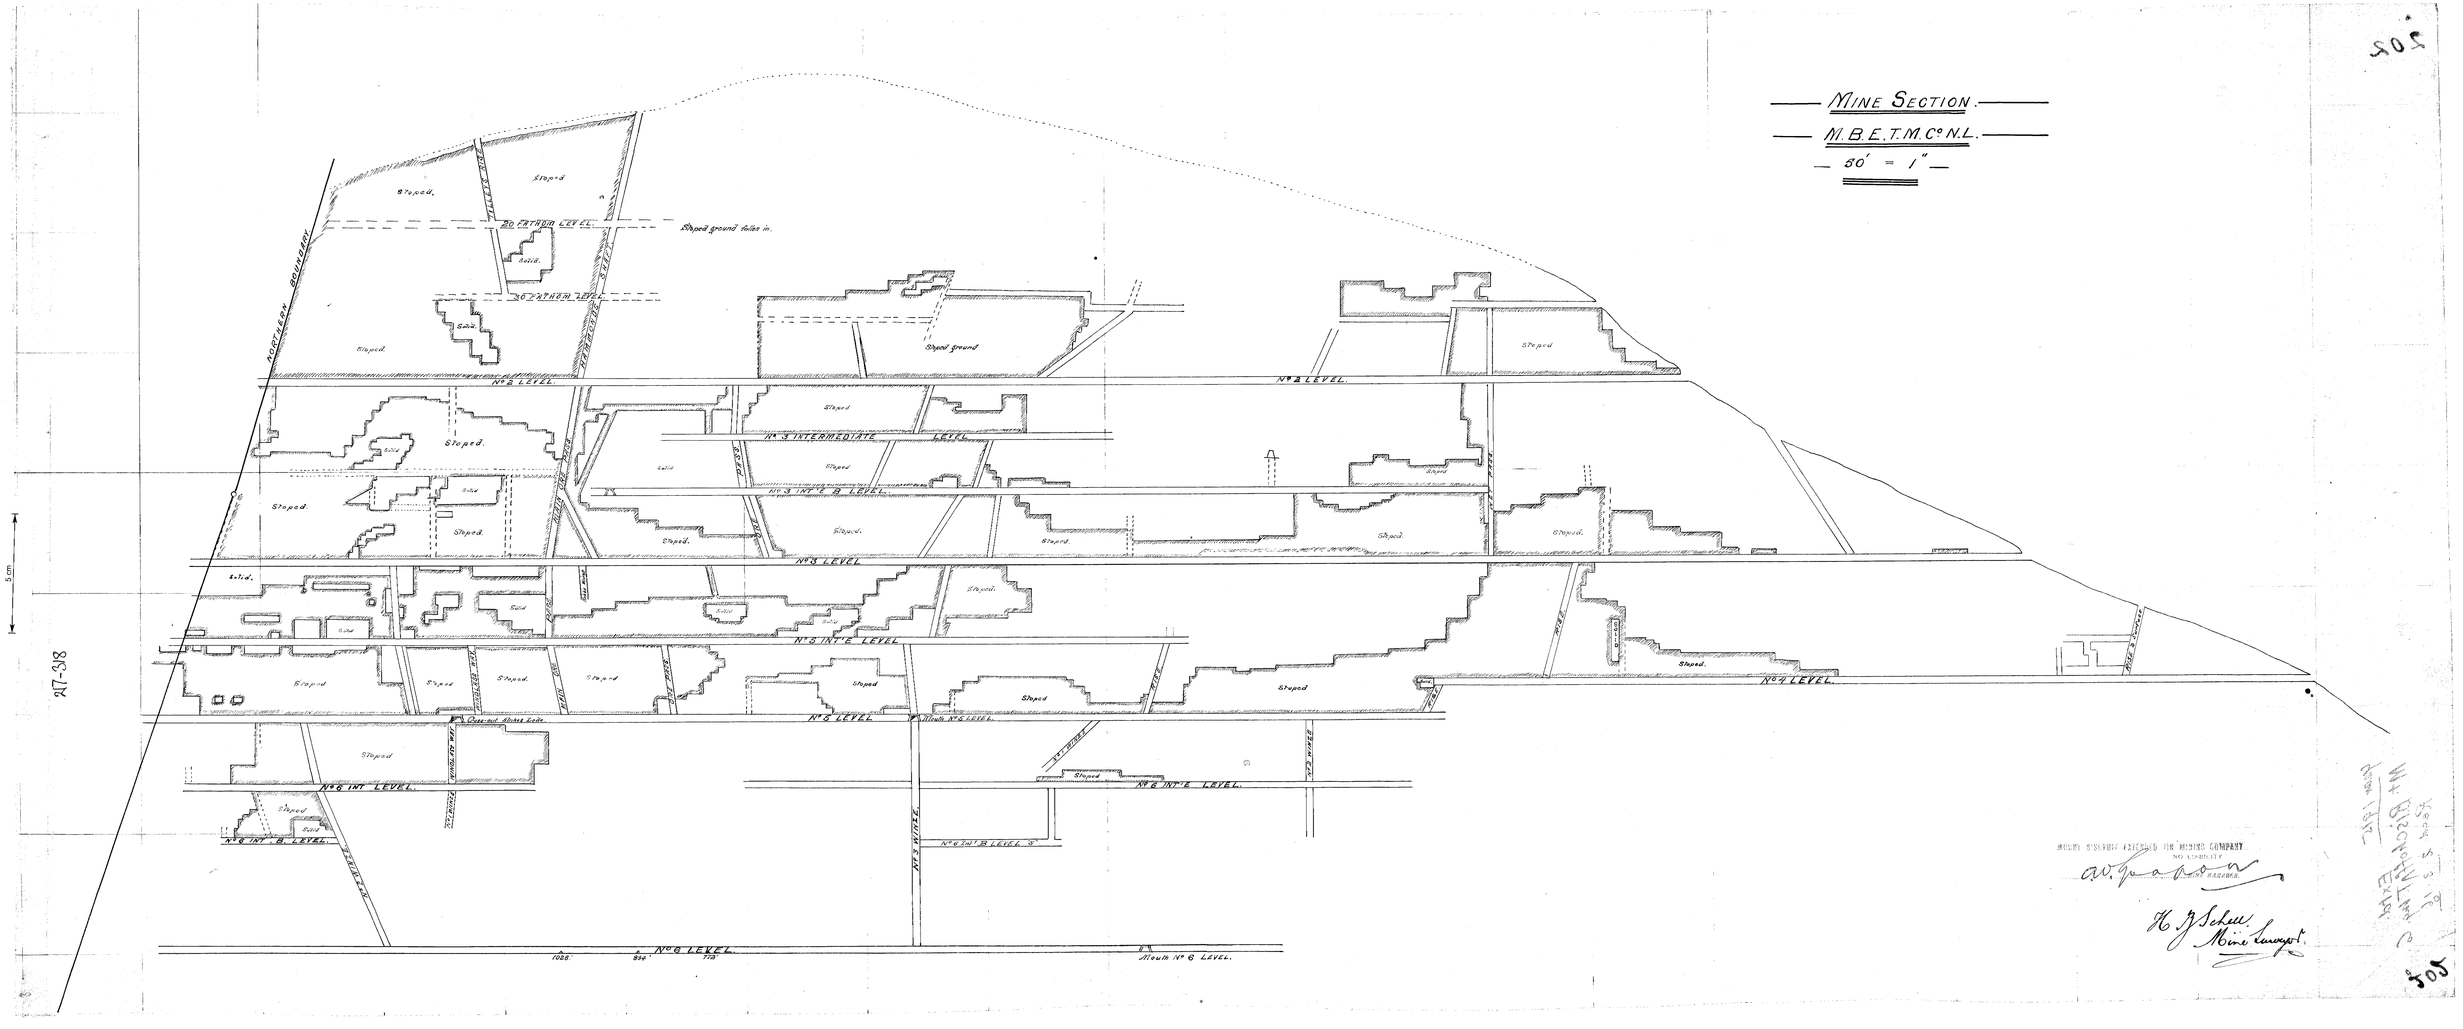
MINE SECTION.
M.B.E.T.M.Co N.L.
50' = 1"
NORTHERN BOUNDARY
20 FATHOM LEVEL
Stoped ground falls in.
10 FATHOM LEVEL
Stoped
Solid
Stoped ground
No 2 LEVEL
No 3 INTERMEDIATE LEVEL
No 3 INT'E B LEVEL
No 3 LEVEL
No 3 INT'E LEVEL
No 4 LEVEL
No 5 LEVEL
Mouth No 5 LEVEL
Cross-cut Raise Ends
No 6 INT LEVEL
No 6 INT B LEVEL
No 3 WINZE
No 6 LEVEL
Mouth No 6 LEVEL
217-318
5 cm
NO LIABILITY
A.W. Gordon
MANAGING DIRECTOR
H. G. Schell
Mine Surveyor.
