217-322

Mt BISCHOFF EXTn TIN.M.Co

LONGITUDINAL SECTION

Scale. 30 Feet to one Inch.

UNDERGROUND WORKINGS

I, David Jones, of Waratah, hereby declare that plan is sufficiently correct for the purposes of the Mines Act of 1900.

David Jones
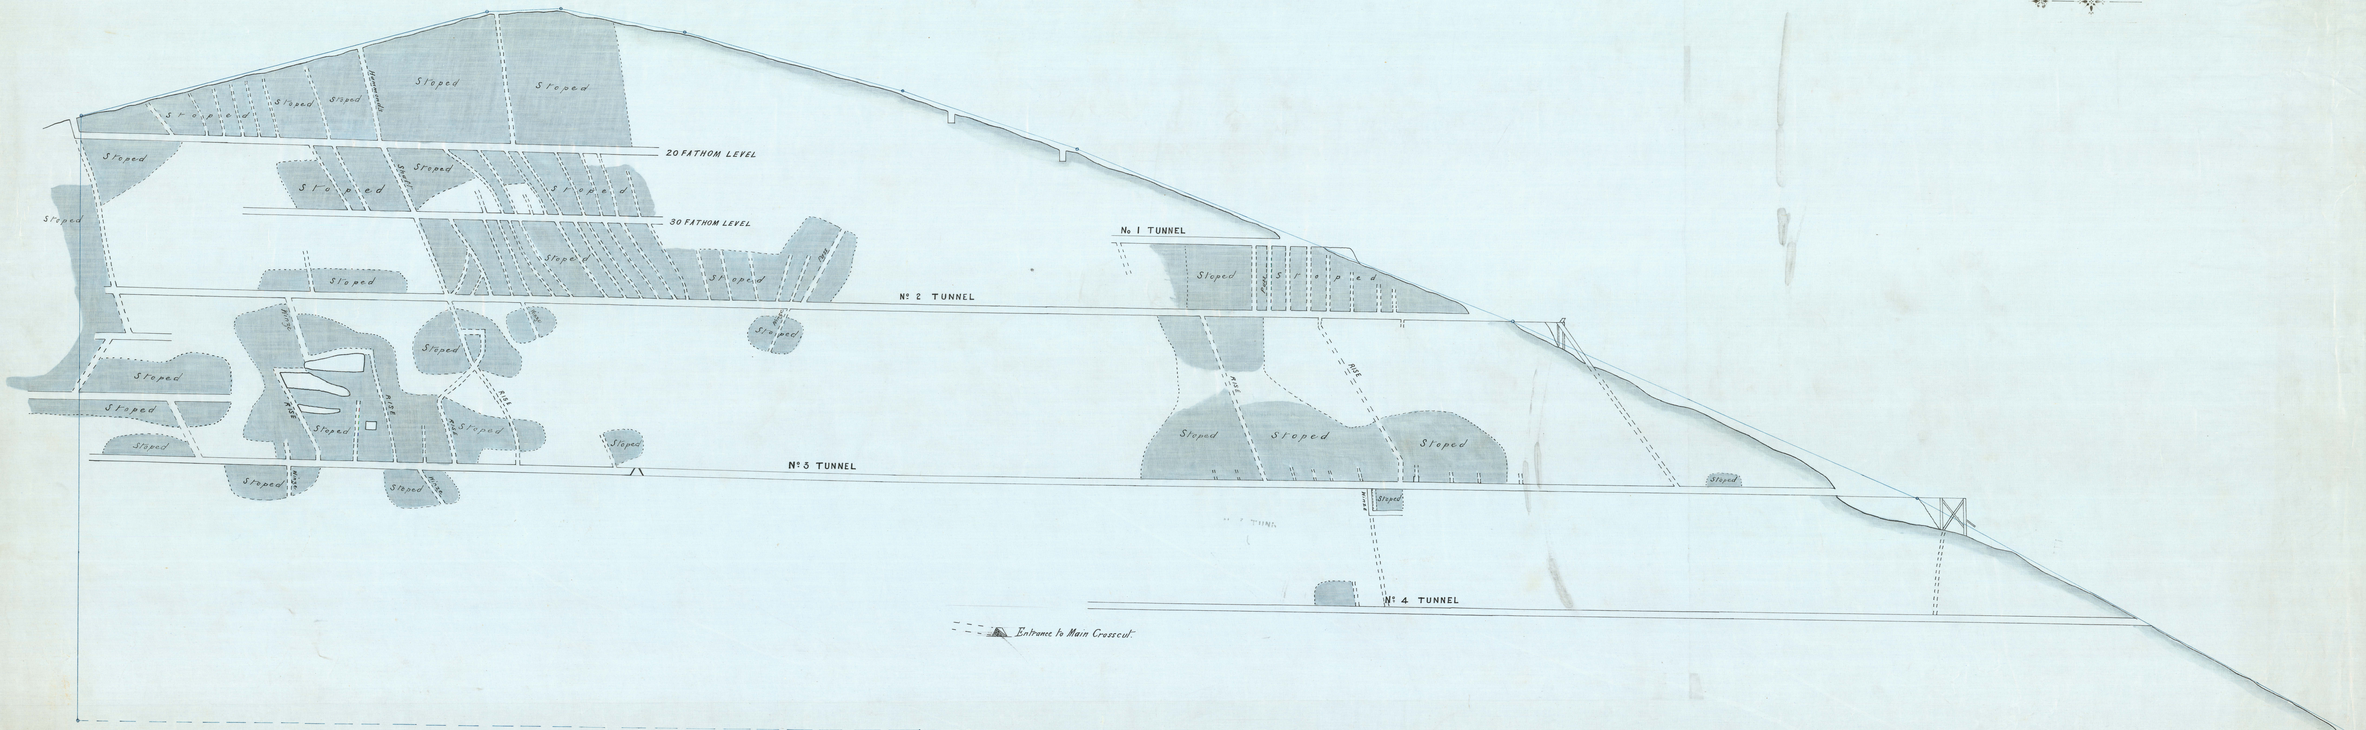
District Surveyor,
Waratah, Tas.
30-6-97.