
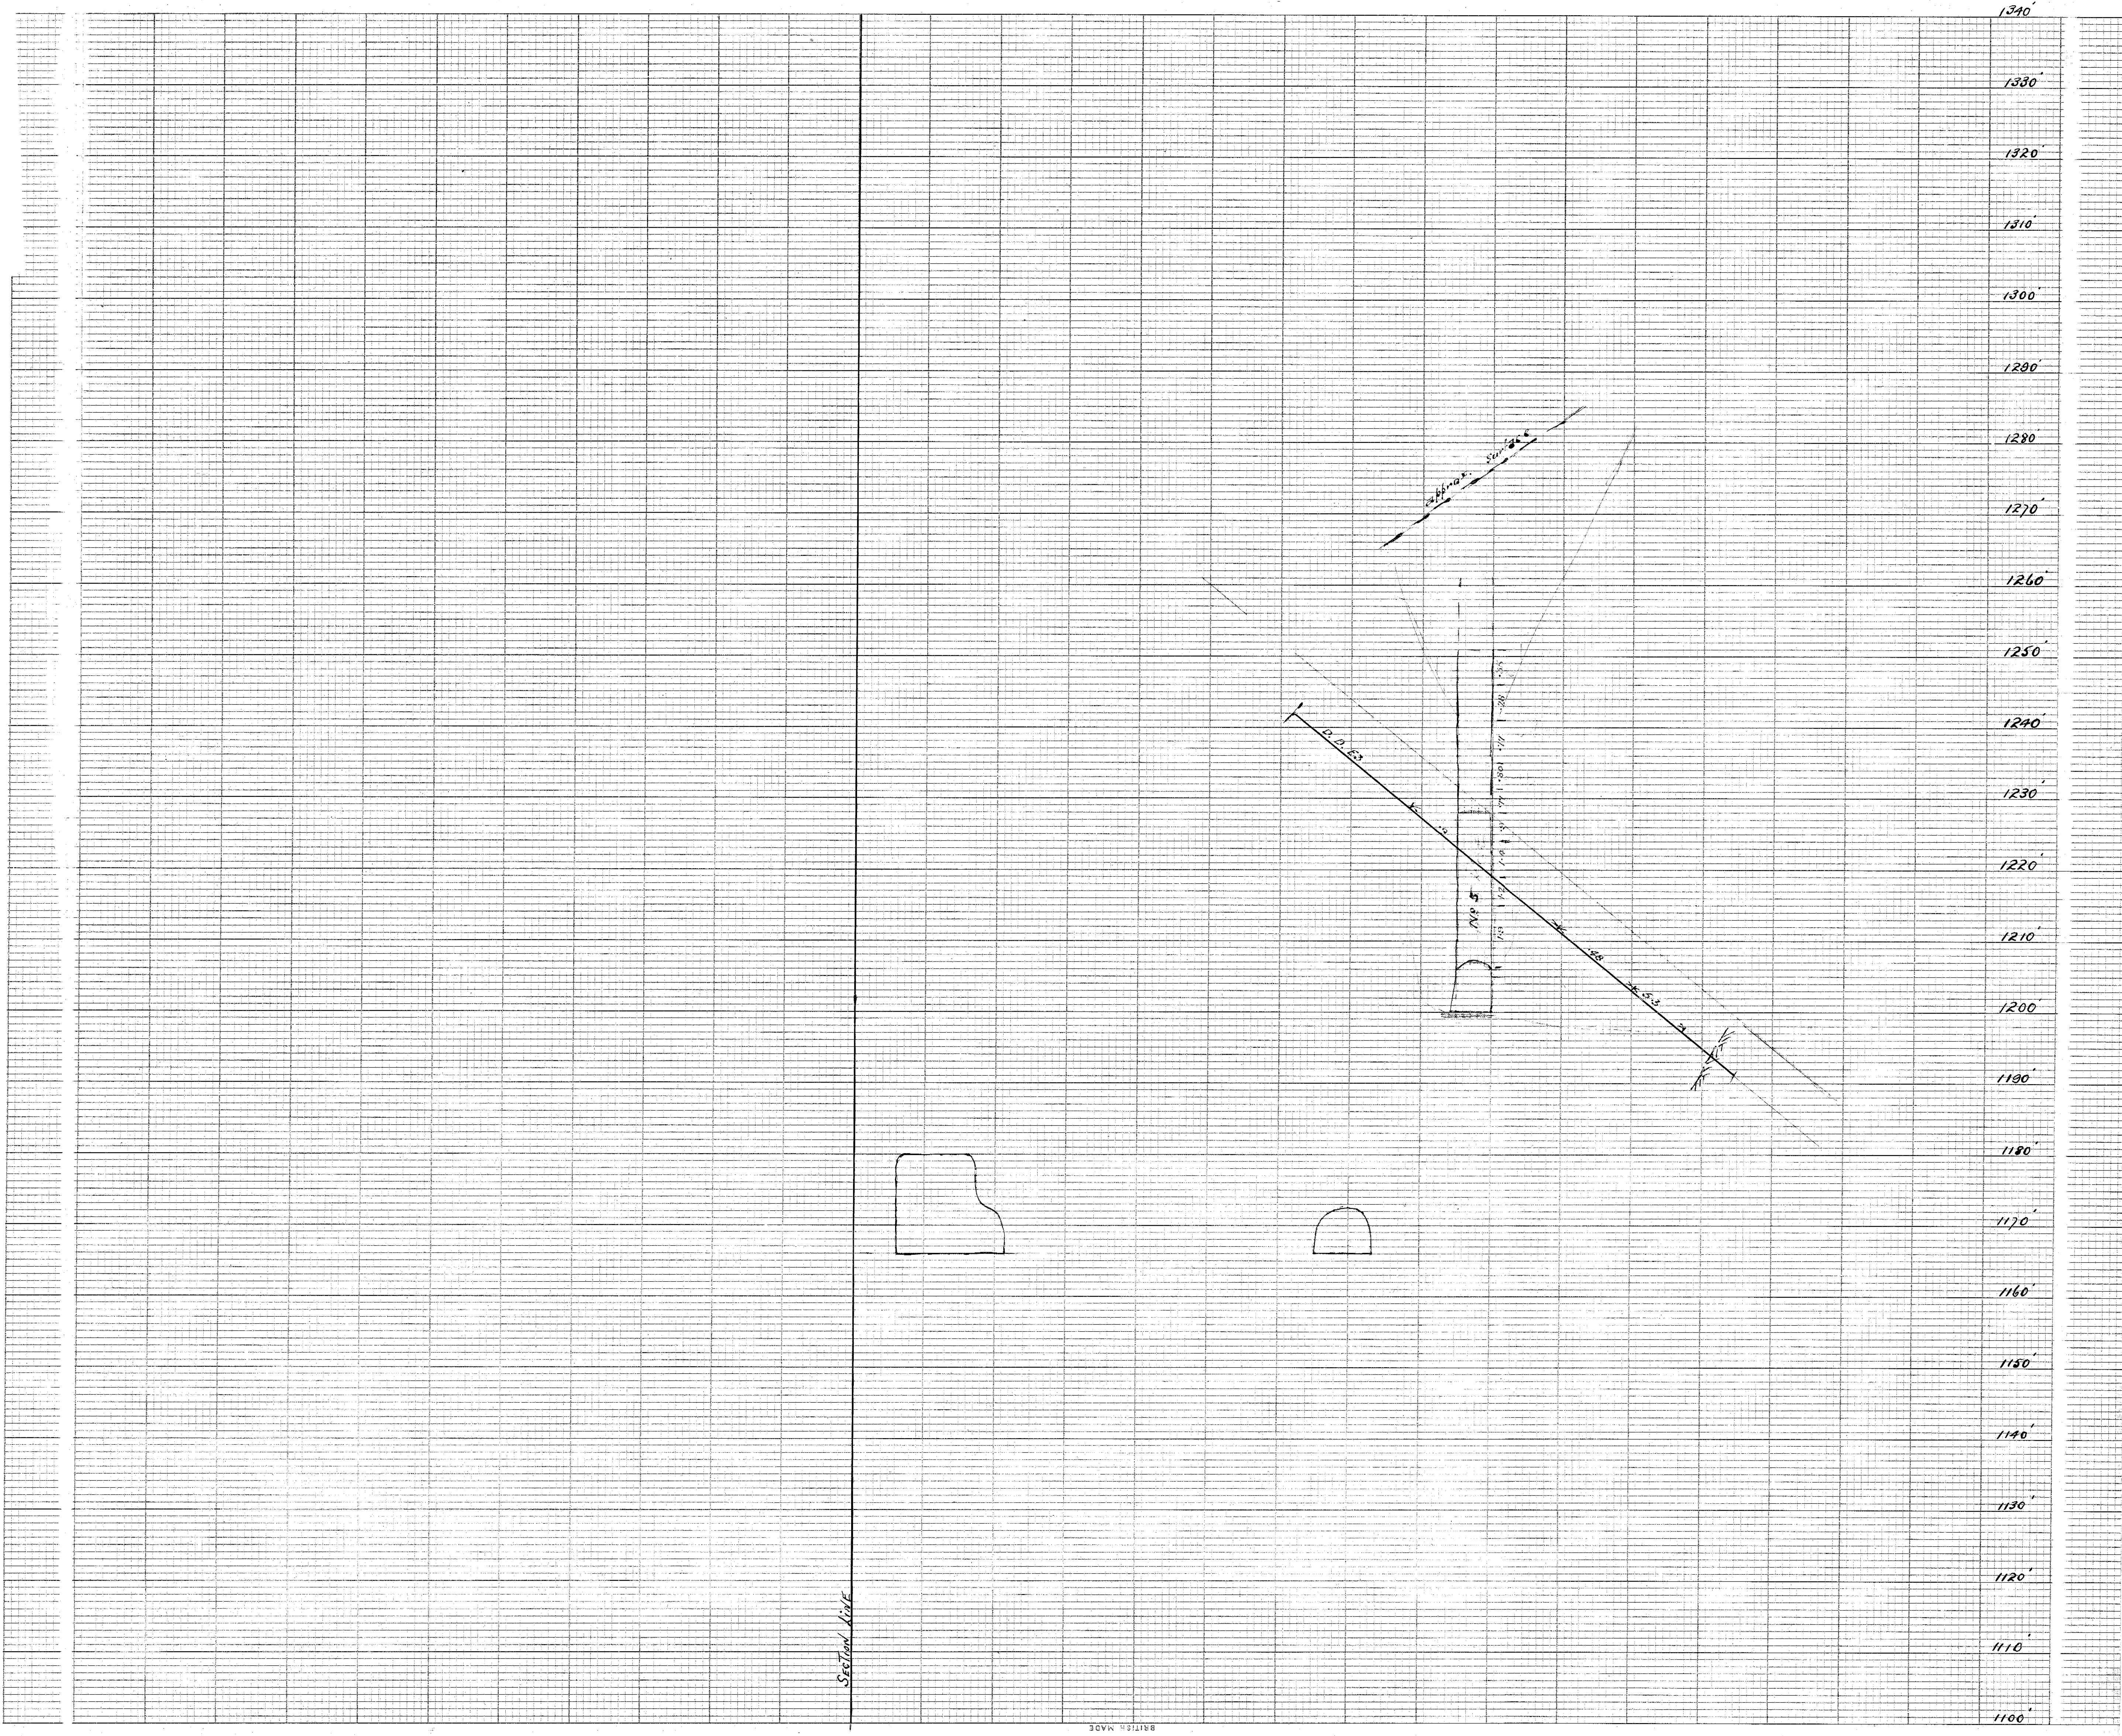


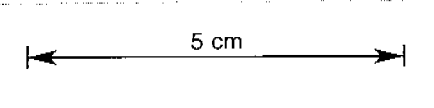

Section Line

30VX 43118

TRANSVERSE SECTION AT 710' EAST OF DATUM