


5 cm

217-344

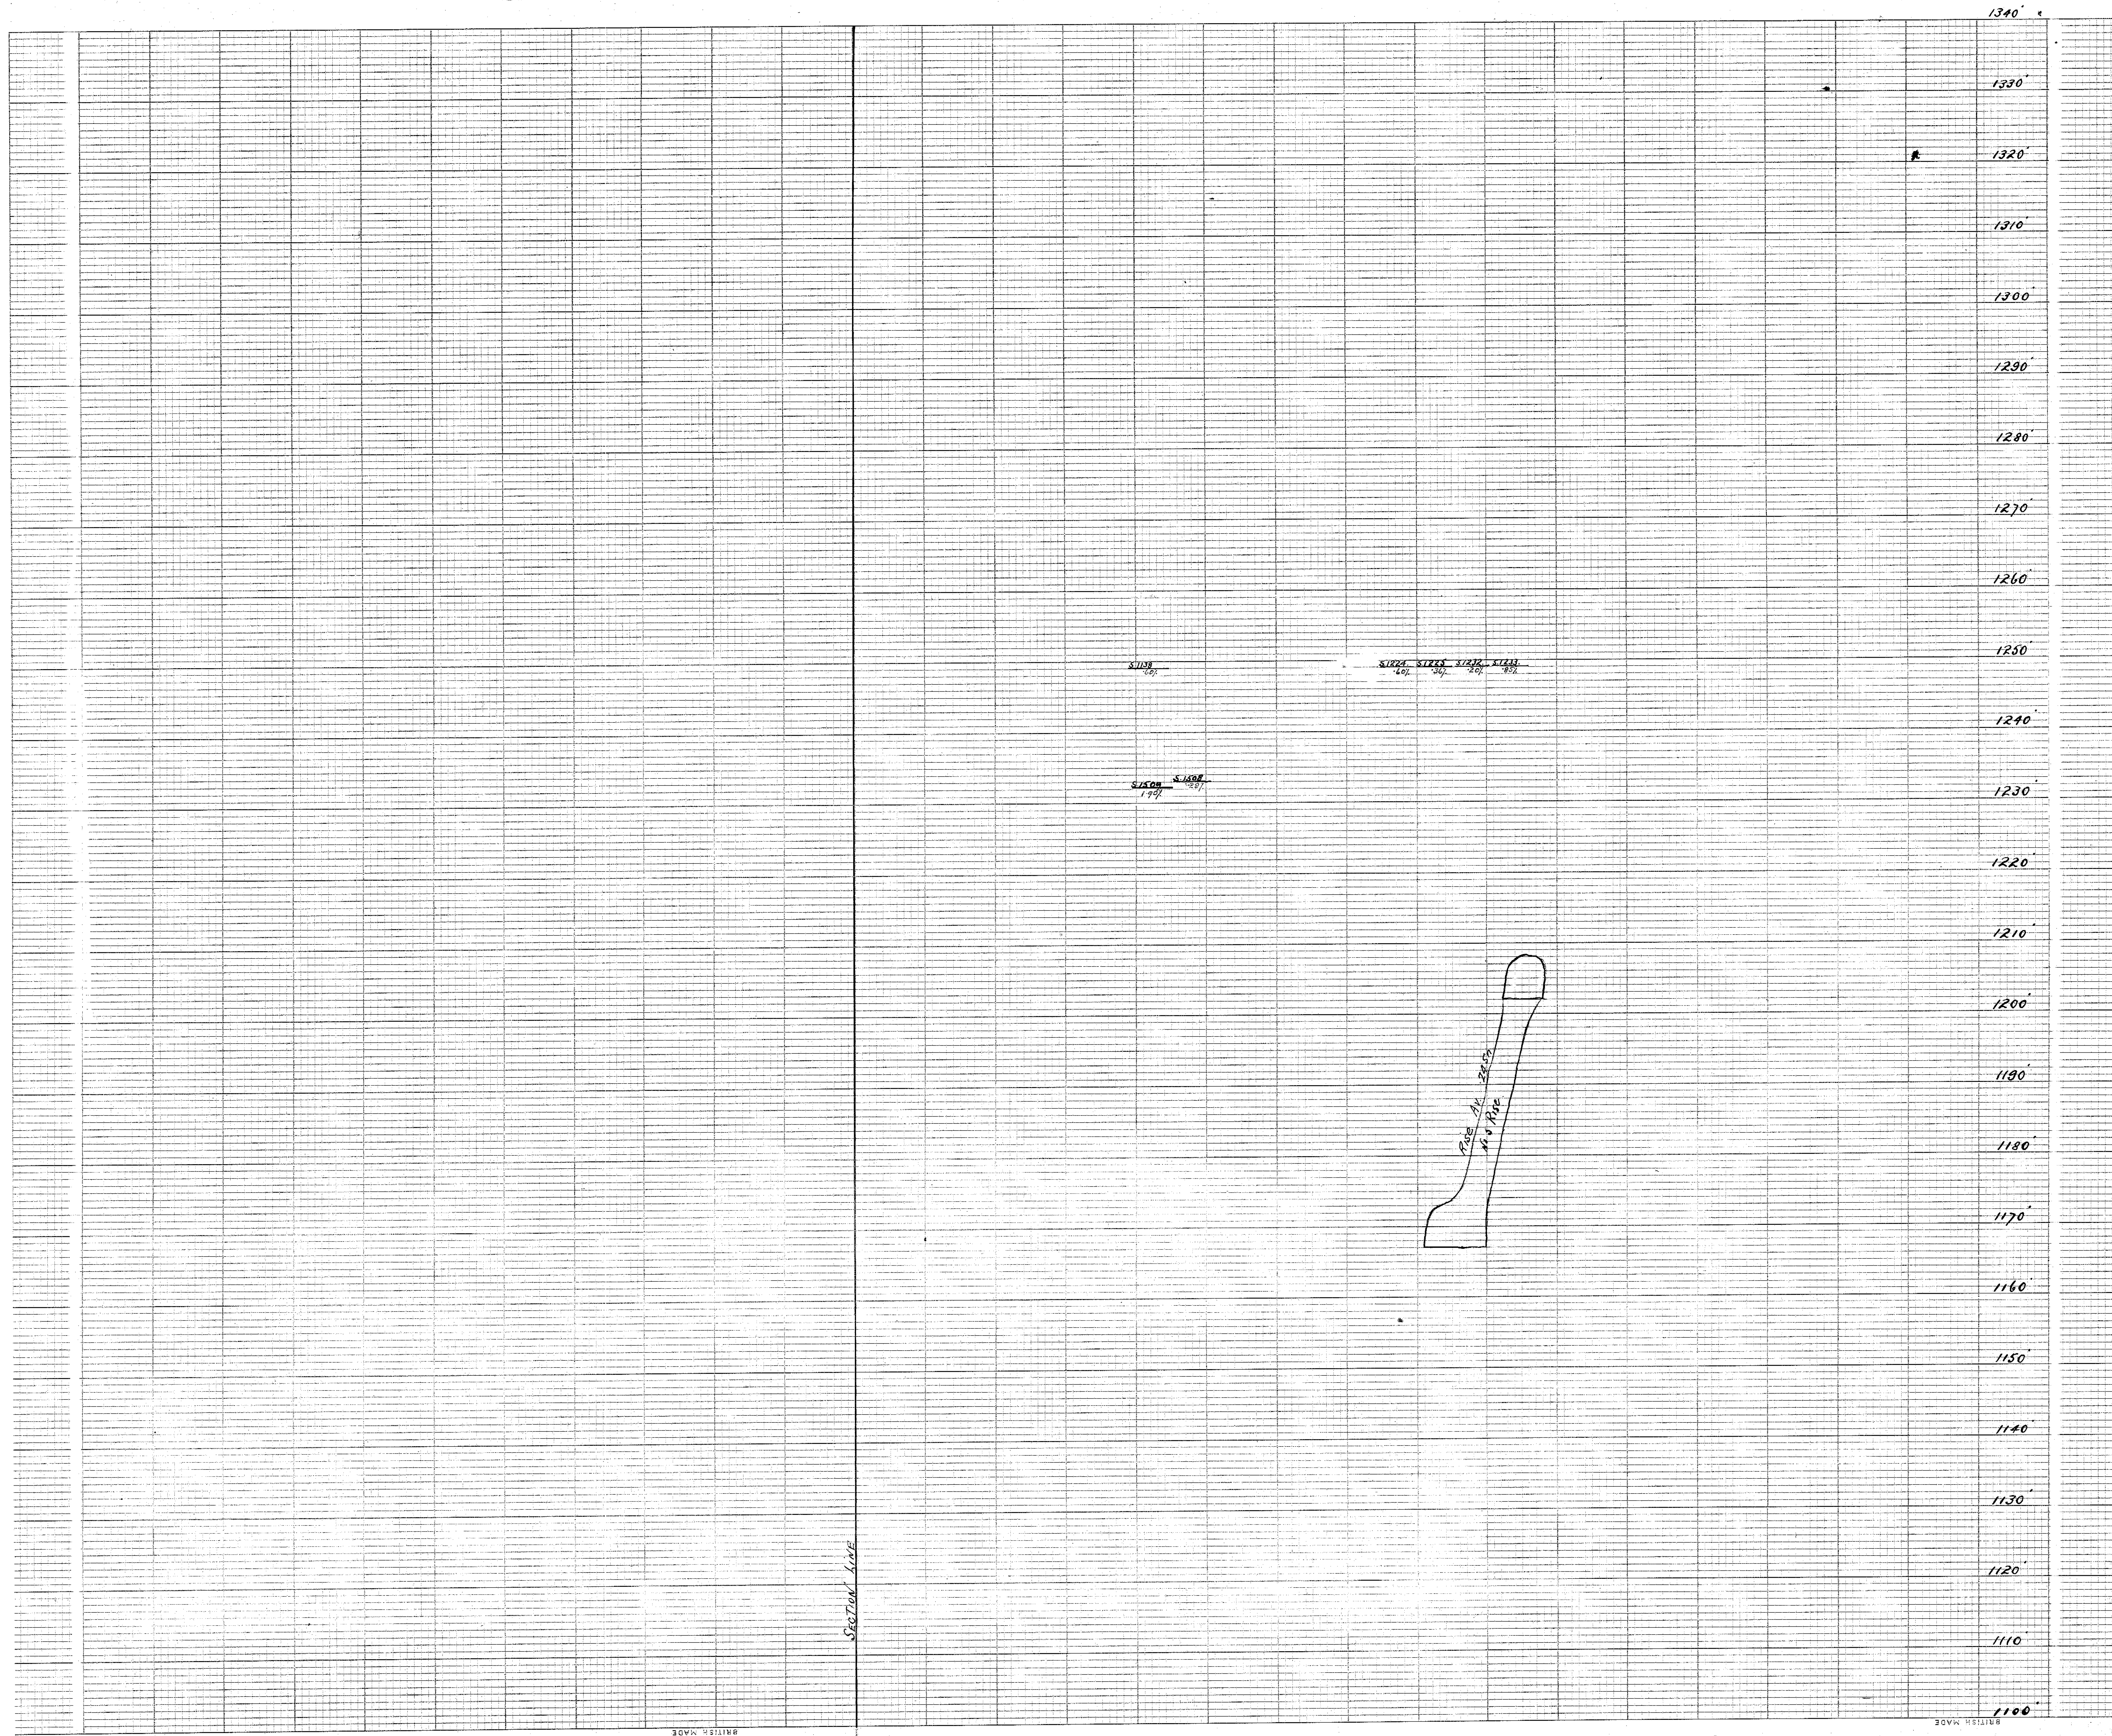

TRANSVERSE SECTION AT 370' EAST OF DATUM