
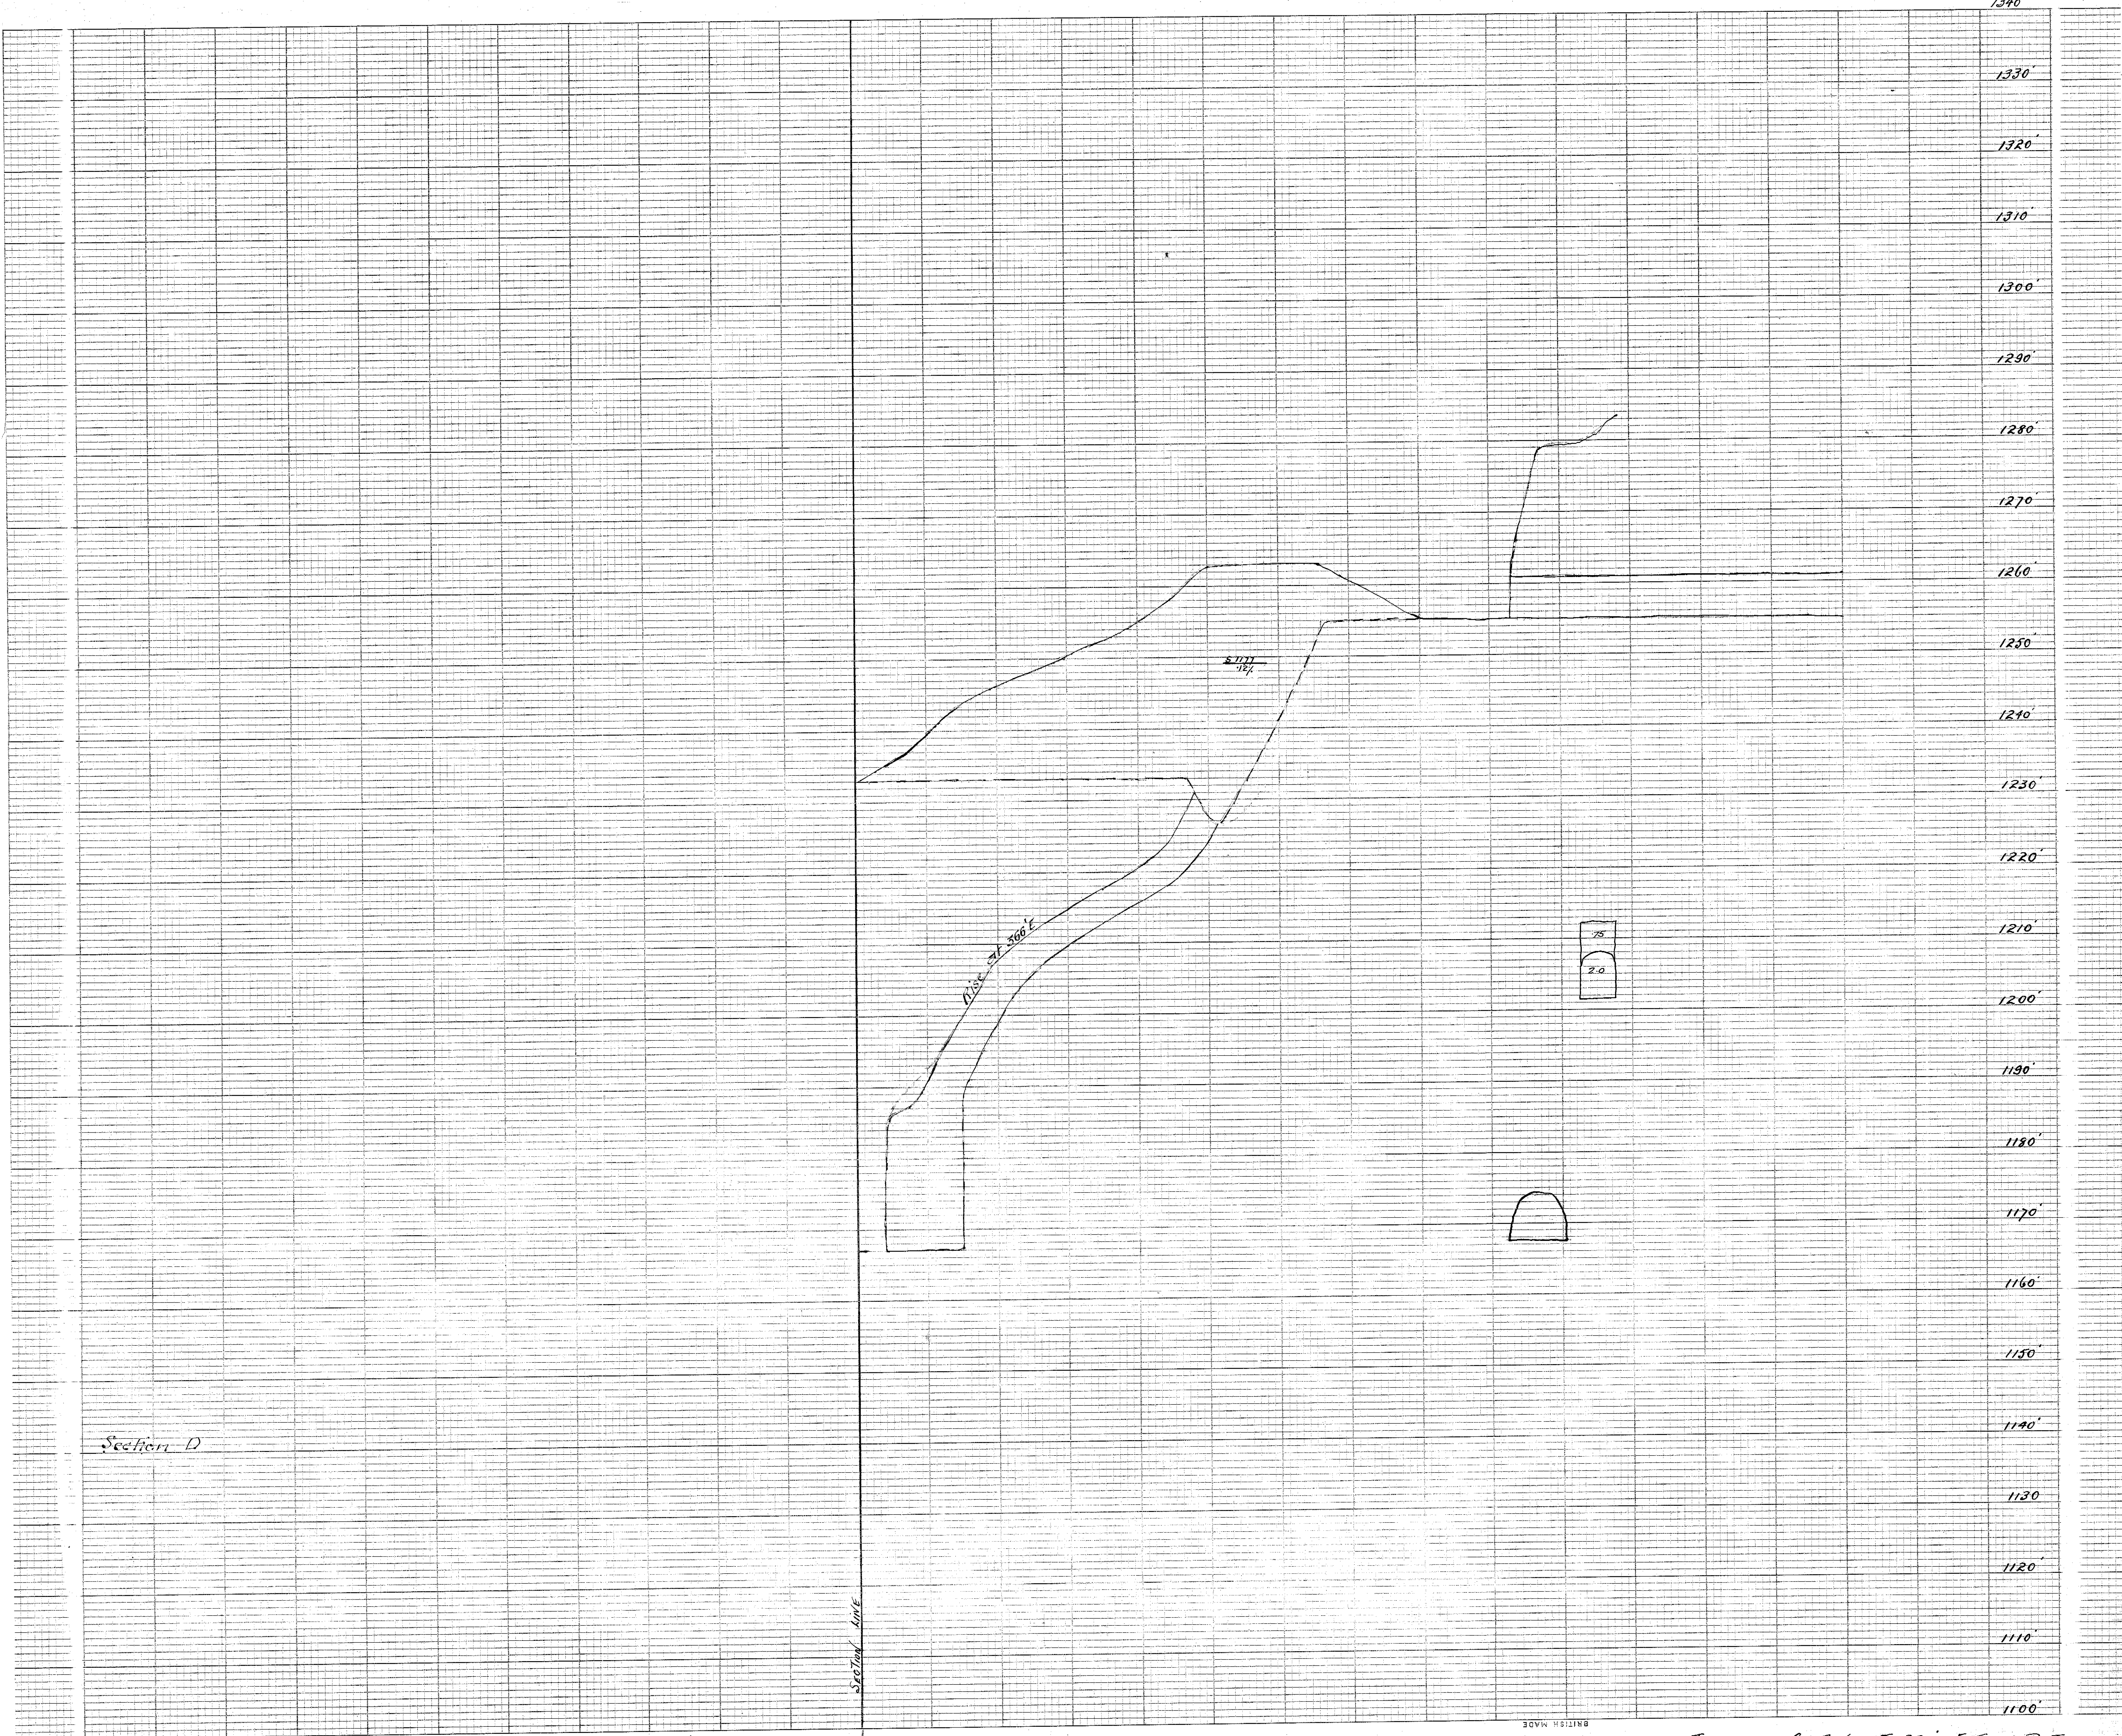


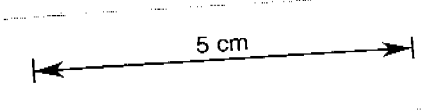

Section D

TRANSVERSE SECTION AT 350' EAST OF DATUM