


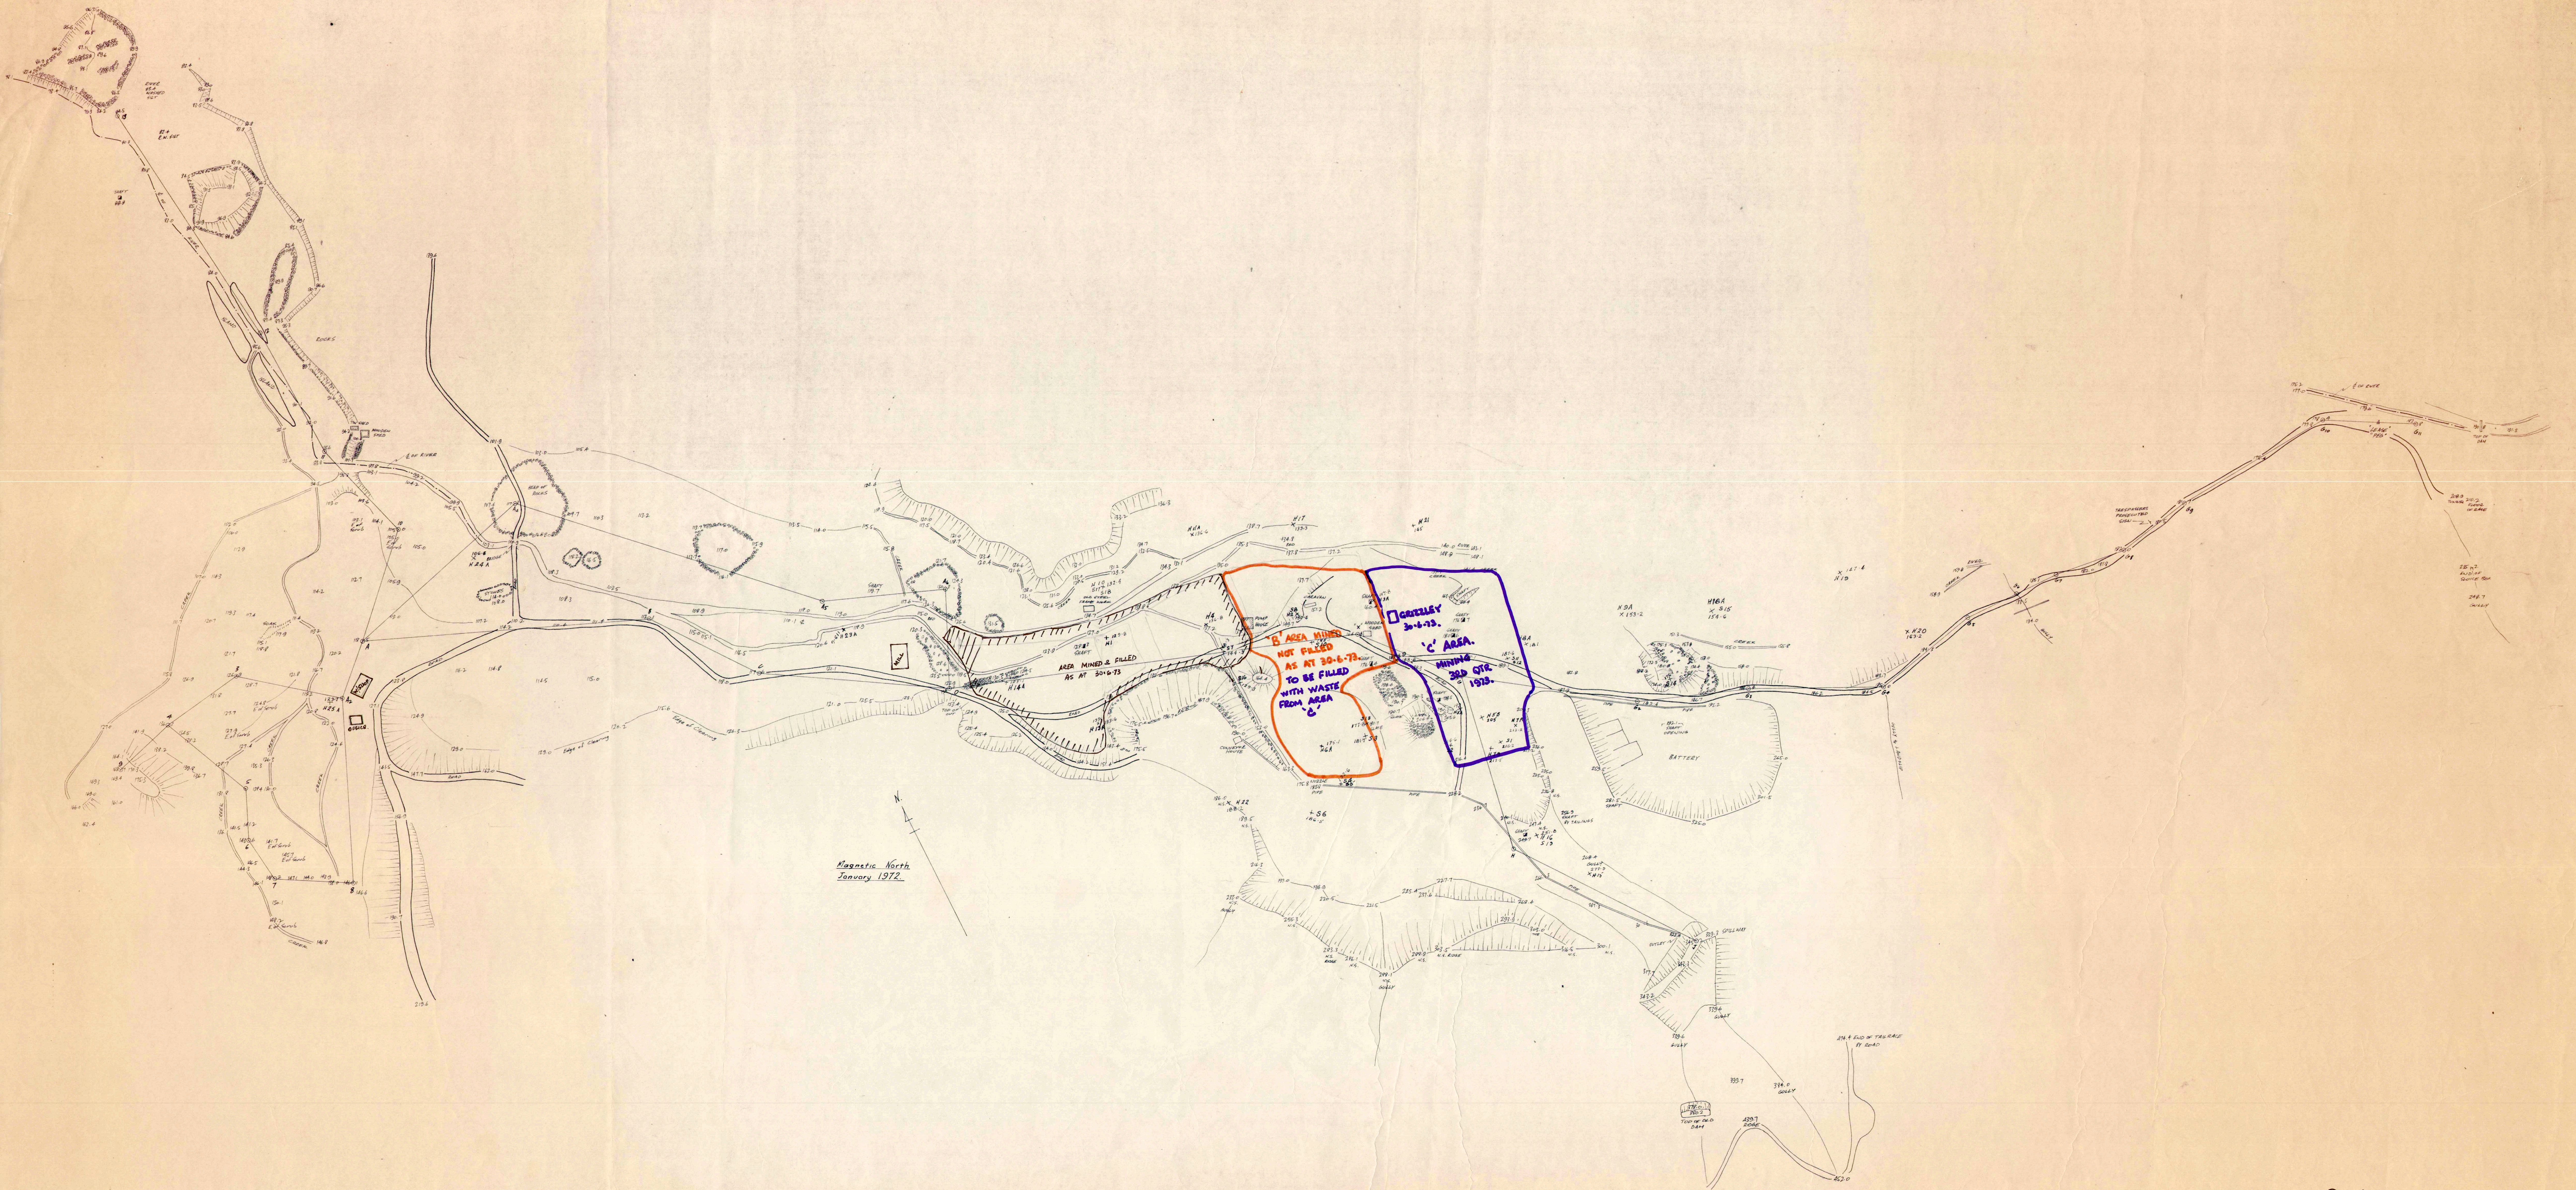

Magnetic North
January 1972

RINGAROOMA MINING PTY LTD
NORTH VALLEY - WARATAH.
MINING PROGRAMME - 3RD QTR 1973

50m