Mt. Lyell Mining and Railway Coy. Limited

Section thro' Pyrites Body on line C/D (vide Plan

With Projected Section of Workings

Scale 40 ft to an Inch

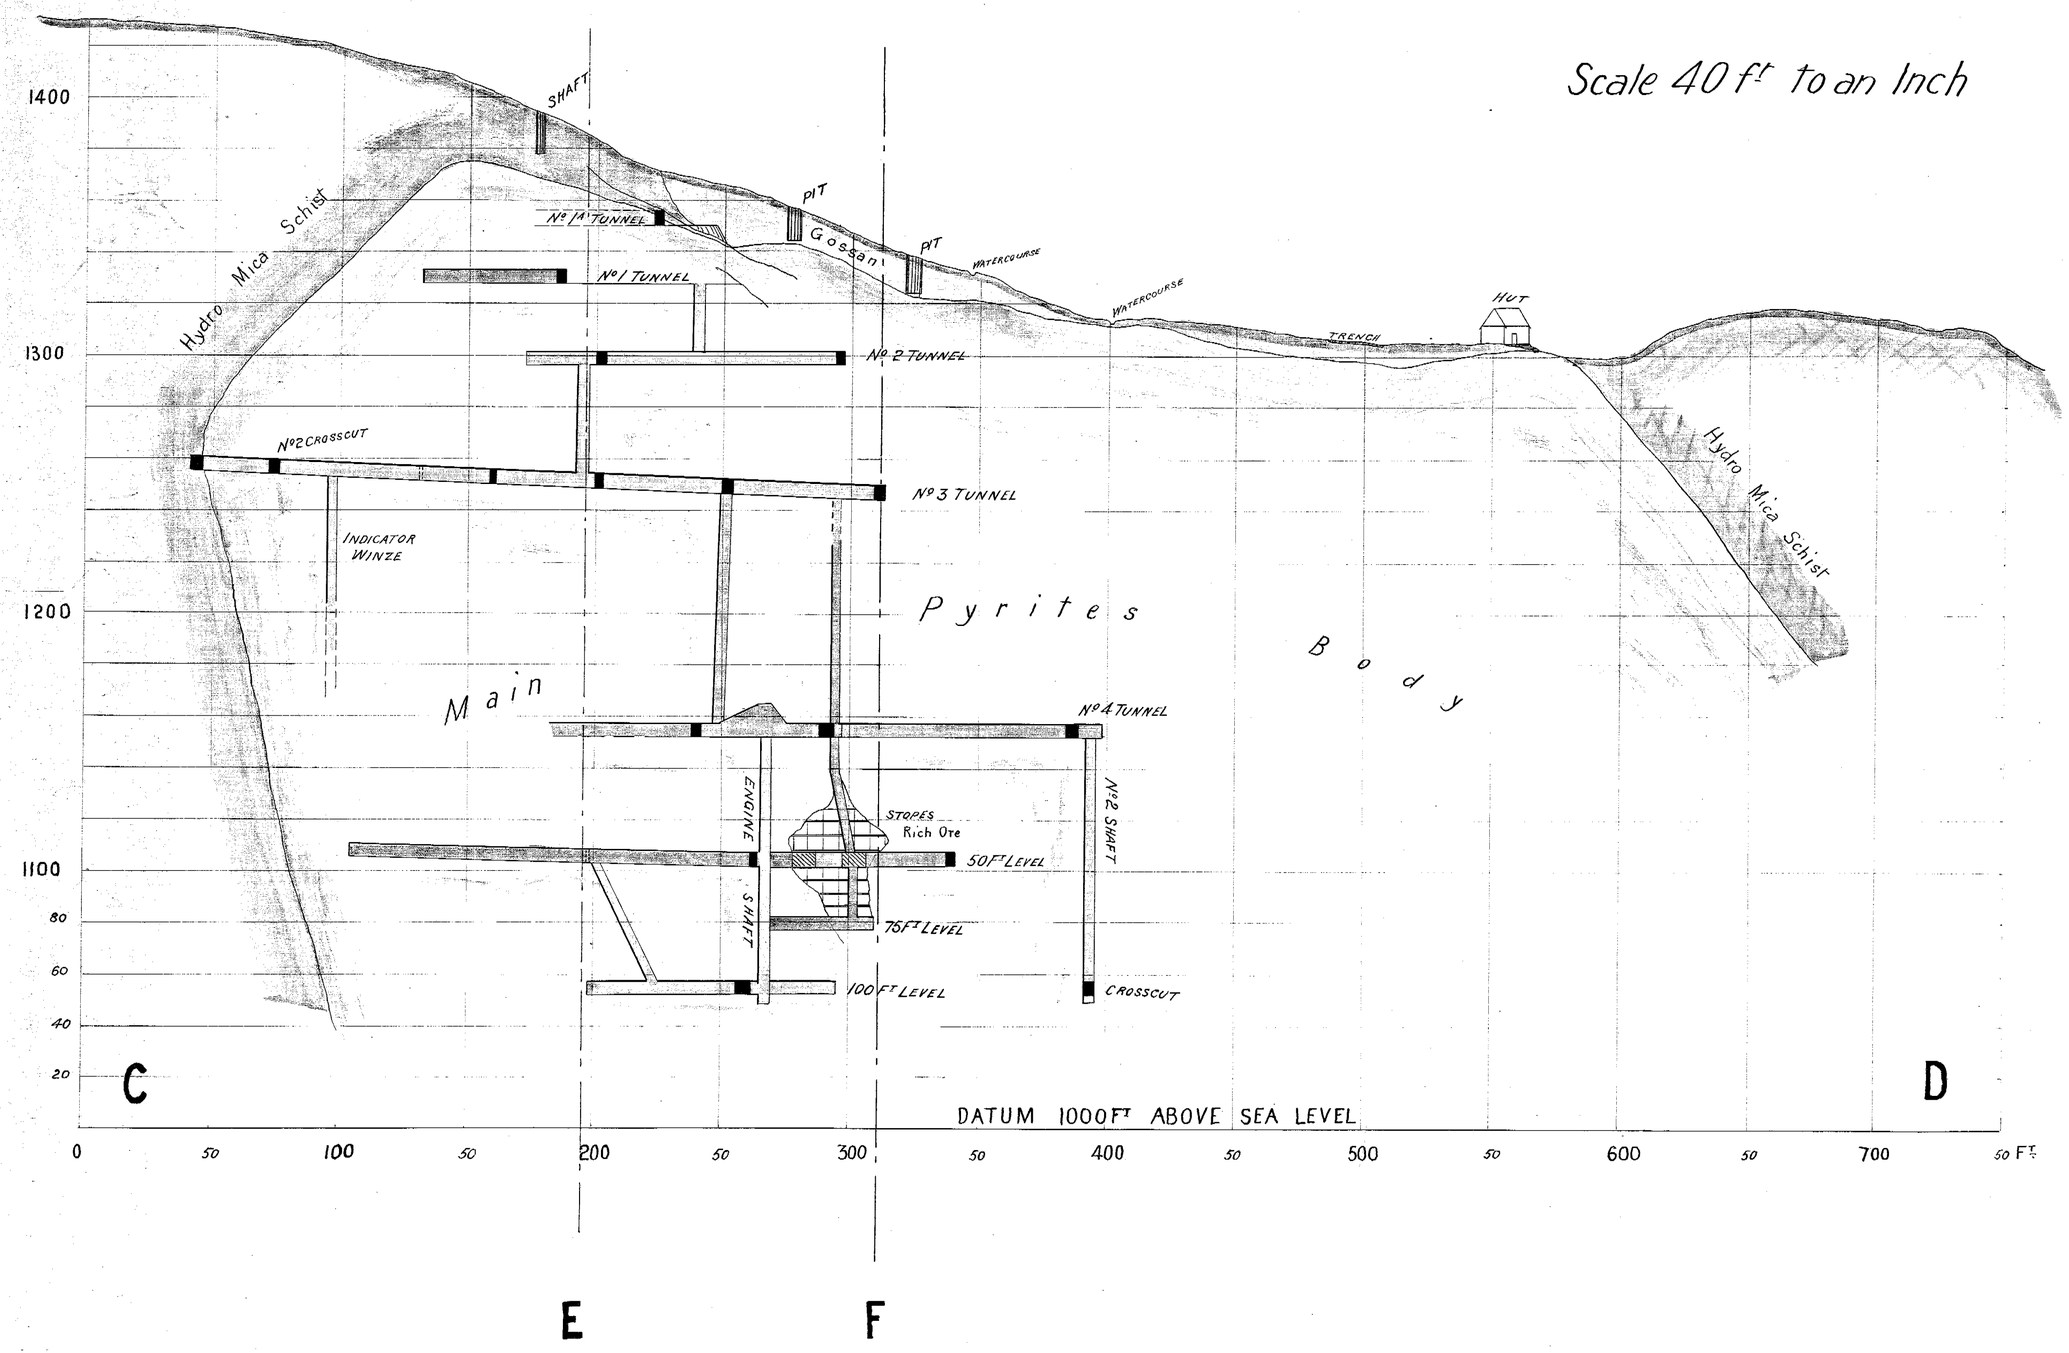
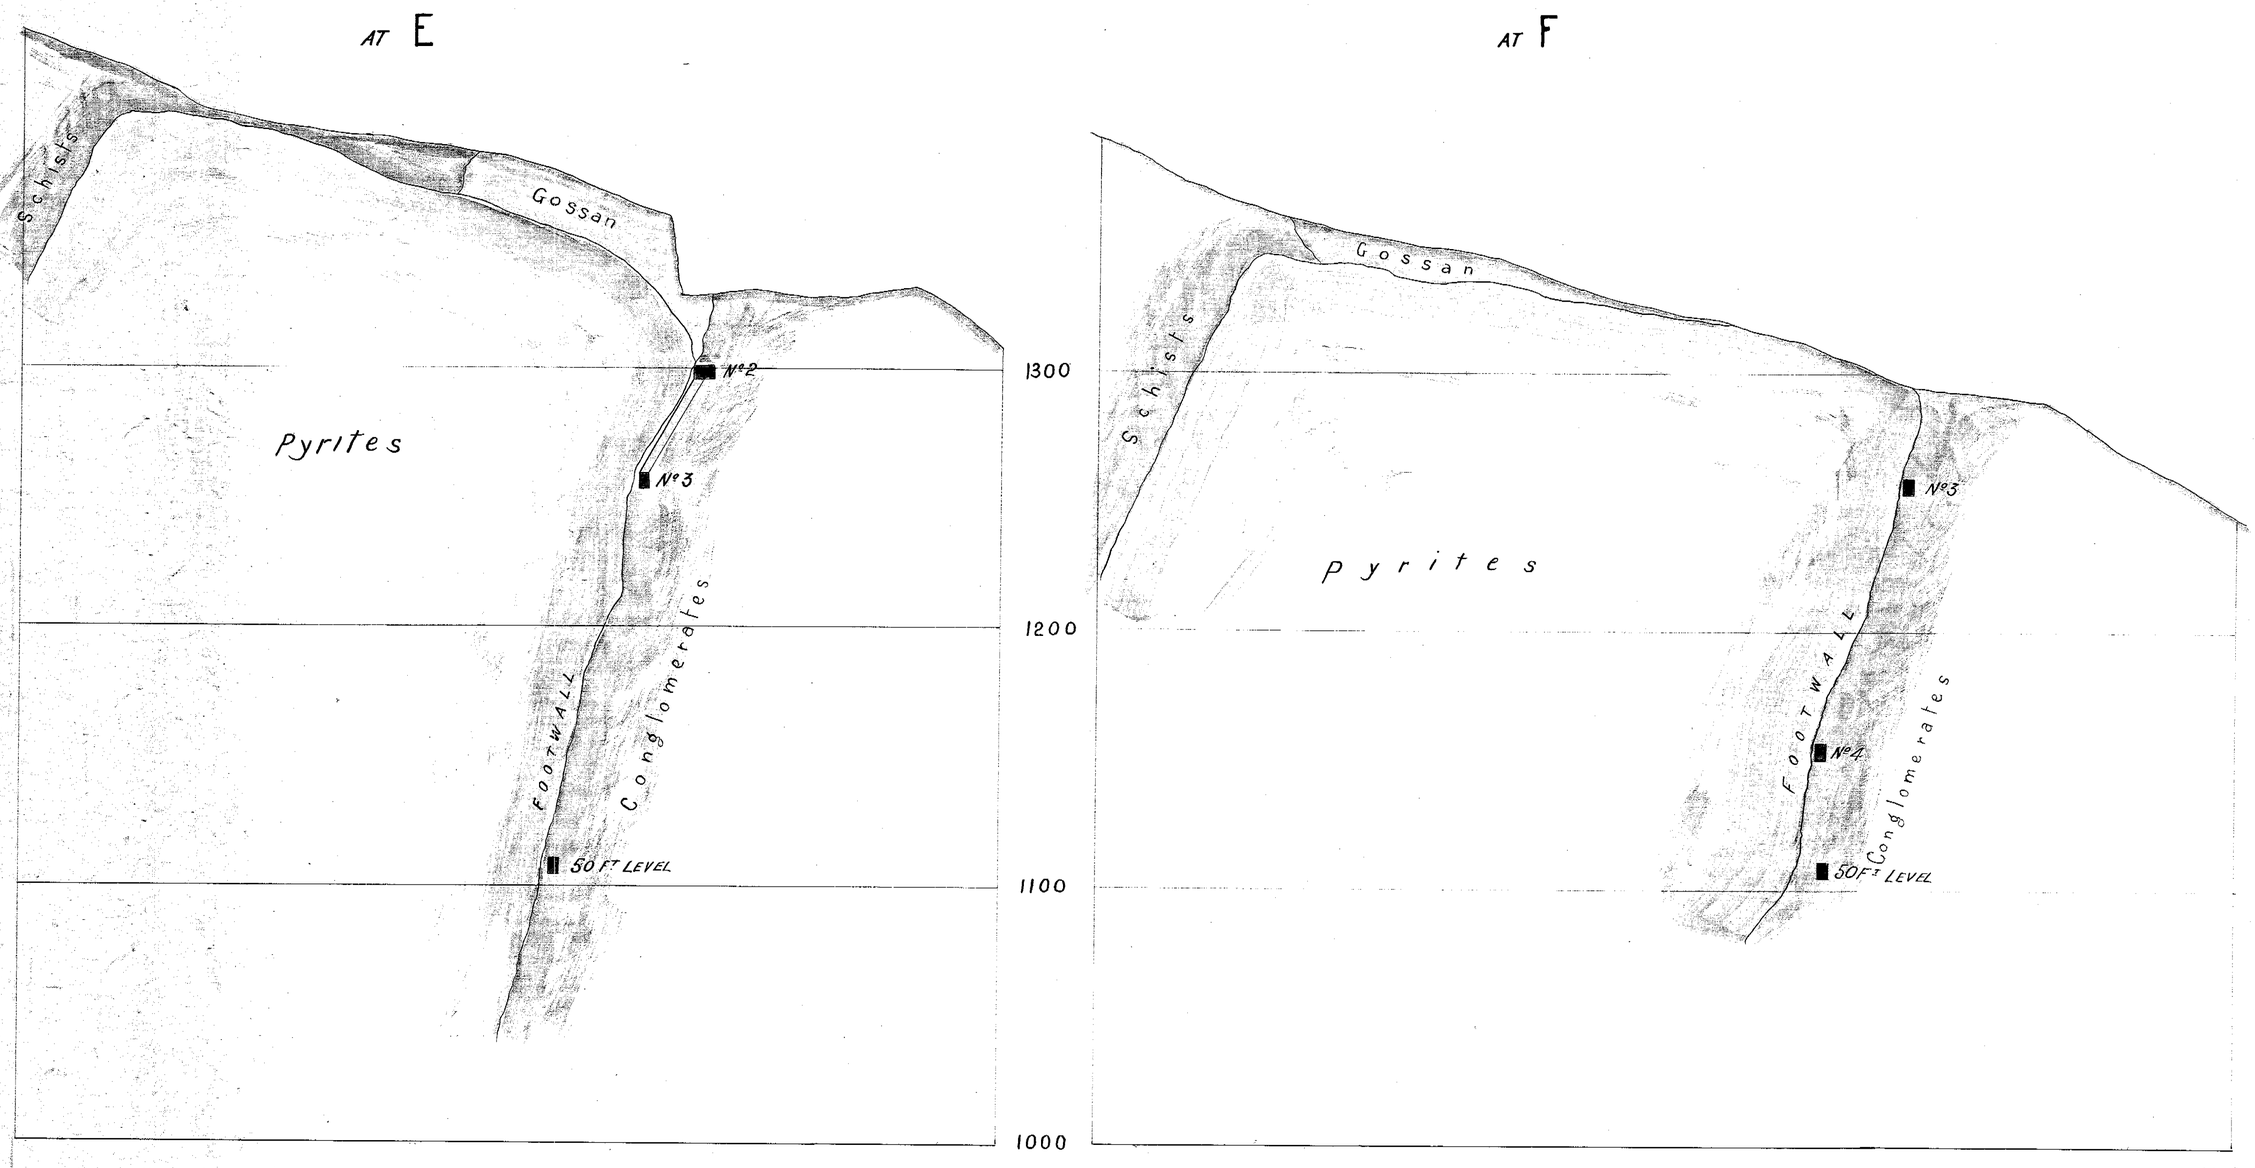
Transverse Sections of Pyrites Body