


218-31

The Mount Lyell Mining & Railway Co., Ltd.


Mine Department.

Plan of Workings.- Mount Lyell Reserve, Lease 4691 - 93M

Scale.-1" = 30'

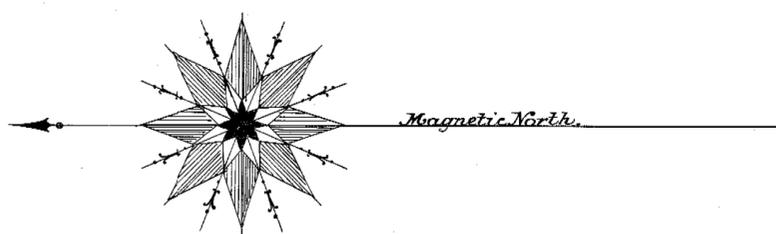

5 cm

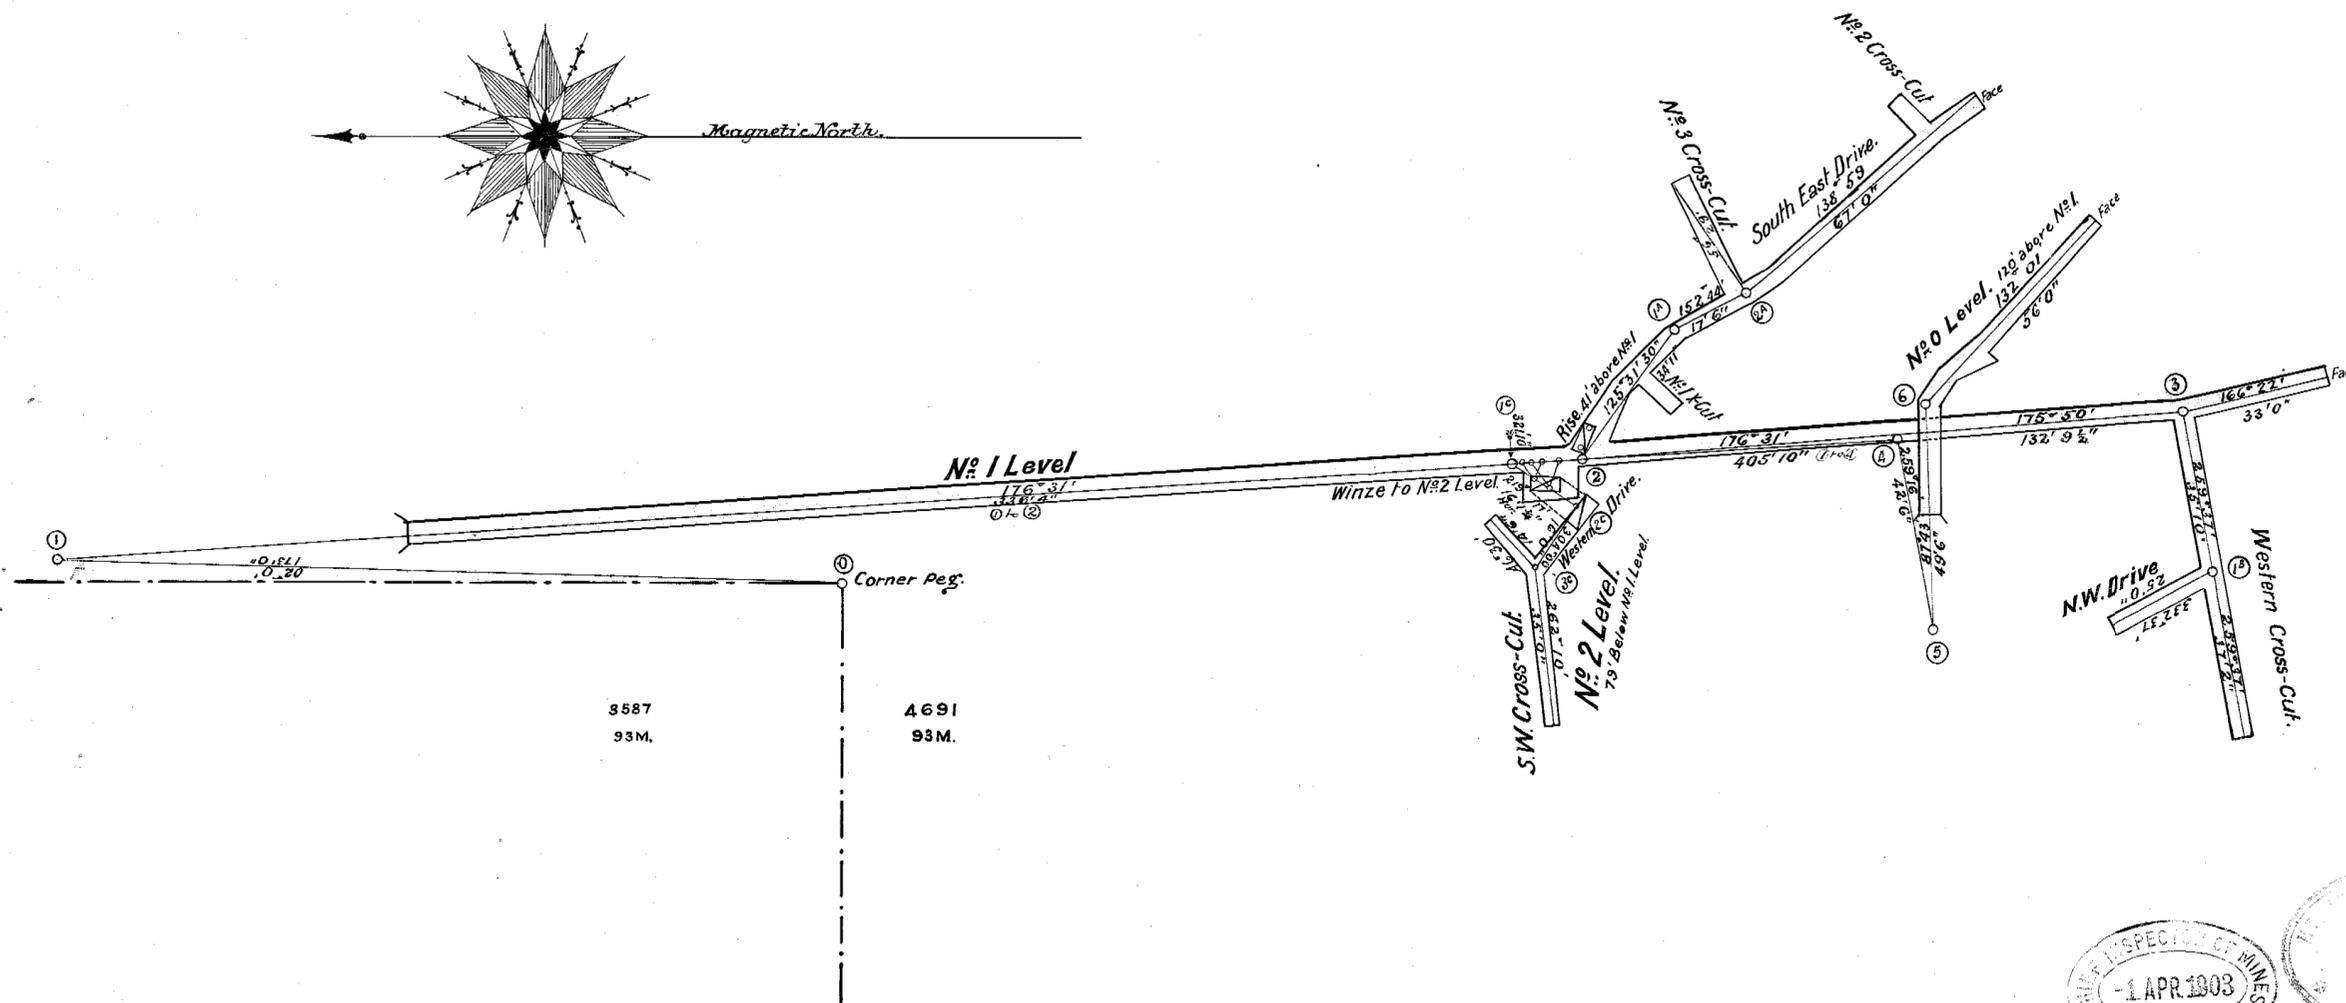

218-31

3587
93M.

4691
93M.



Genl. Manager *Robert Gifford*
Engineer-in-Charge *W. J. Hatchell*