


The Mount Lyell Mining & Railway Co., Ltd.

Mine Department.

Plan of Underground Workings North Crown Lyell

Scale 1 Inch = 30 Feet.

218-32

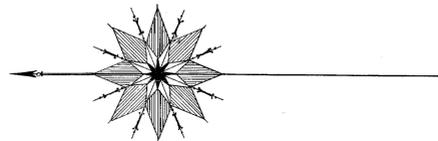

NORTH CROWN LYELL

602
53M.

A. B. Cruickshank
5128
53M

89° 52'

369° 52'
Datum.

A. B. Cruickshank
5127
53M

179° 52'
2,322' 0"

216° 31'
1,085' 5"

Nº 3 Tunnel. R.L. 250

Nº 2 Tunnel. R.L. 141

Nº 1 Tunnel. R.L. 107

N.E. Drive
S.W. Drive

APR 1903
LAURENCE ESTON

MT. LYELL M. & RY. CO. LTD.
ENGINEER'S OFFICE
16/11/03
MINING DEPT.

Genl. Manager. *Robt. Licht*
Engineer-in-Charge. *W. S. Hatchell*

218-32