

218-33

# The Mount Lyell Mining & Railway Co., Ltd.


Mine Department.

Plan Shewing Tunnel on Section 3579-93 M M<sup>T</sup> Lyell Reserve.

Scale 1 Inch = 30 Feet.

5 cm

218-33

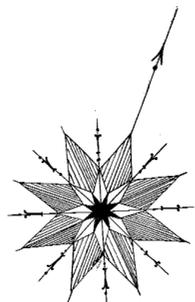

Magnetic 70-24

2

90-14  
120-3

7

4689  
93M.

340-02  
52-10

6

3

Tunnel

46-47  
141-0

N.W. DRIVE

4

116-24  
177

S.E. DRIVE

106-12  
470-5

3579  
93M.

ROYAL THARSIS.

935 - 93M.

N<sup>o</sup> 1 M<sup>o</sup> LYELL CONSOLIDATED MIN C<sup>o</sup> N<sup>o</sup> 1

2140  
91M.



Genl. Manager *Robert Sturt*  
Engineer-in-Charge *W. J. Hatchell*