

218-47

218-47

5 cm

COPPER MINES OF MOUNT LYELL WEST LIM.

282
M 70a

MOUNT LYELL EXTENDED
21
87 10a



WEST LYELL
EASEMENT

M^r LYELL M. AND R. C^o L^{td}
EASEMENT

MOUNT LYELL EXTENDED
21
87 10a

LYELL PIONEER
21
87 10a

M^r LYELL M. AND R. C^o L^{td}
30
86 10a

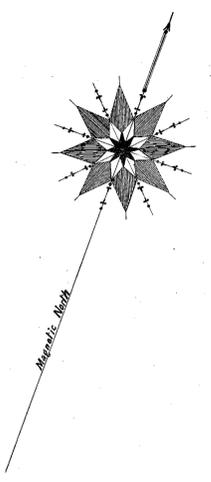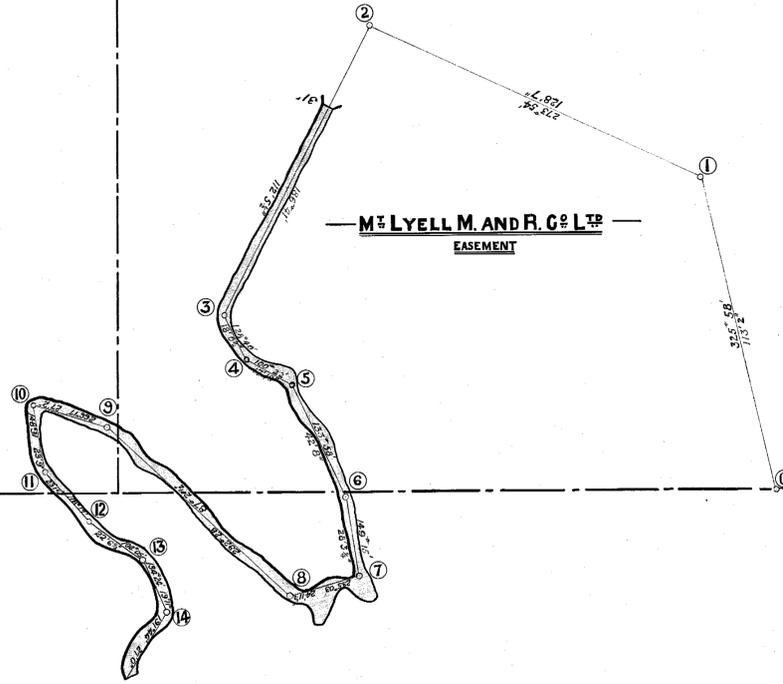

The Mount Lyell Mining & Railway Co., Ltd.

Mine Department.

PLAN OF

CONTACT DRIVE AT LEASE 30/86

Scale: 1" = 30'

20-II-04



Cent. Manager *Robt. Grant*
 Engineer-in-Charge *W. J. Hatcher*