SHEET Nº 2.

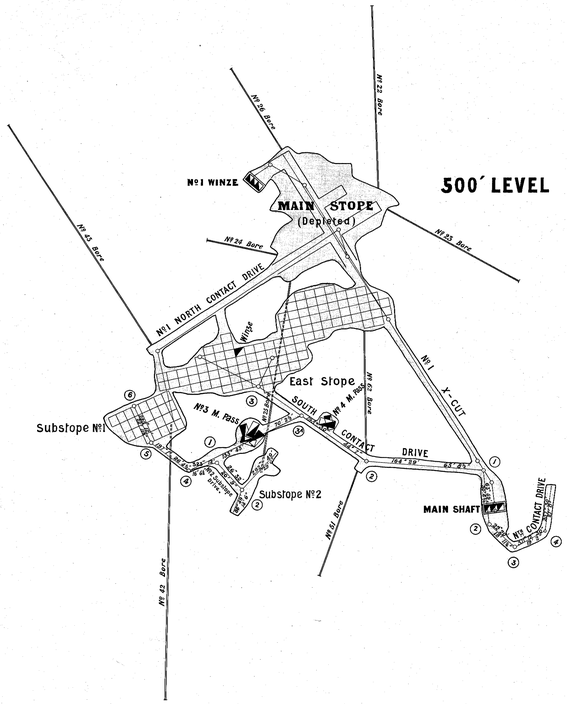

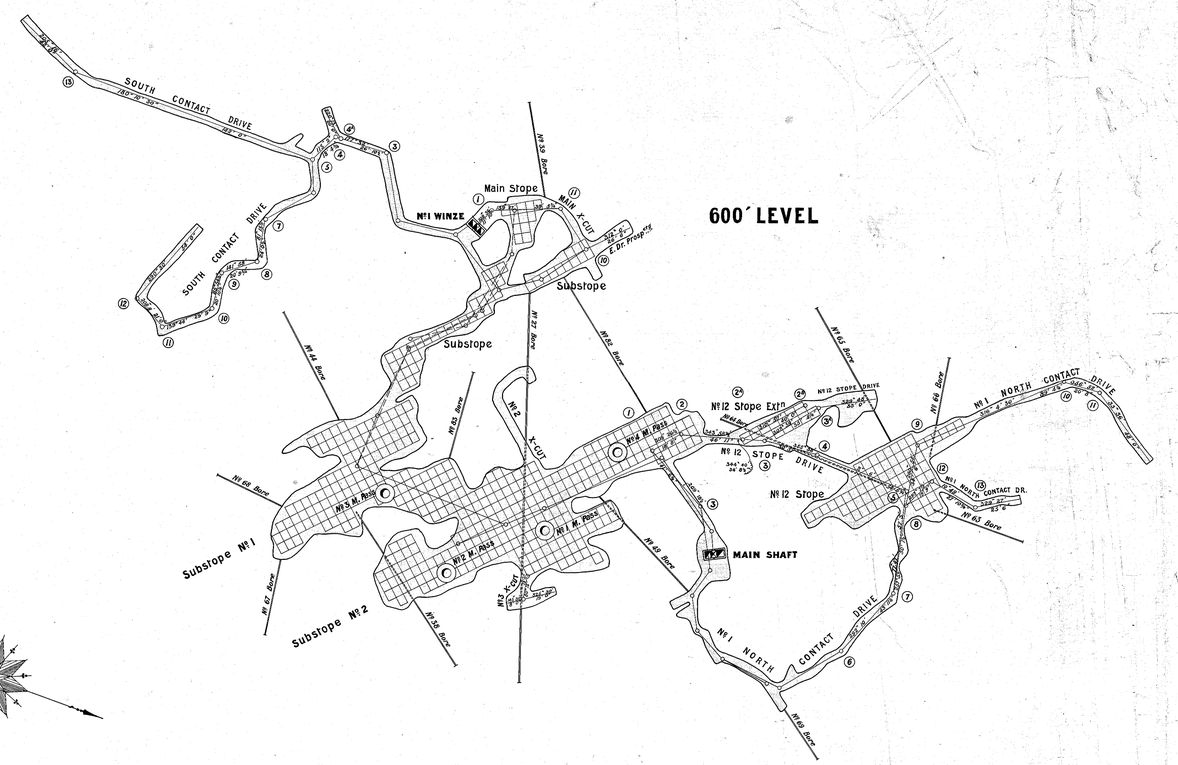

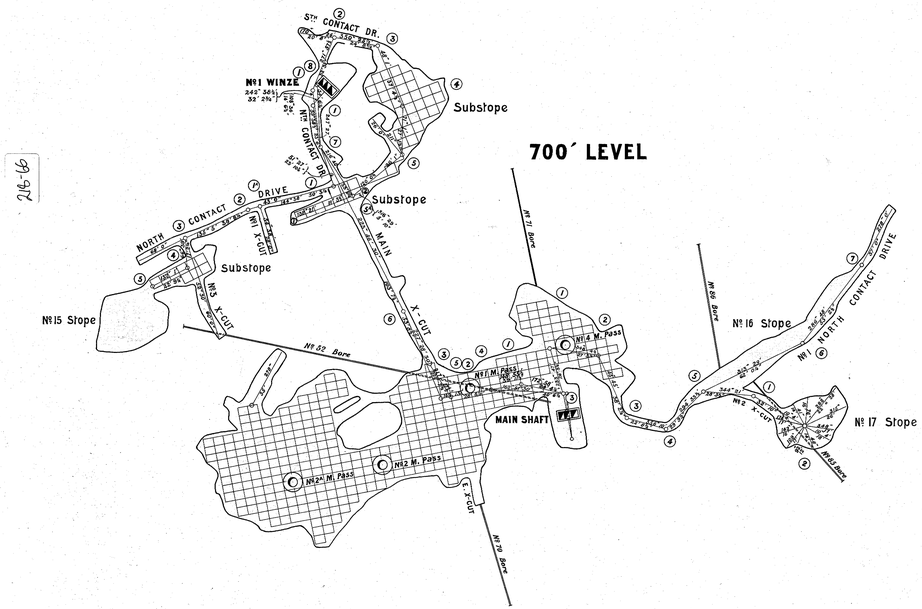

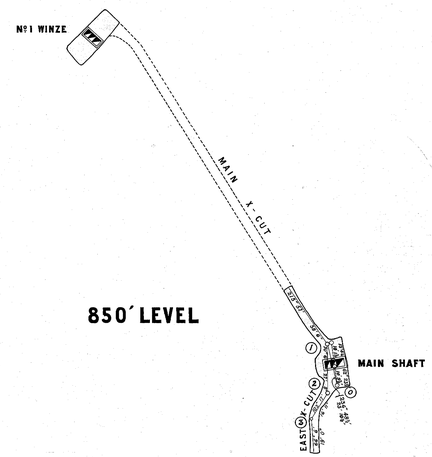

Genl Manager... Robt Sticht

Eng^r in Charge... R. H. Murray (Acting).

The Mount Lyell Mining & Railway Co., Ltd.

Mine Department.

DETAIL PLAN OF UNDERGROUND WORKINGS.

NORTH LYELL MINE.

Brought up to 31st Dec. 1906.

Scale 1" = 30′.