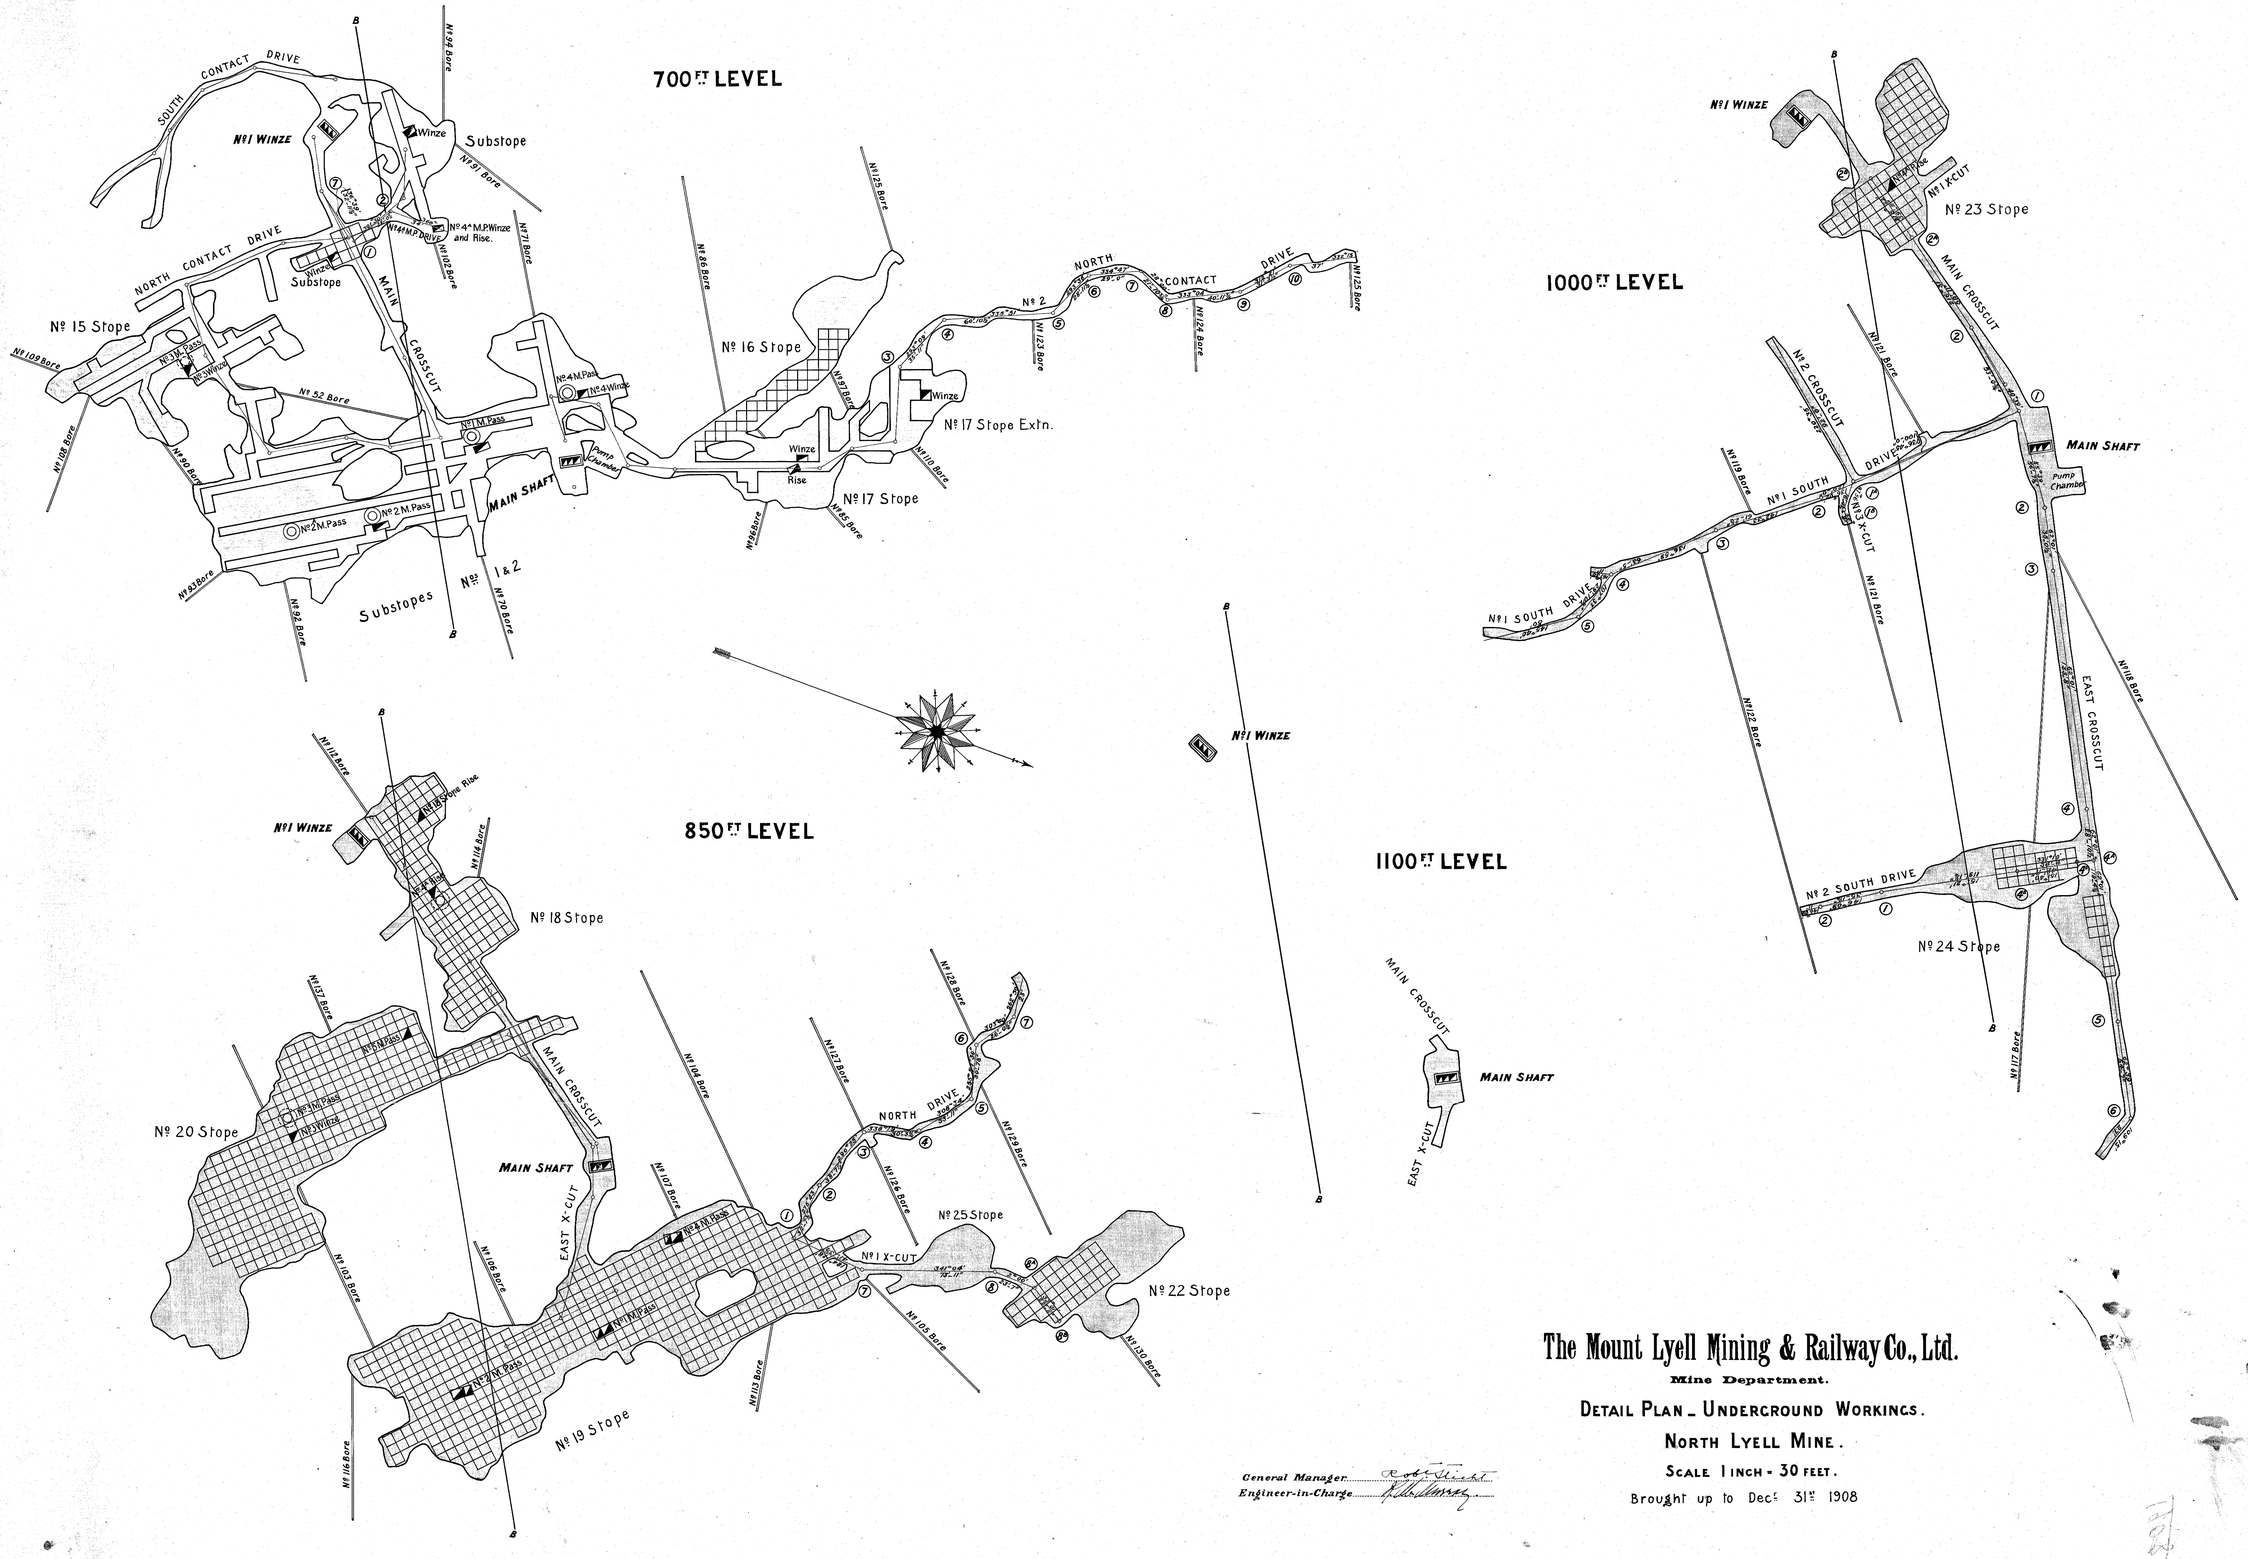

The Mount Lyell Mining & Railway Co., Ltd.

Mine Department.

DETAIL PLAN _ UNDERGROUND WORKINGS.

NORTH LYELL MINE.

SCALE 1 INCH = 30 FEET.

Brought up to Decr 31st 1908

General Manager ..... R. Ulrich

Engineer-in-Charge ..... F. Blackmore