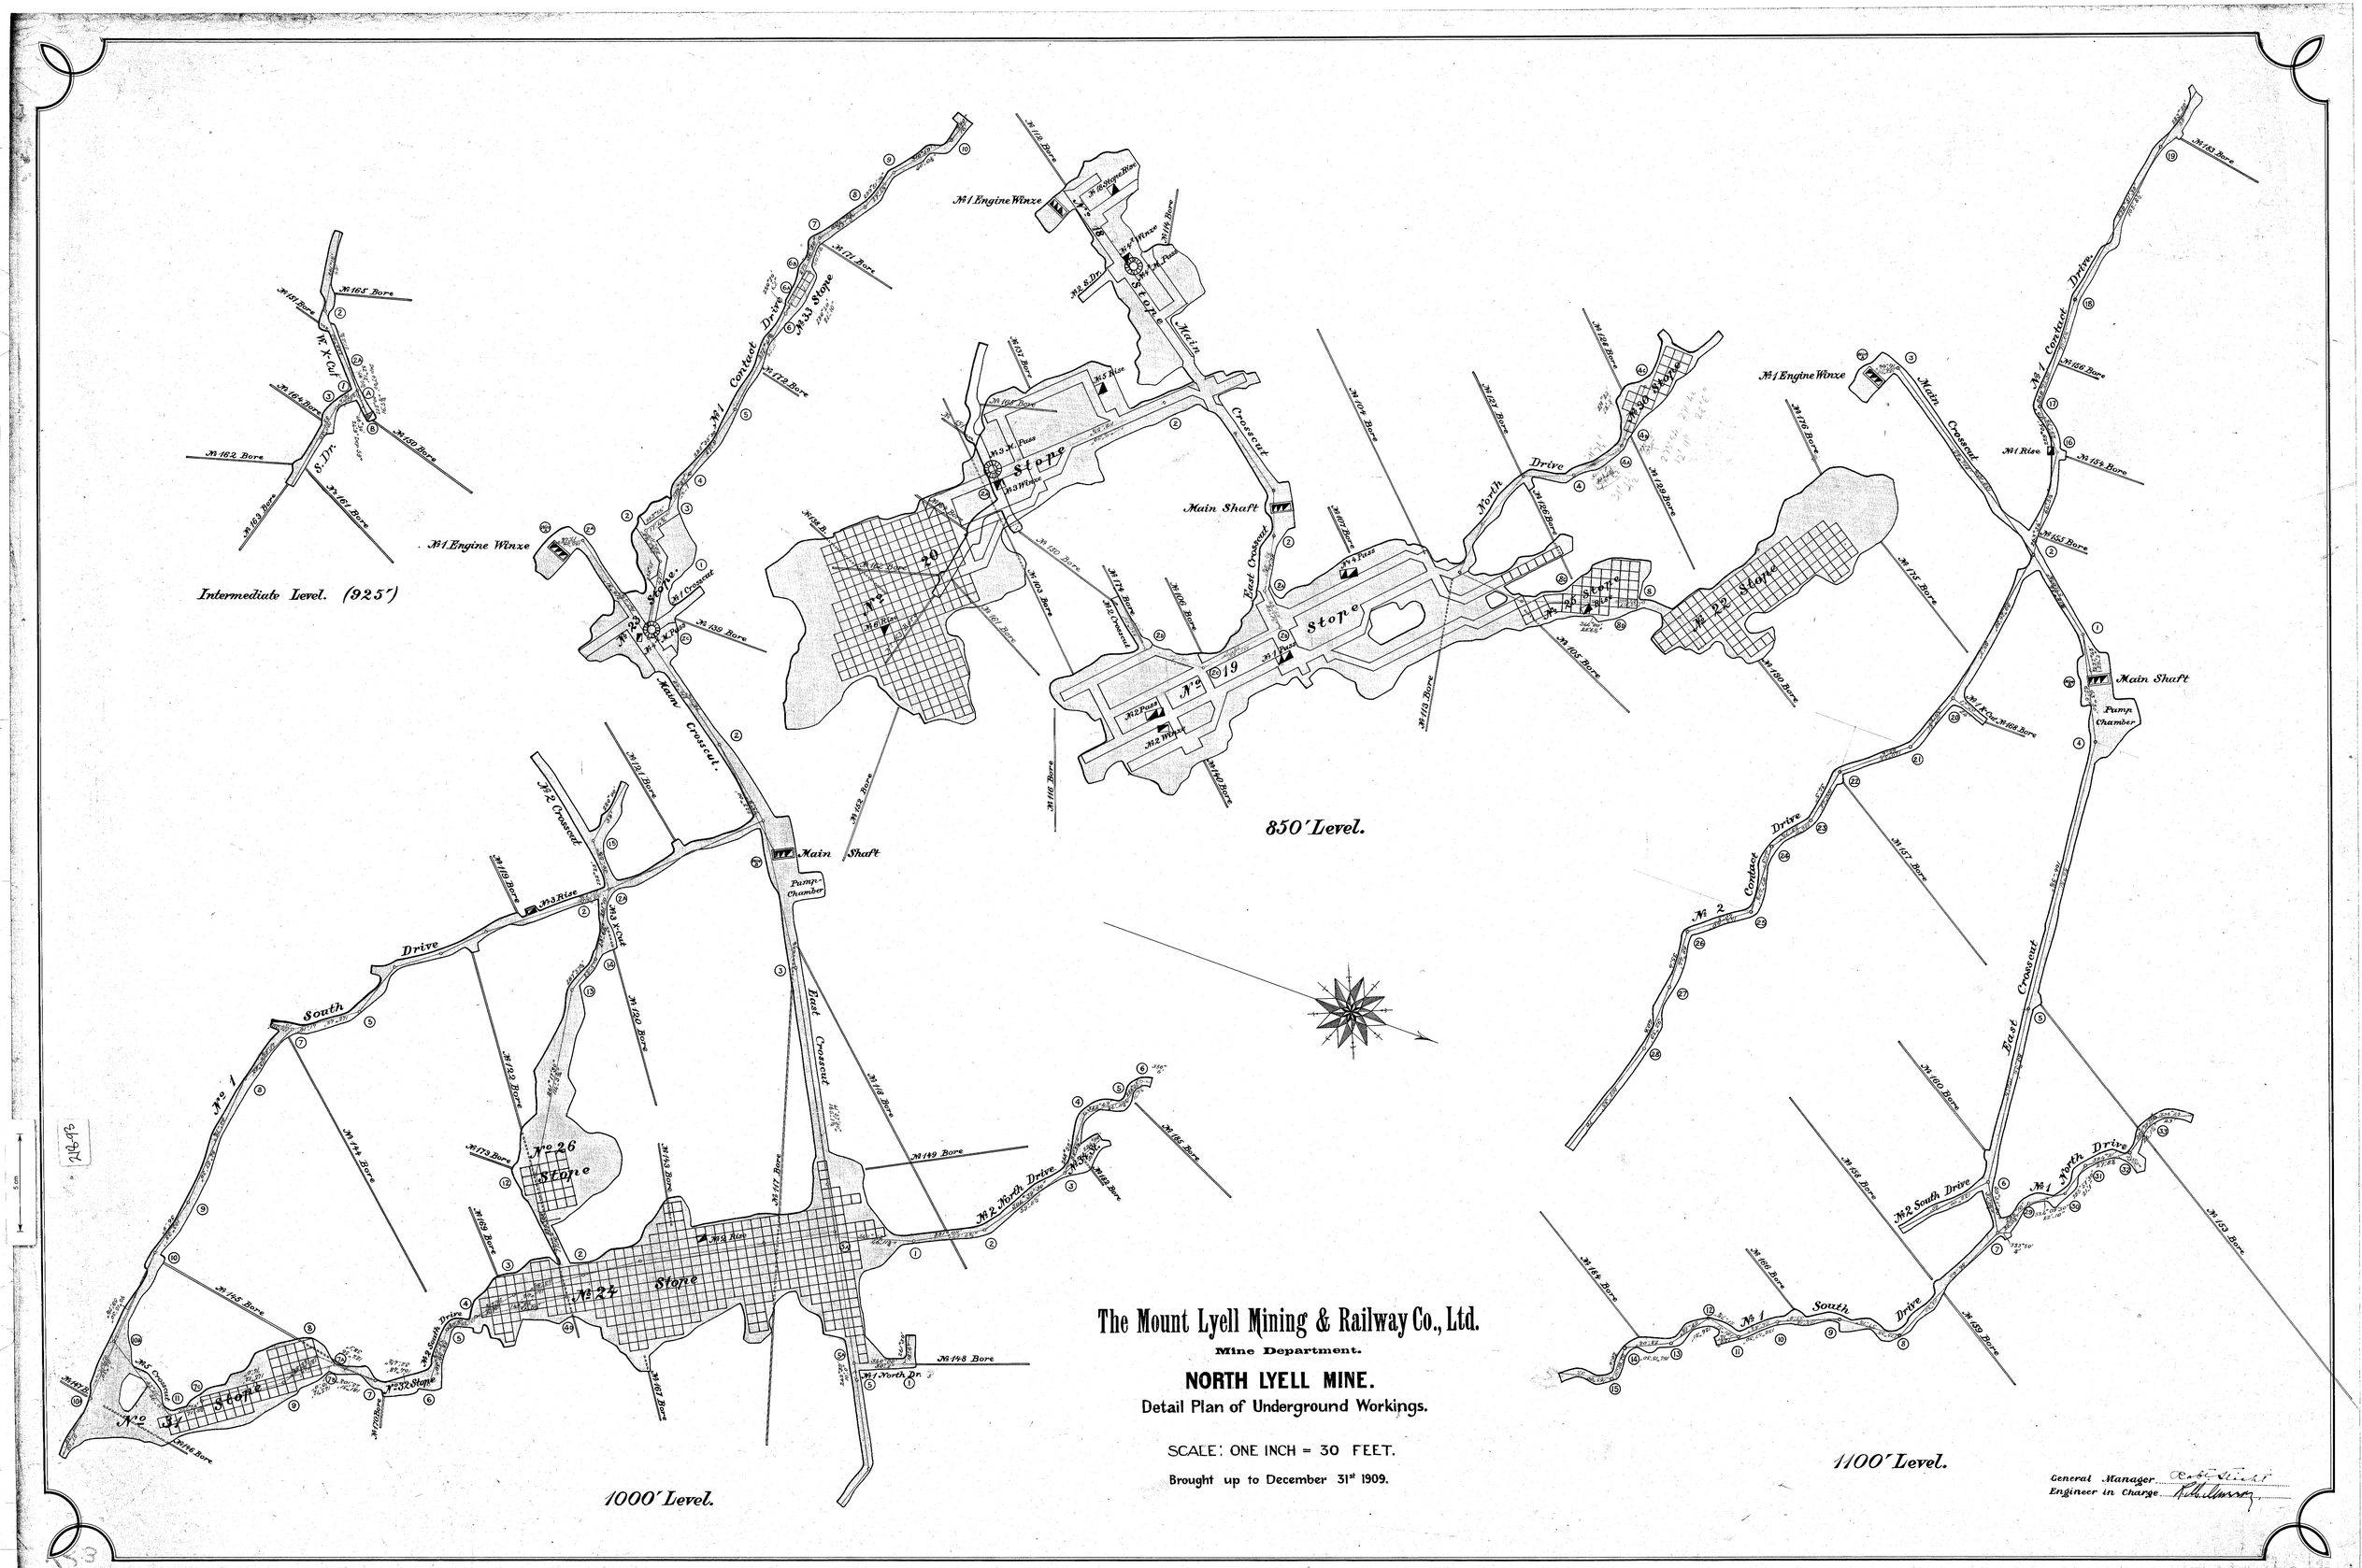
Intermediate Level. (925')
850' Level.
1000' Level.
1100' Level.
The Mount Lyell Mining & Railway Co., Ltd.
Mine Department.
NORTH LYELL MINE.
Detail Plan of Underground Workings.
SCALE: ONE INCH = 30 FEET.
Brought up to December 31st 1909.
General Manager
Engineer in Charge
Main Shaft
Pump Chamber
No 1 Engine Winze
No 1 Contact Drive
No 2 Contact Drive
Main Crosscut
East Crosscut
North Drive
South Drive
No 1 South Drive
No 2 South Drive
No 1 North Drive
No 2 North Drive
No 19 Stope
No 20 Stope
No 22 Stope
No 23 Stope
No 24 Stope
No 26 Stope
No 33 Stope
No 34 Stope
No 32 Stope
No 2 Crosscut
No 3 Crosscut
No 1 Crosscut
No 1 Rise
No 3 Rise
No 4 Rise
No 5 Rise
No 6 Rise
No 2 Winze
No 3 Winze
No 1 Winze
