


218-114

218-114

5 cm

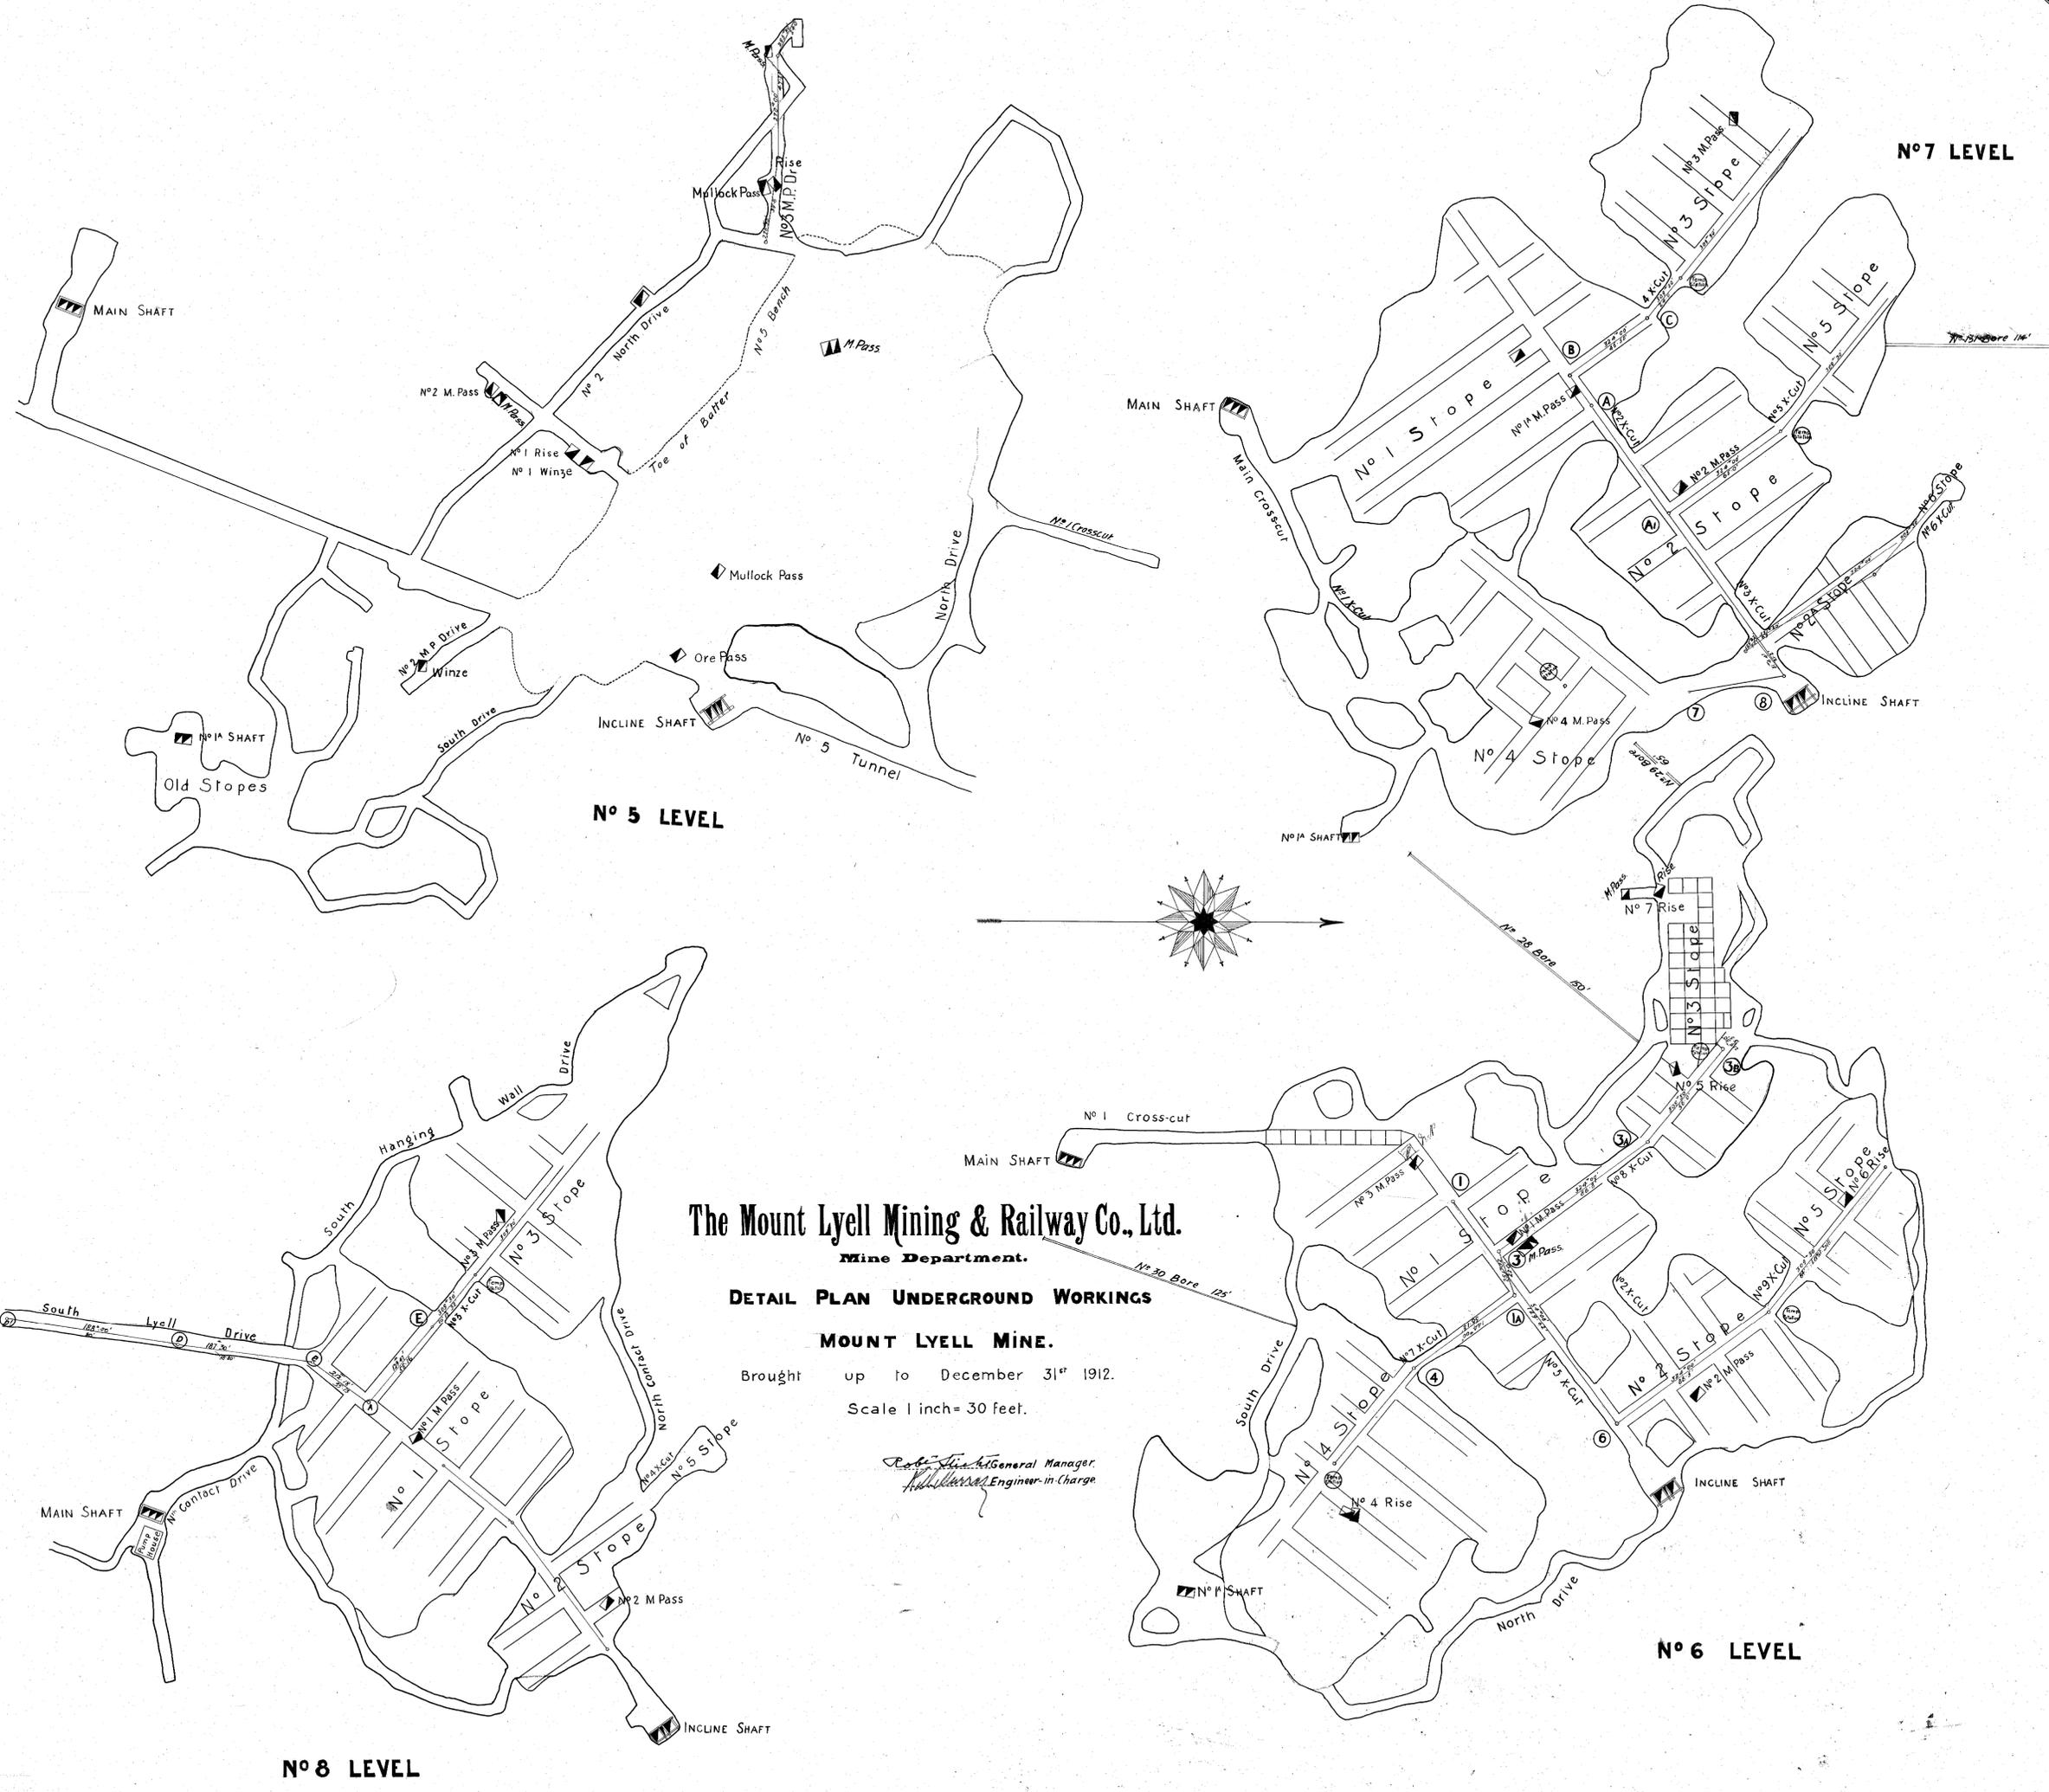

No. 7 LEVEL

No. 5 LEVEL

No. 6 LEVEL

No. 8 LEVEL