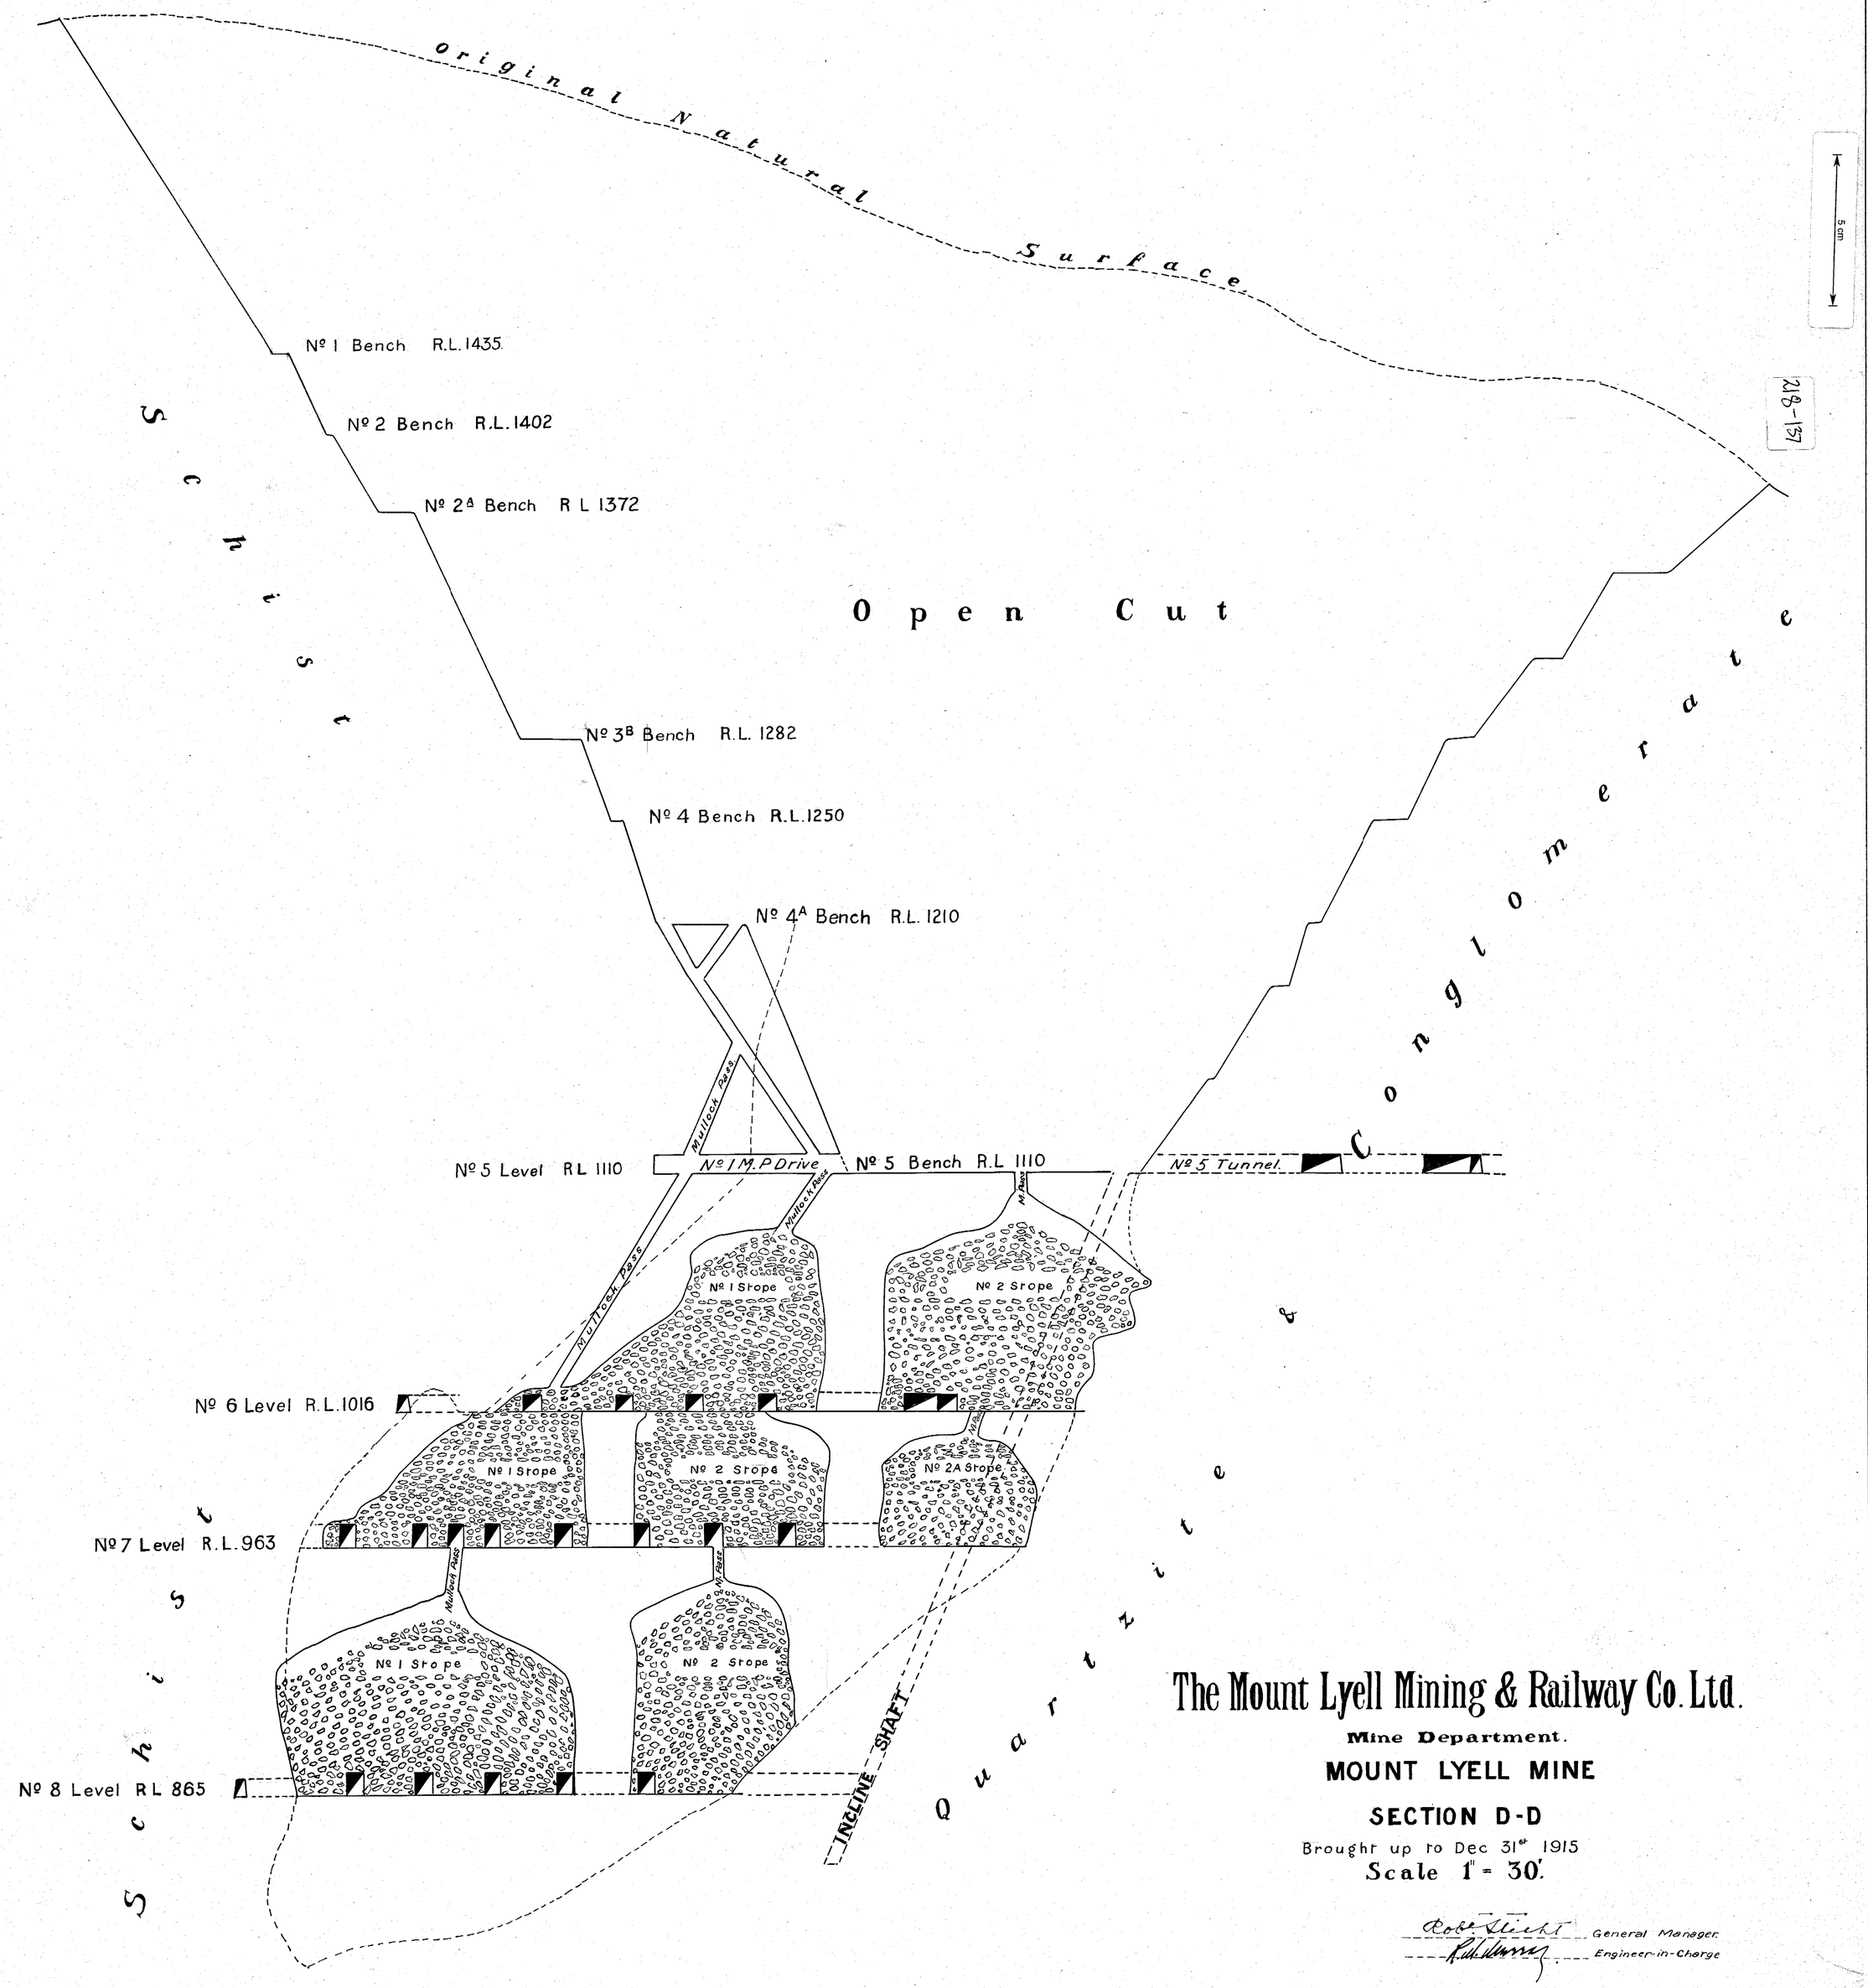

The Mount Lyell Mining & Railway Co. Ltd.

Mine Department.

MOUNT LYELL MINE

SECTION D-D

Brought up to Dec 31st 1915

Scale 1" = 30'.

Robt. Sticht General Manager.

R.H. Murray Engineer-in-Charge

W.H. 31-3-16.

218-137