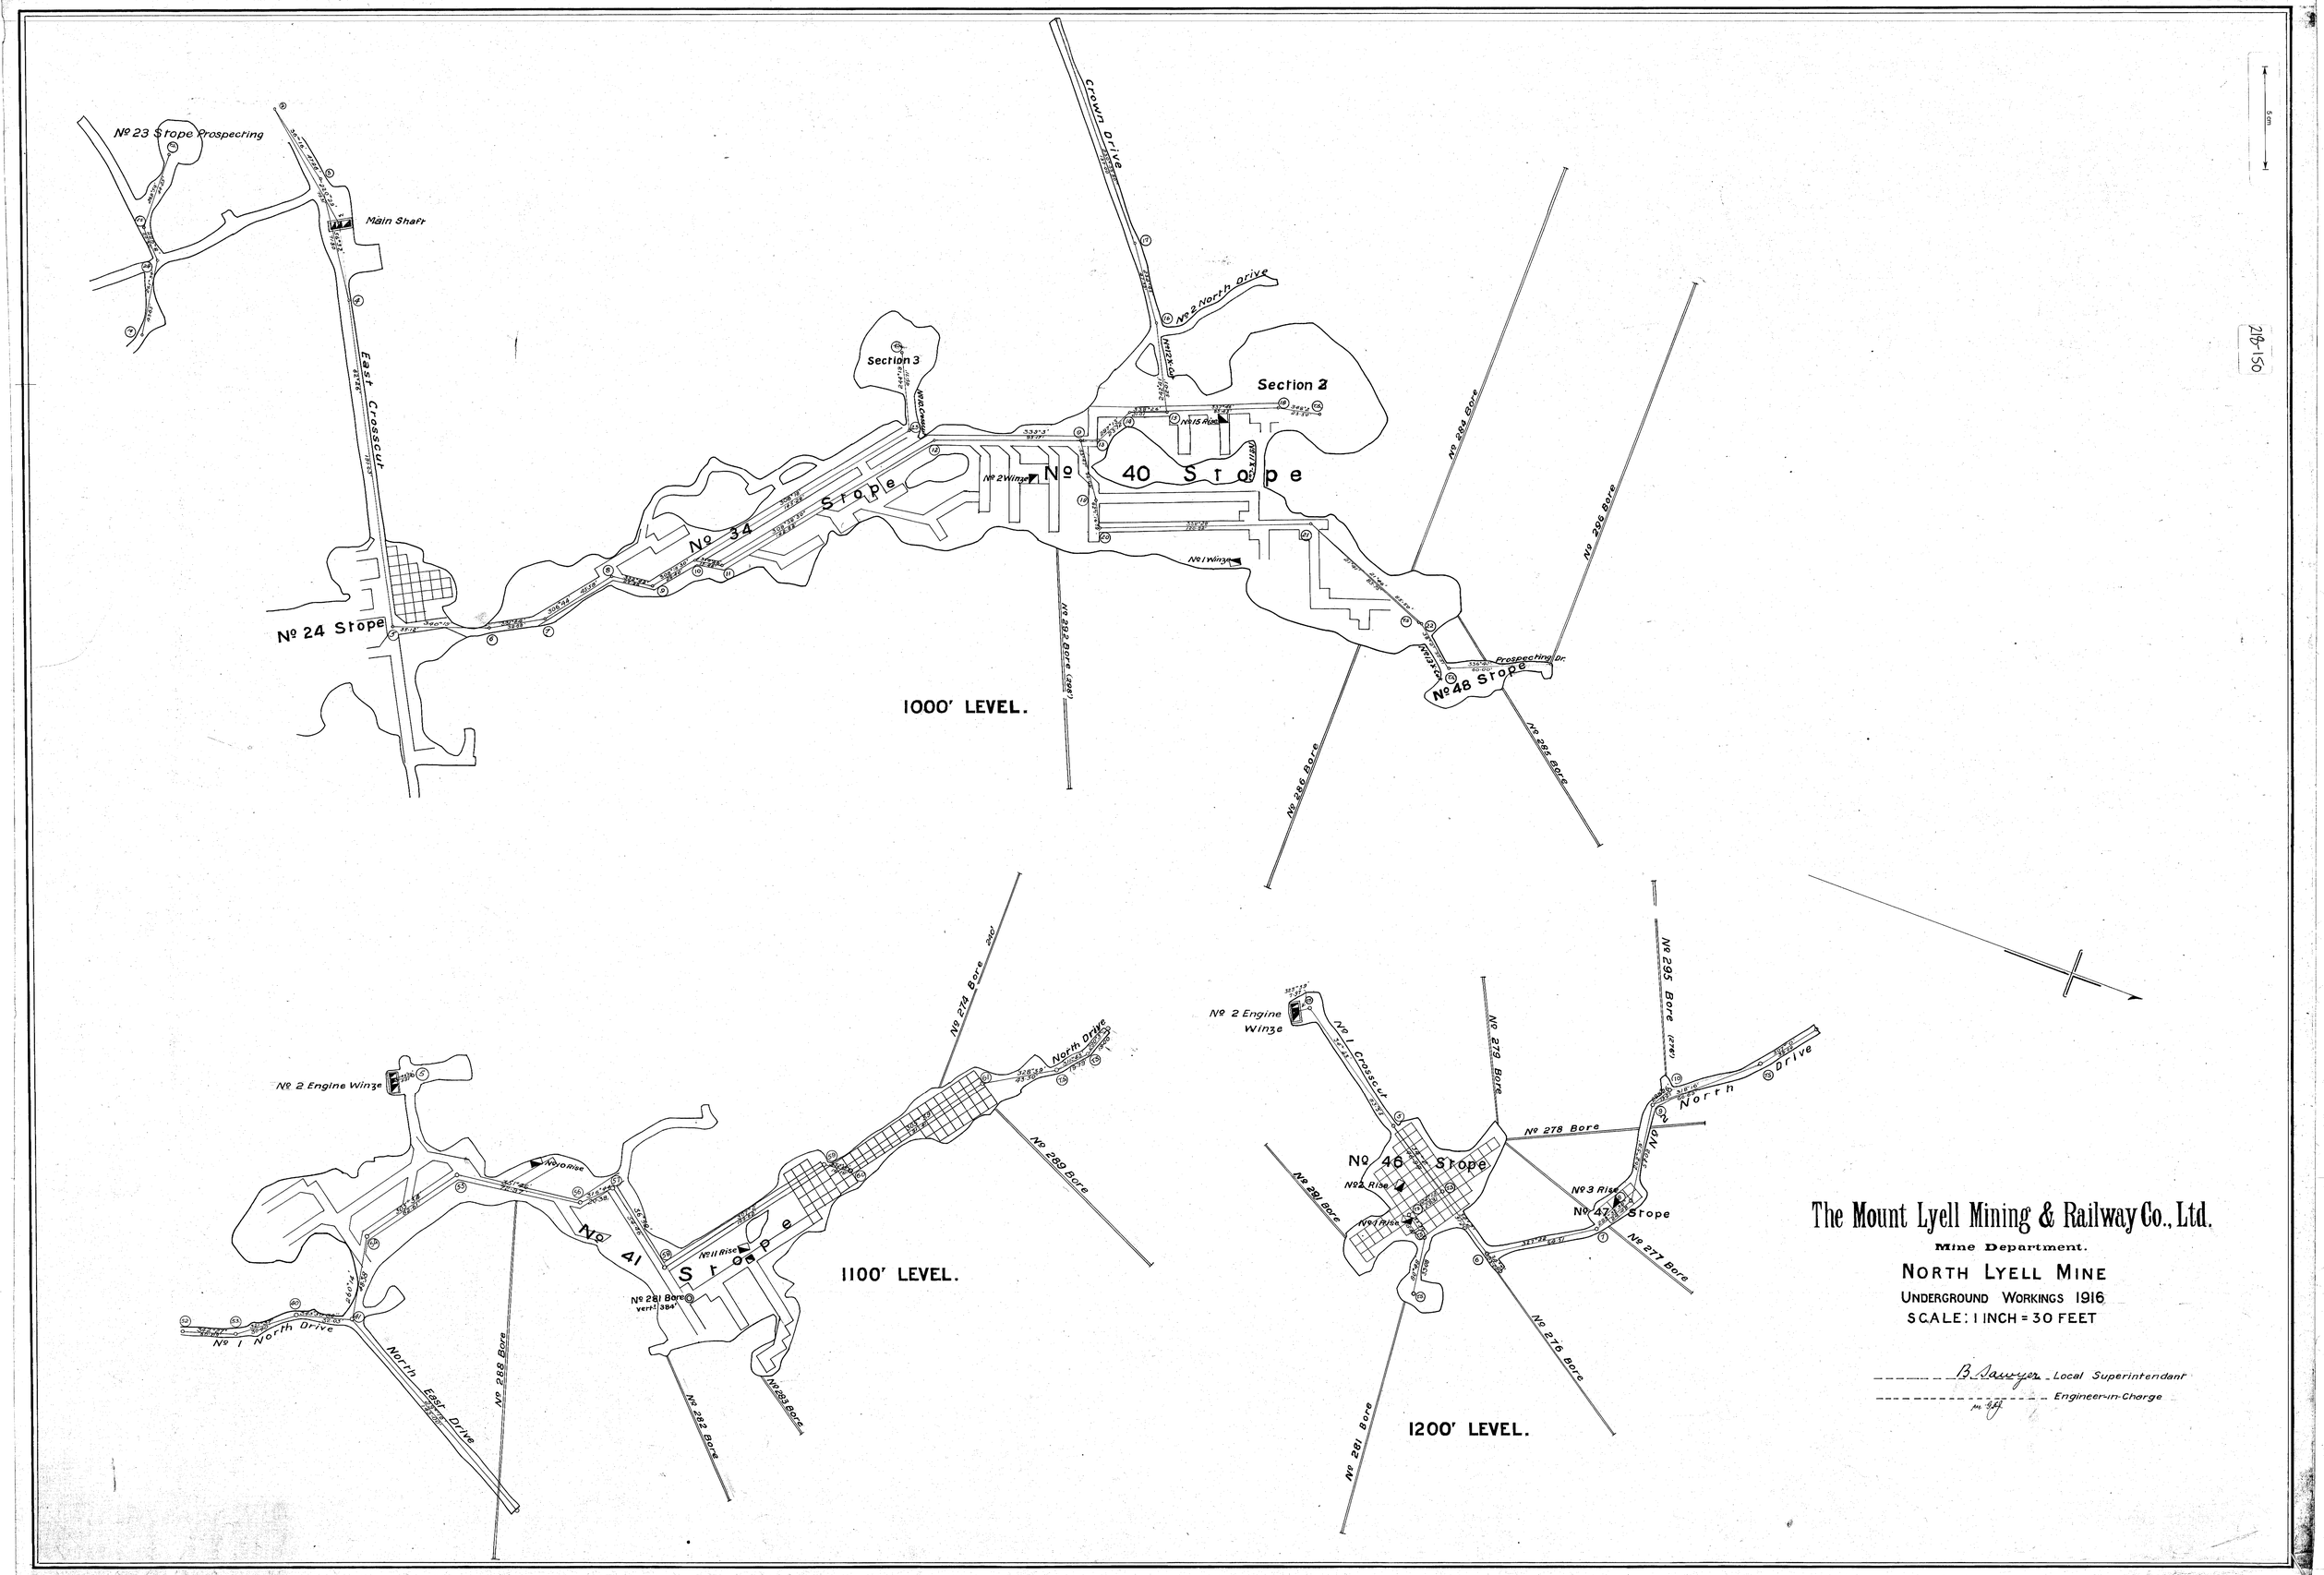

The Mount Lyell Mining & Railway Co., Ltd.

Mine Department.

NORTH LYELL MINE

UNDERGROUND WORKINGS 1916

SCALE: 1 INCH = 30 FEET

B. Sawyer Local Superintendant

Engineer-in-Charge

218-150

218-150