218
-161

5 cm

The Mount Lyell Mining & Railway Co. Ltd.

Sheet No. 4.

Mine Department.

Field Notes of Underground Workings to 31.12.14.

Instrument used 5" Theodolite.

General Manager

Engineer-in-Charge

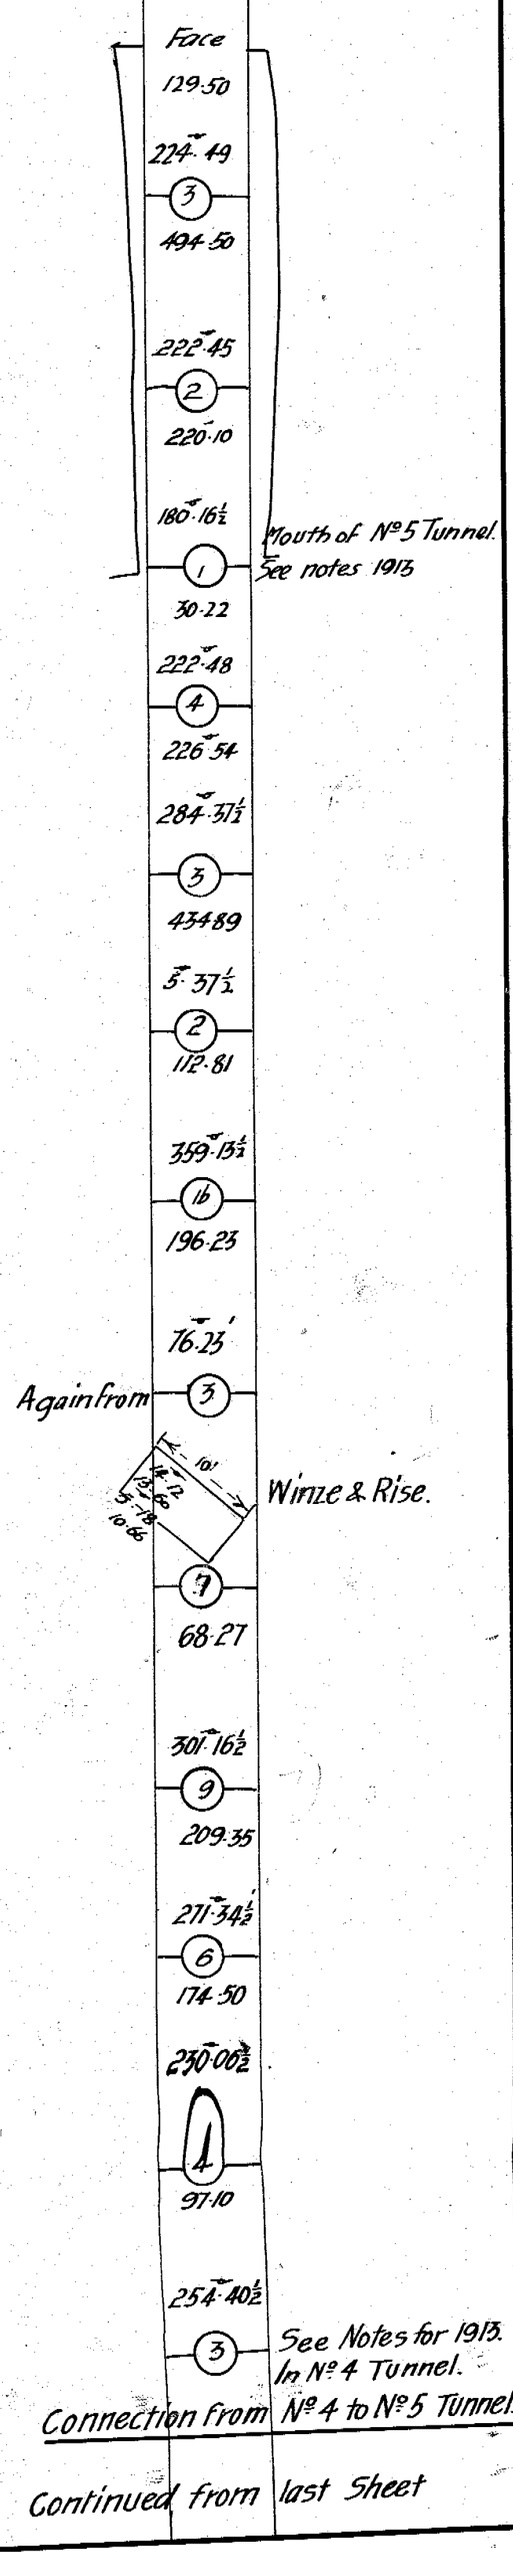

Continued from last Sheet