The Mount Lyell Mining & Railway Co. Ltd.

Mine Department.

Sheet No. 3.

Field Notes of Underground Workings to 31.12.14.

Instrument used 5' Theodolite.

General Manager.
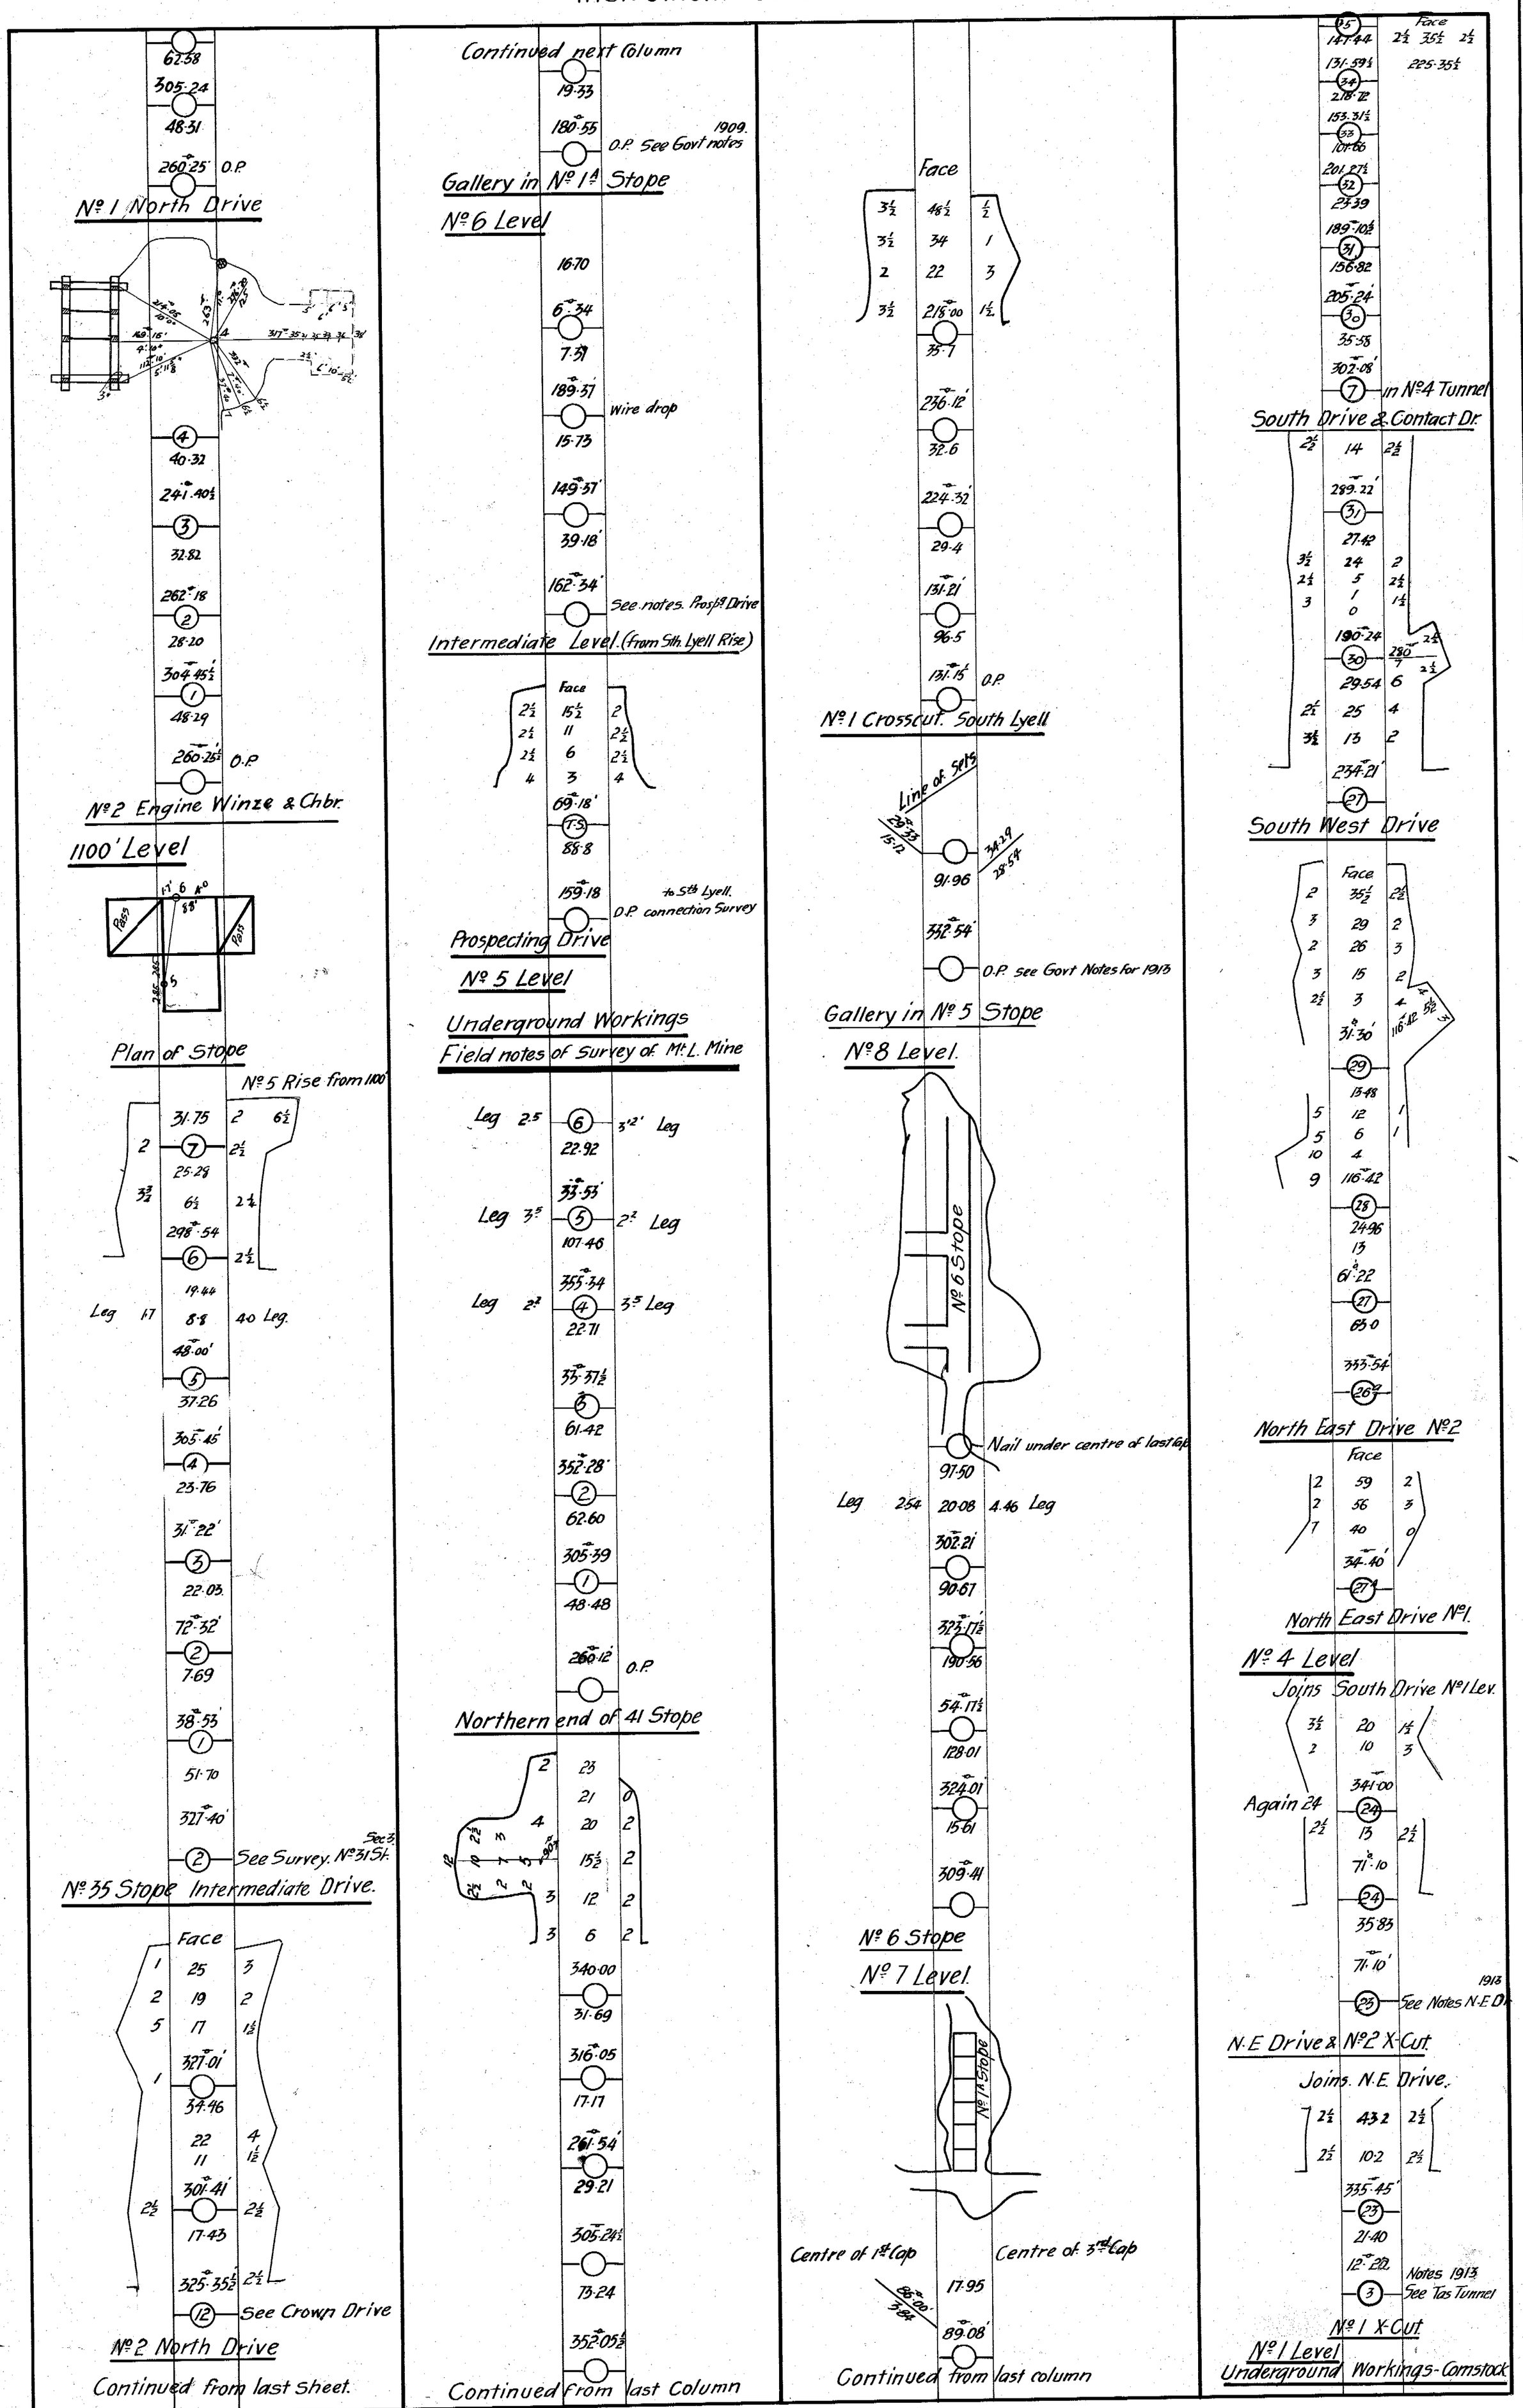
Engineer-in-Charge.