218
-161

5 cm

The Mount Lyell Mining & Railway Co., Ltd.

Mine Department.

SHEET No. 5.

Field Notes of Underground Workings up to 31-12-13.

Local Supt.

Engineer-in-Charge. R. H. Murray.
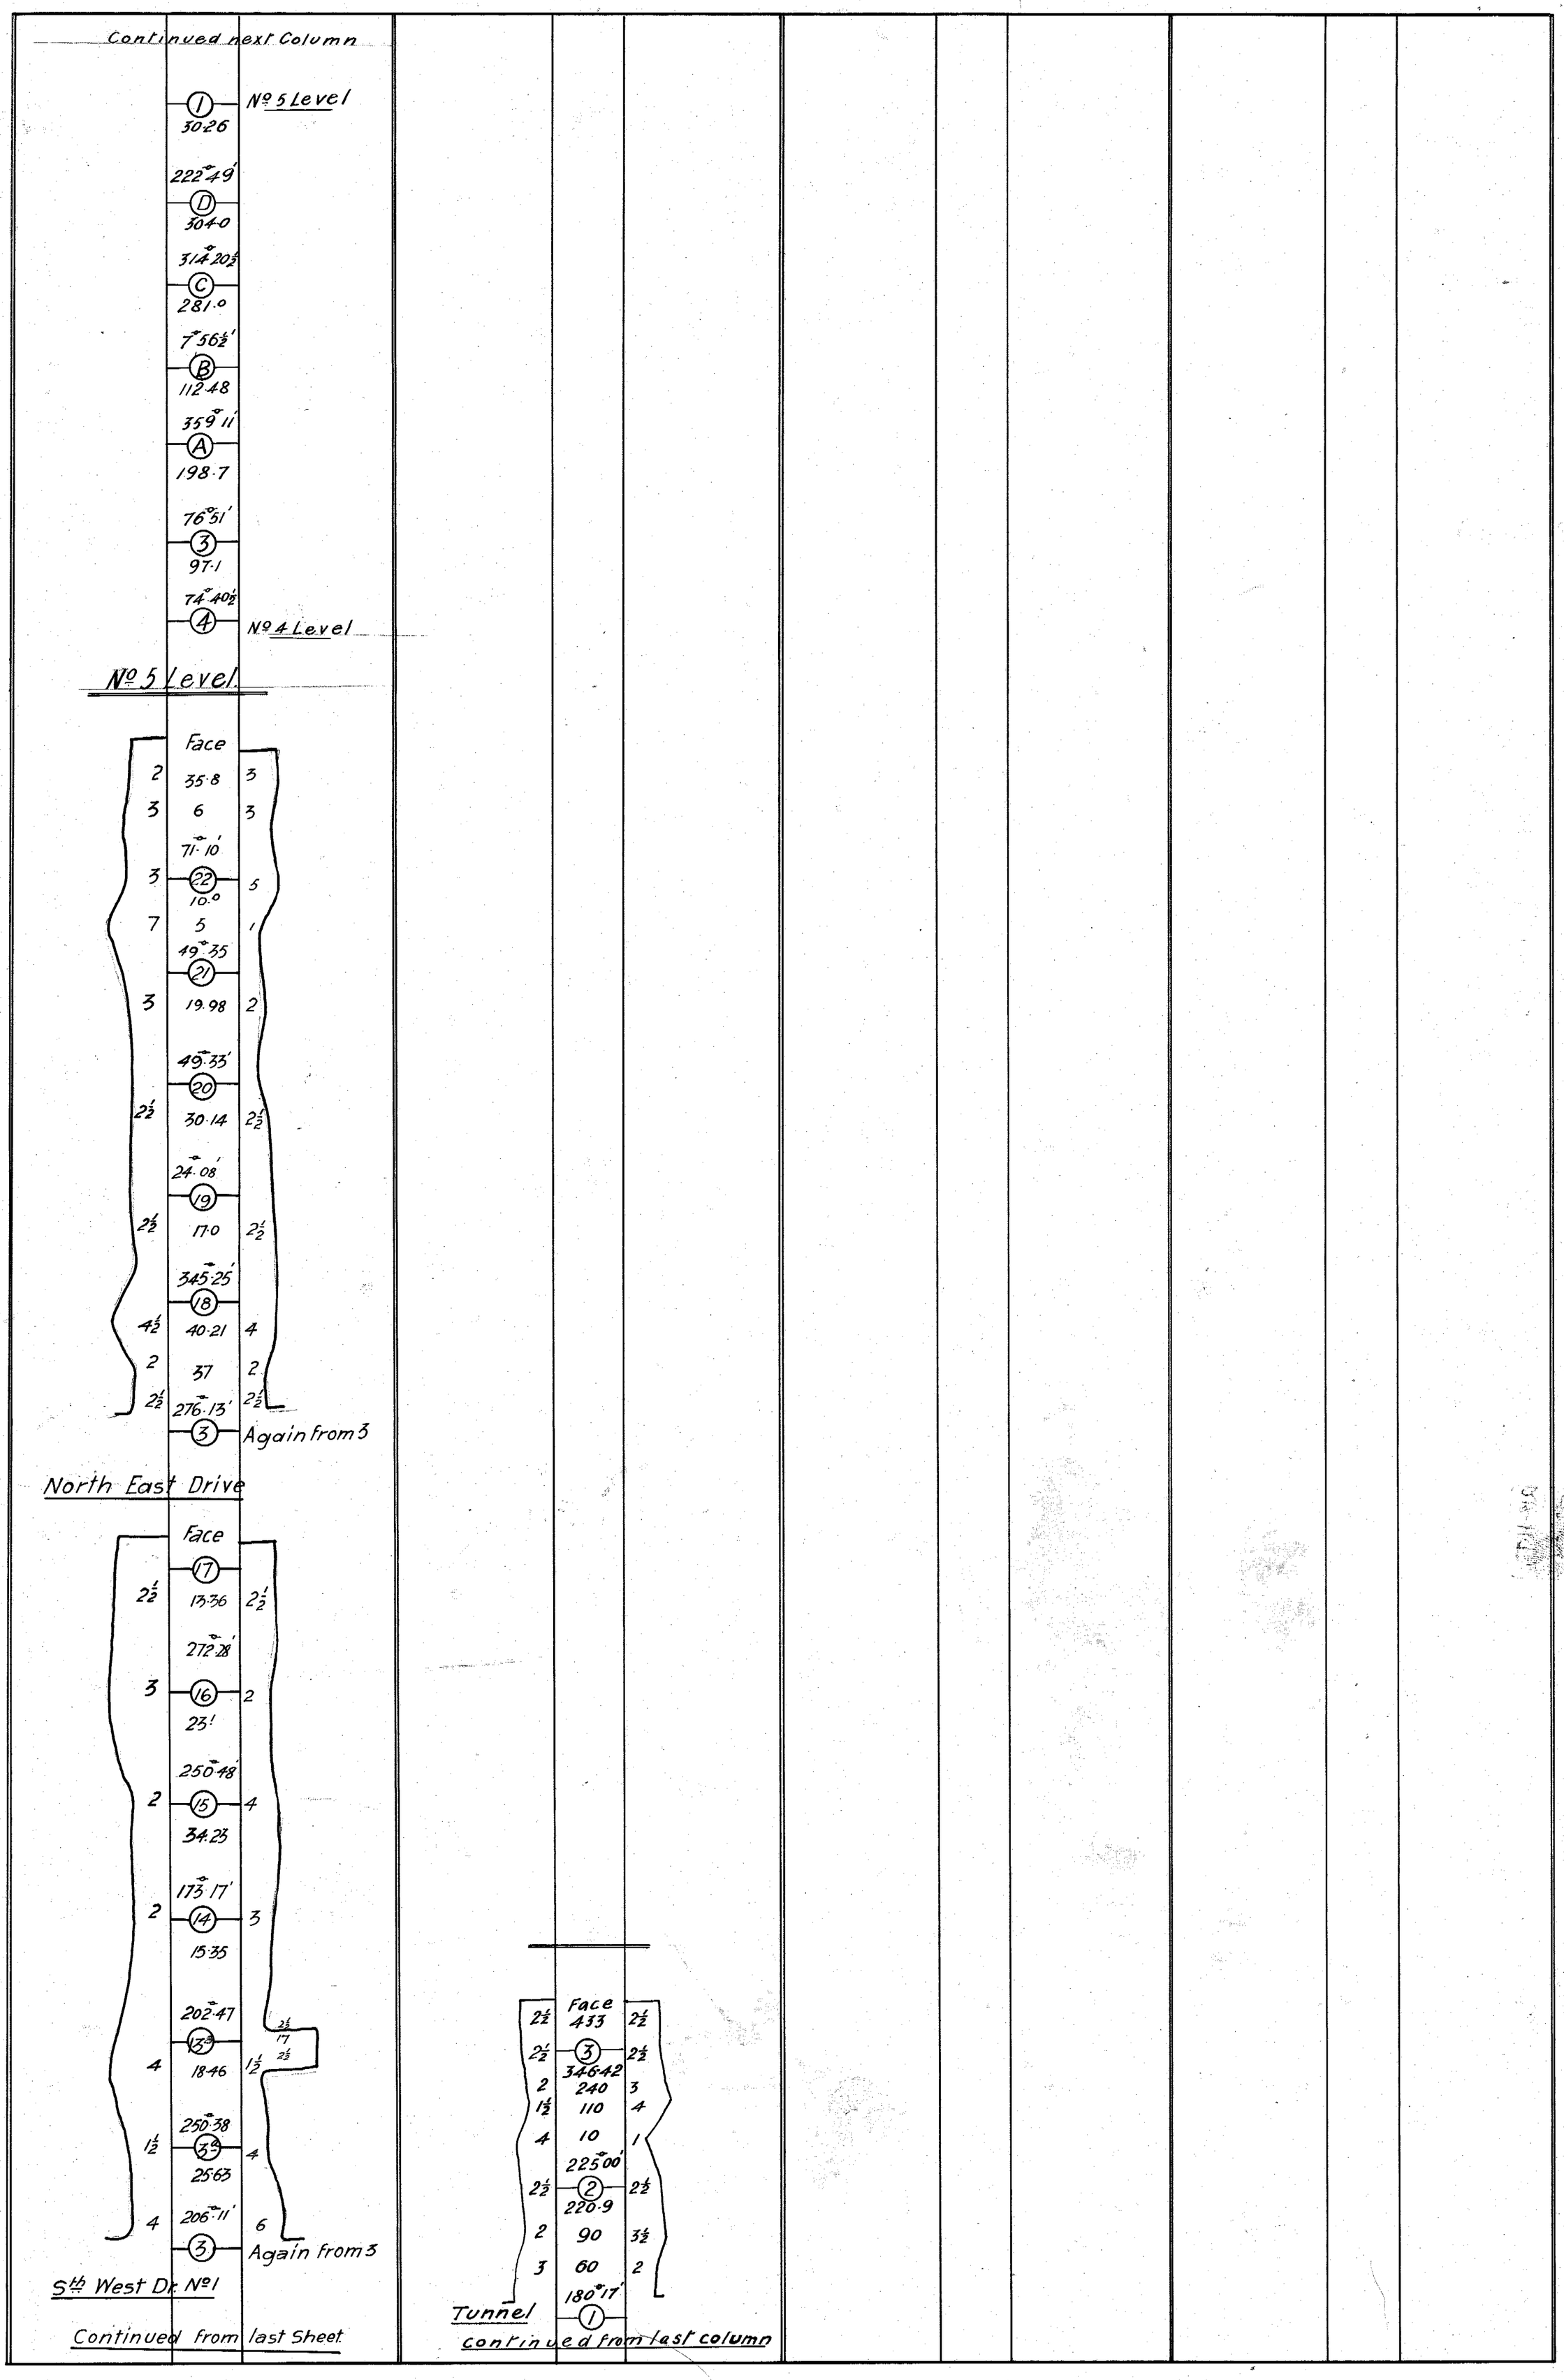
Instrument used 5" Theodolite.