The Mount Lyell Mining & Railway Co. Ltd.

Mine Department.

SHEET No 3.

Field Notes of Underground Workings up to 31.12.13.

Instrument used 5" Theodolite.
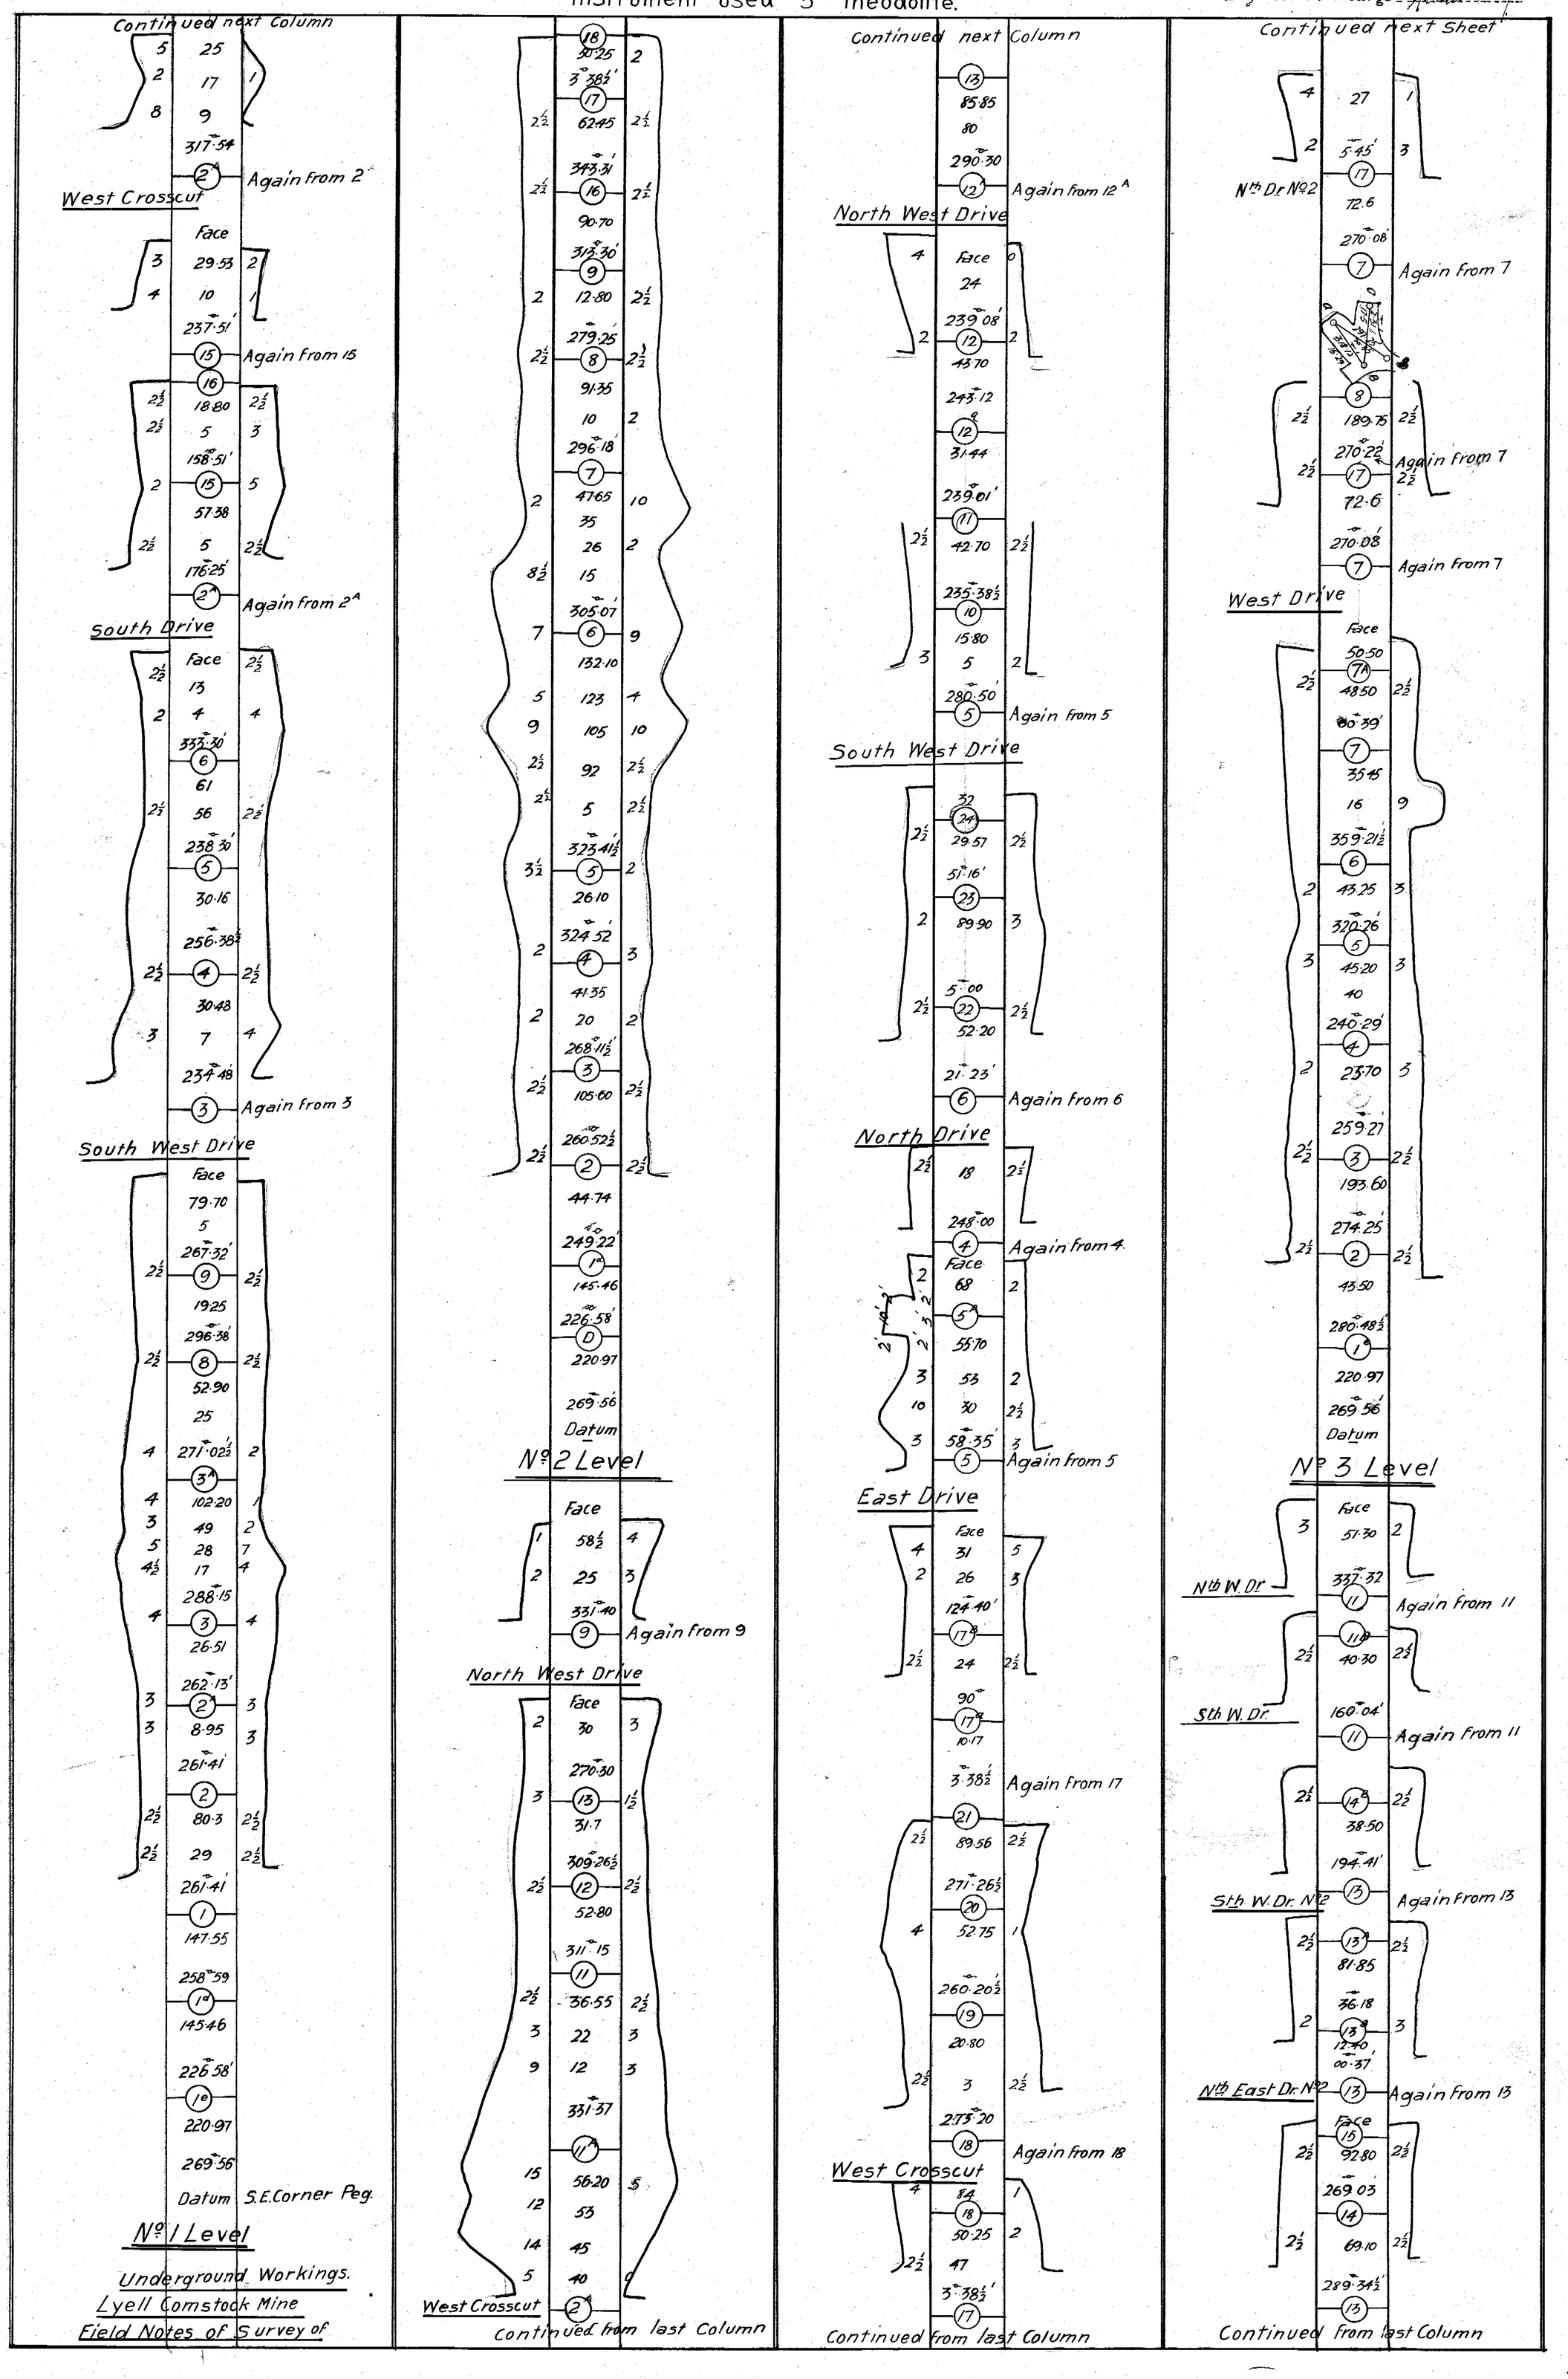
Local Supert.
Engineer-in-Charge