The Mount Lyell Mining & Railway Co., Ltd.

Mine Department.

SHEET No. 1.

Field Notes of Underground Workings up to Dec. 31st 1910.
Instrument used : 5" Theodolite.
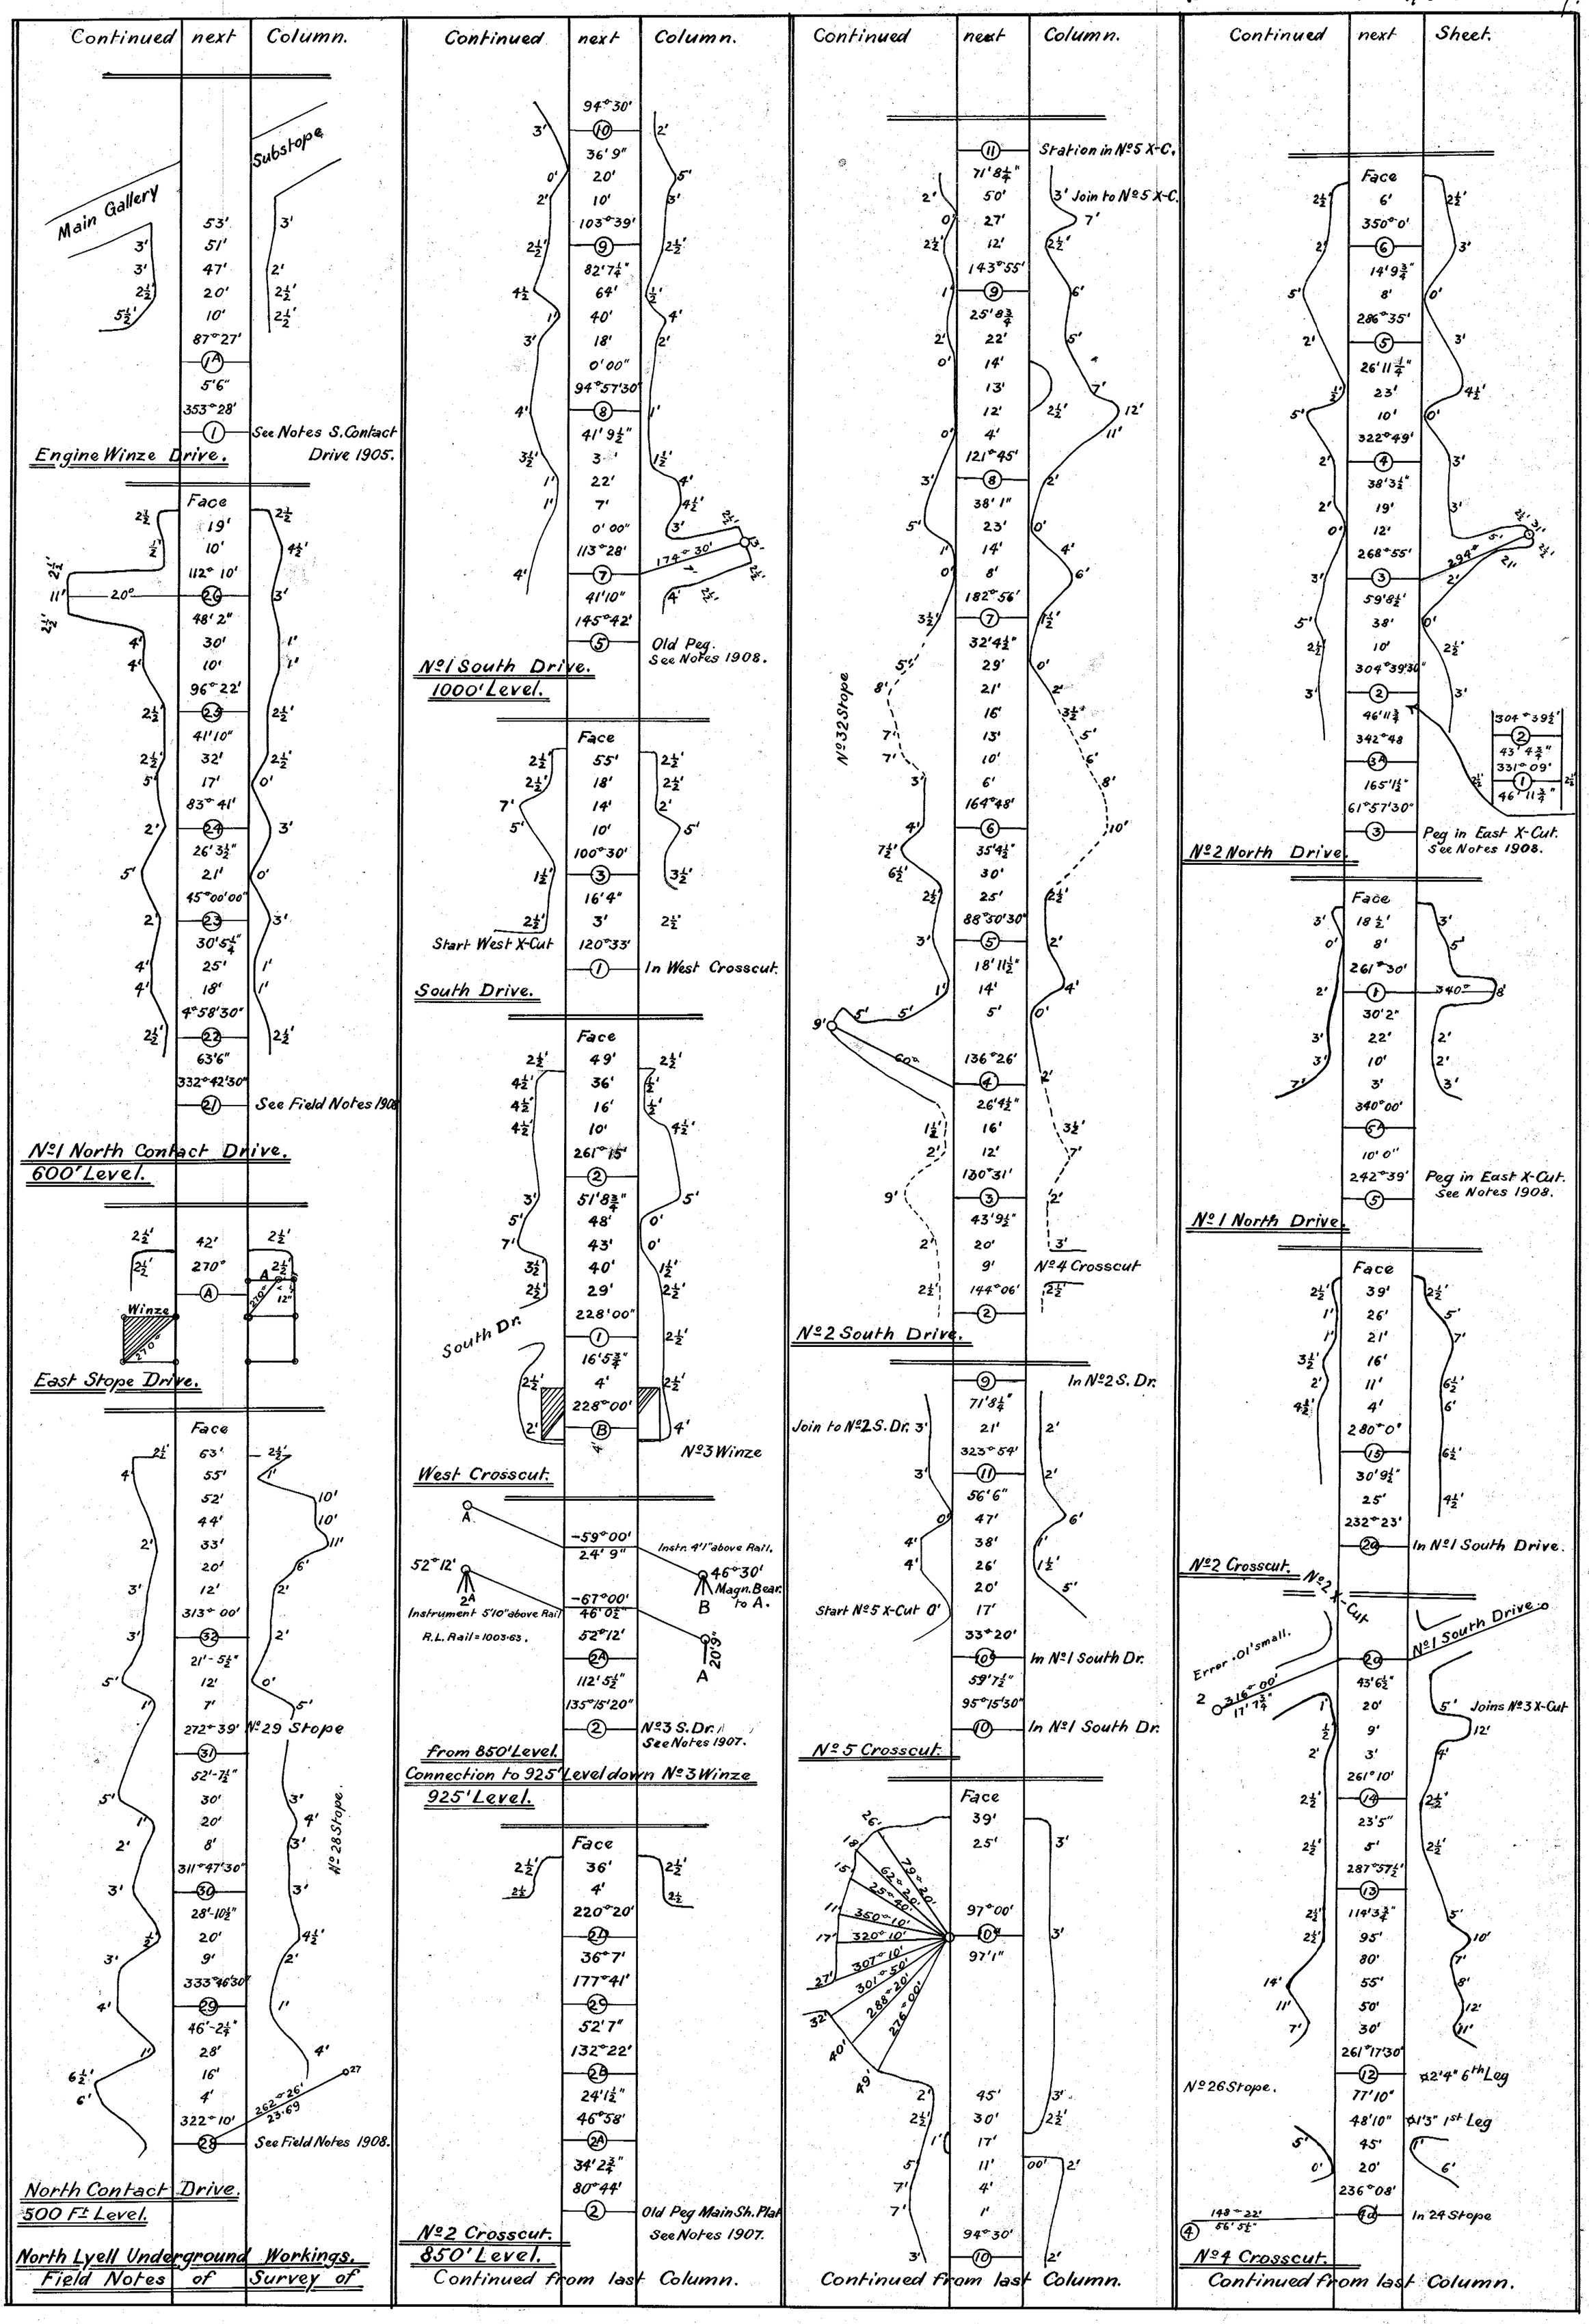
General Manager. Robt. Hecht
Engineer-in-Charge. A. McMurray.