218
-208

5 cm

The Mount Lyell Mining & Railway Co., Ltd.

SHEET No. 2

Mine Department.

Field Notes of Underground Workings up to Dec. 31st 1904

Instrument used 5" Theodolite

Genl. Manager Robt Sticht
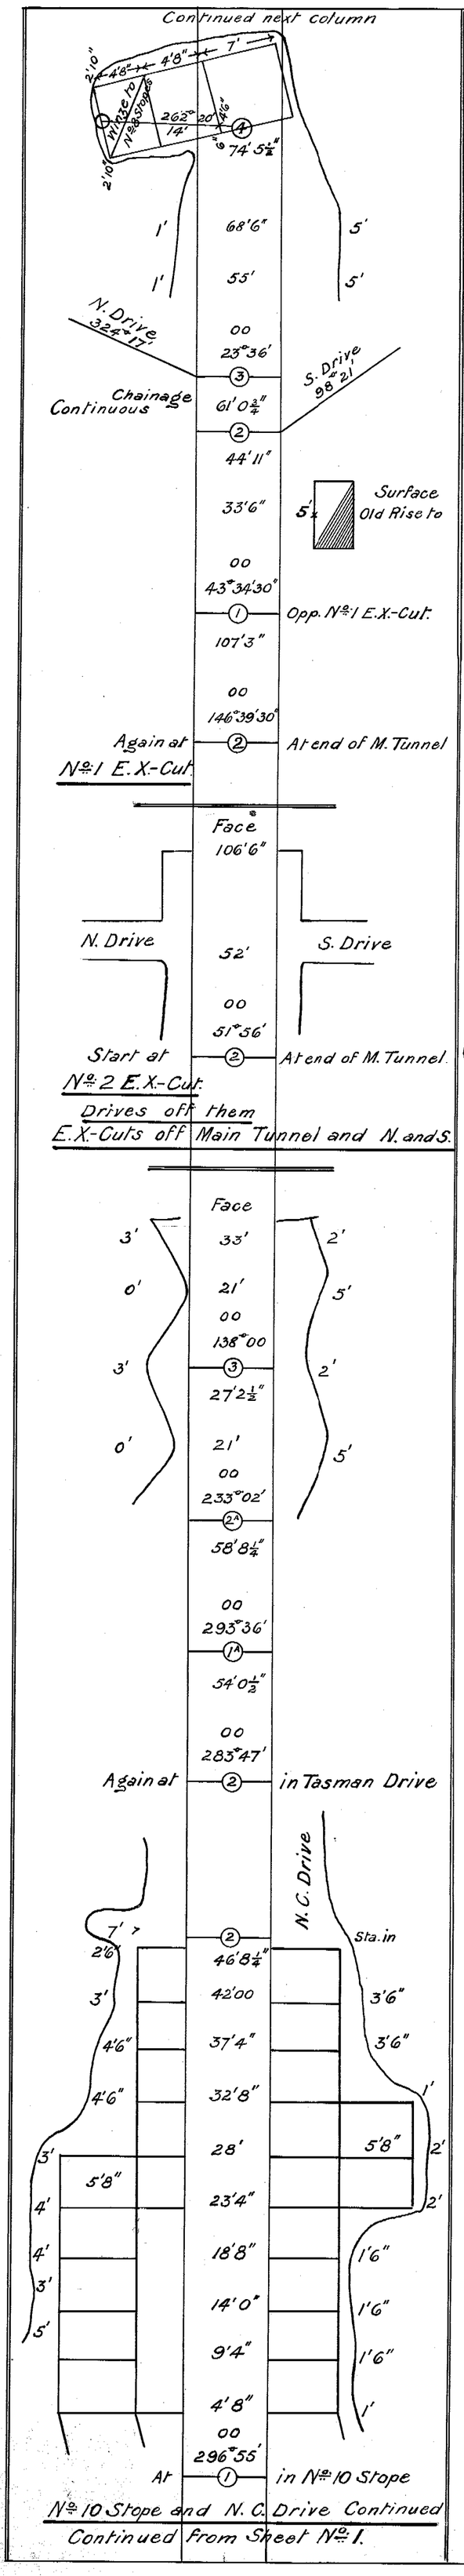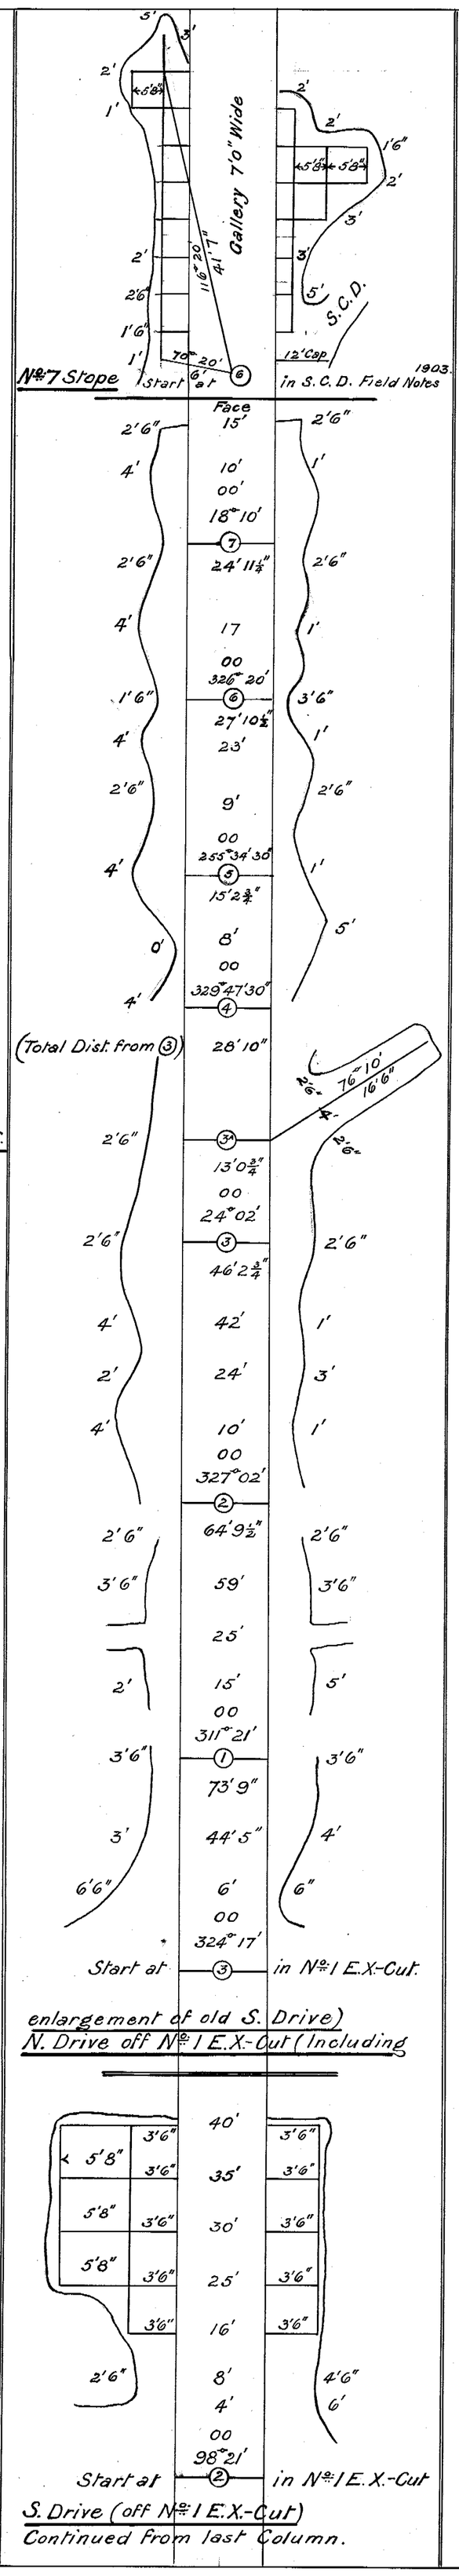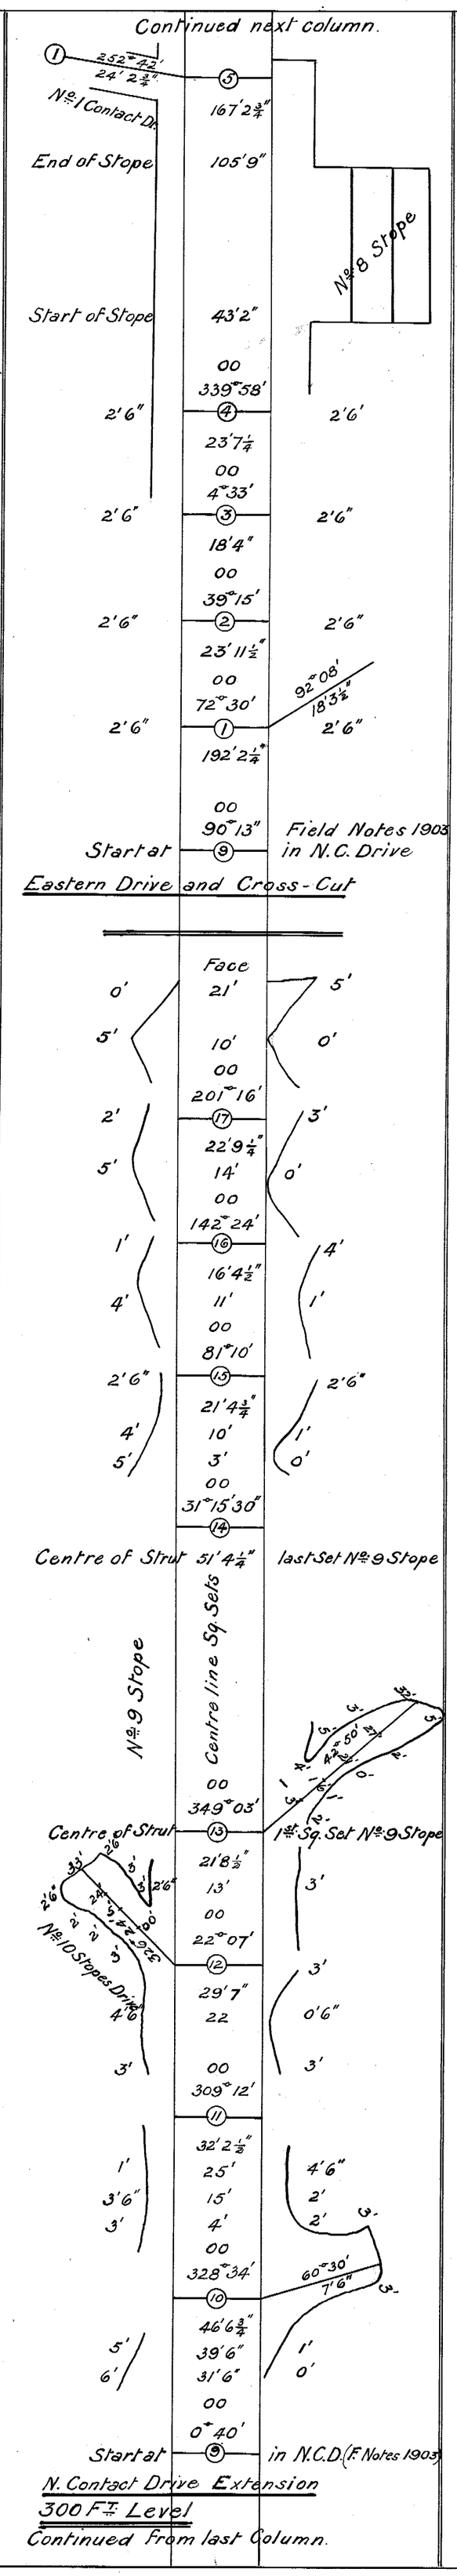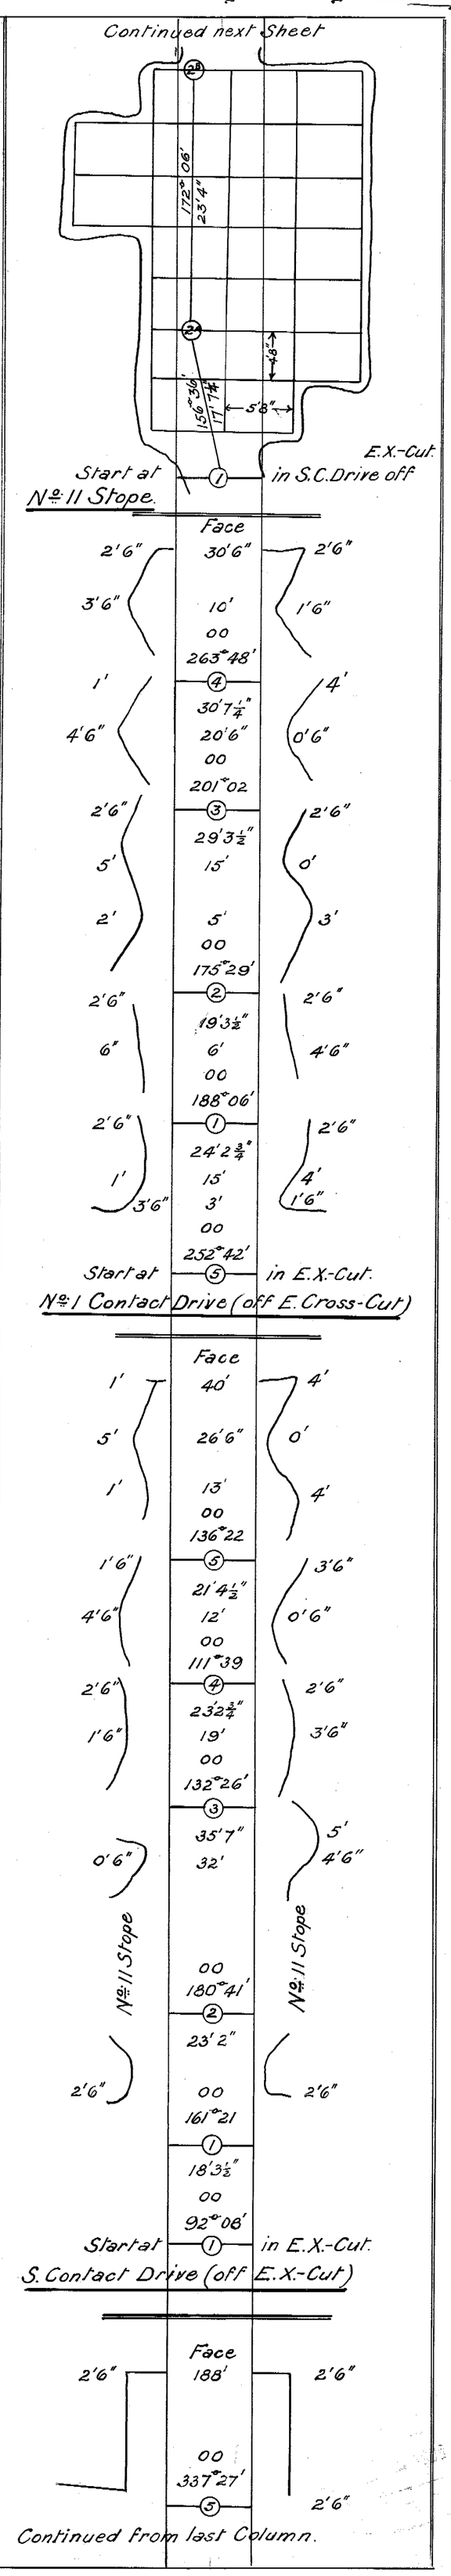
Engineer in Charge W. F. Batchelor