The Mount Lyell Mining & Railway Co., Ltd.

Mine Department.

SHEET N° 2

Field Notes of Underground Workings up to Dec 31st 1908
Instrument used 5" Theodolite.
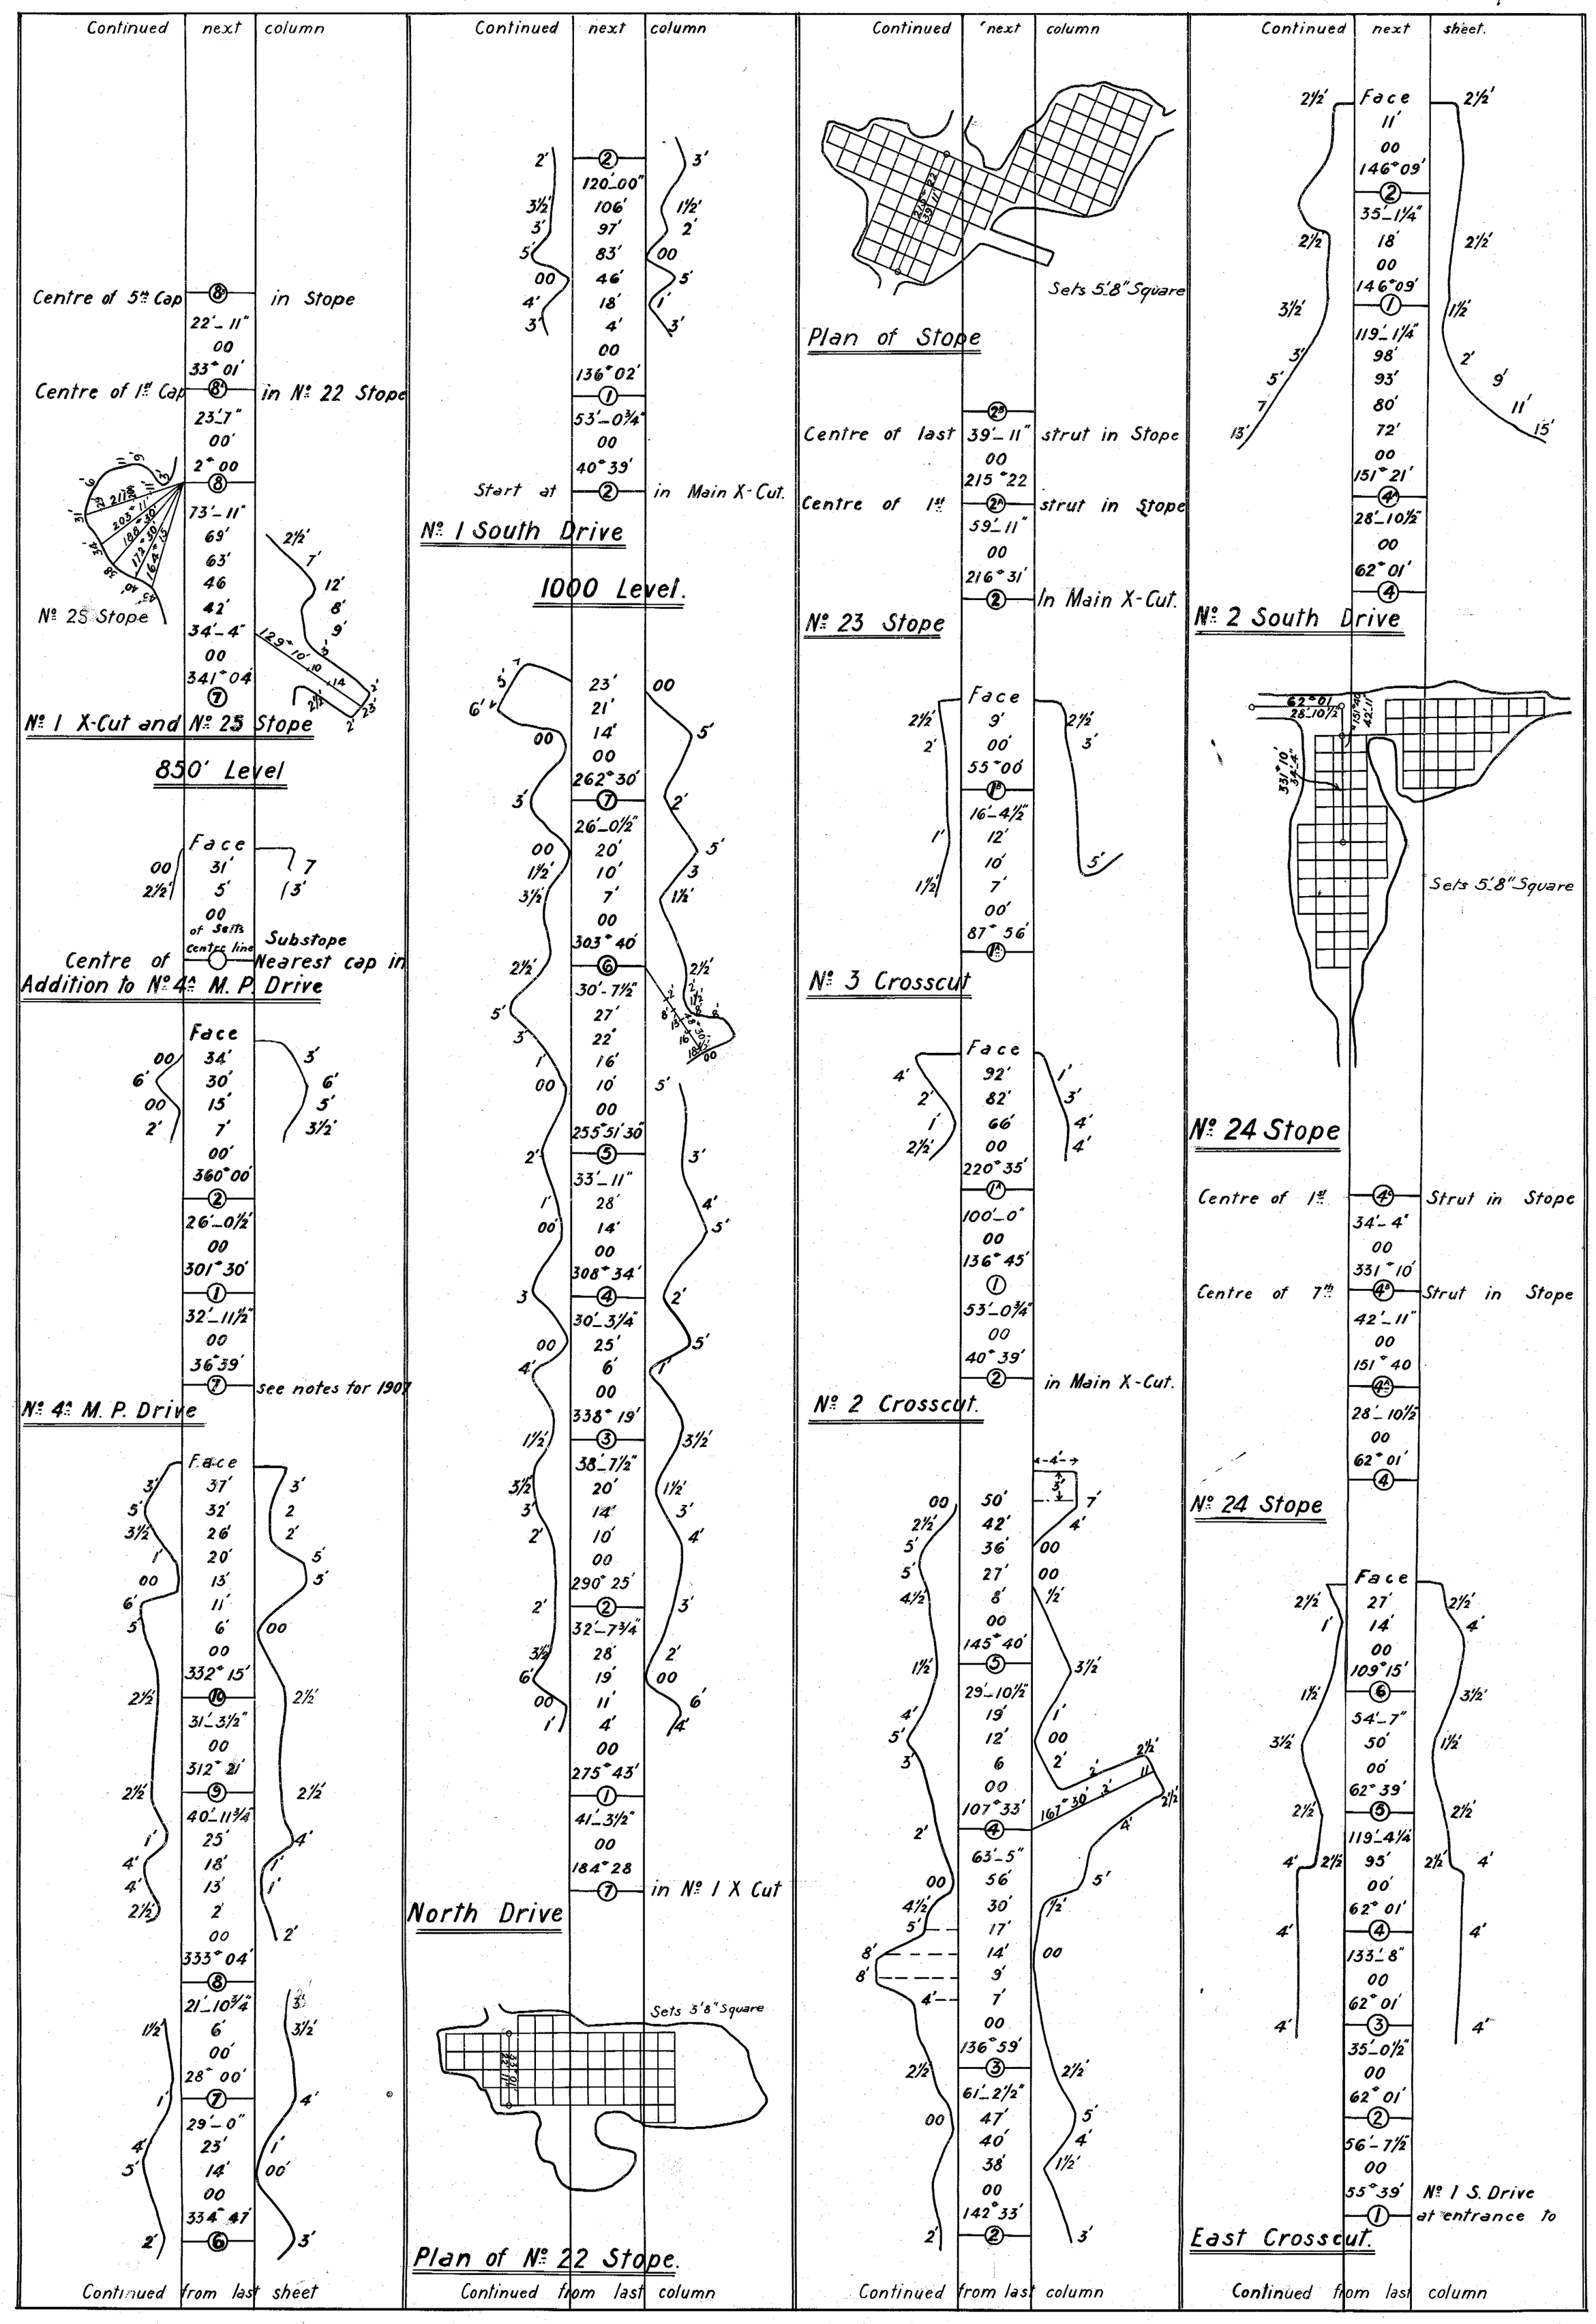
Gen. Manager ..... Robt Sticht
Engineer-in-Charge ..... A. W. Murray