The Mount Lyell Mining & Railway Co., Ltd.

Mine Department.

Field Notes of Underground Workings up to Dec. 31st 1905.

Instrument used – 5" Theodolite

SHEET No. 2

MT. LYELL M. & RY. CO. LTD. ENGINEER'S OFFICE FEB 6 1906 MINING DEPT.

Genl. Manager. Robert Hunt
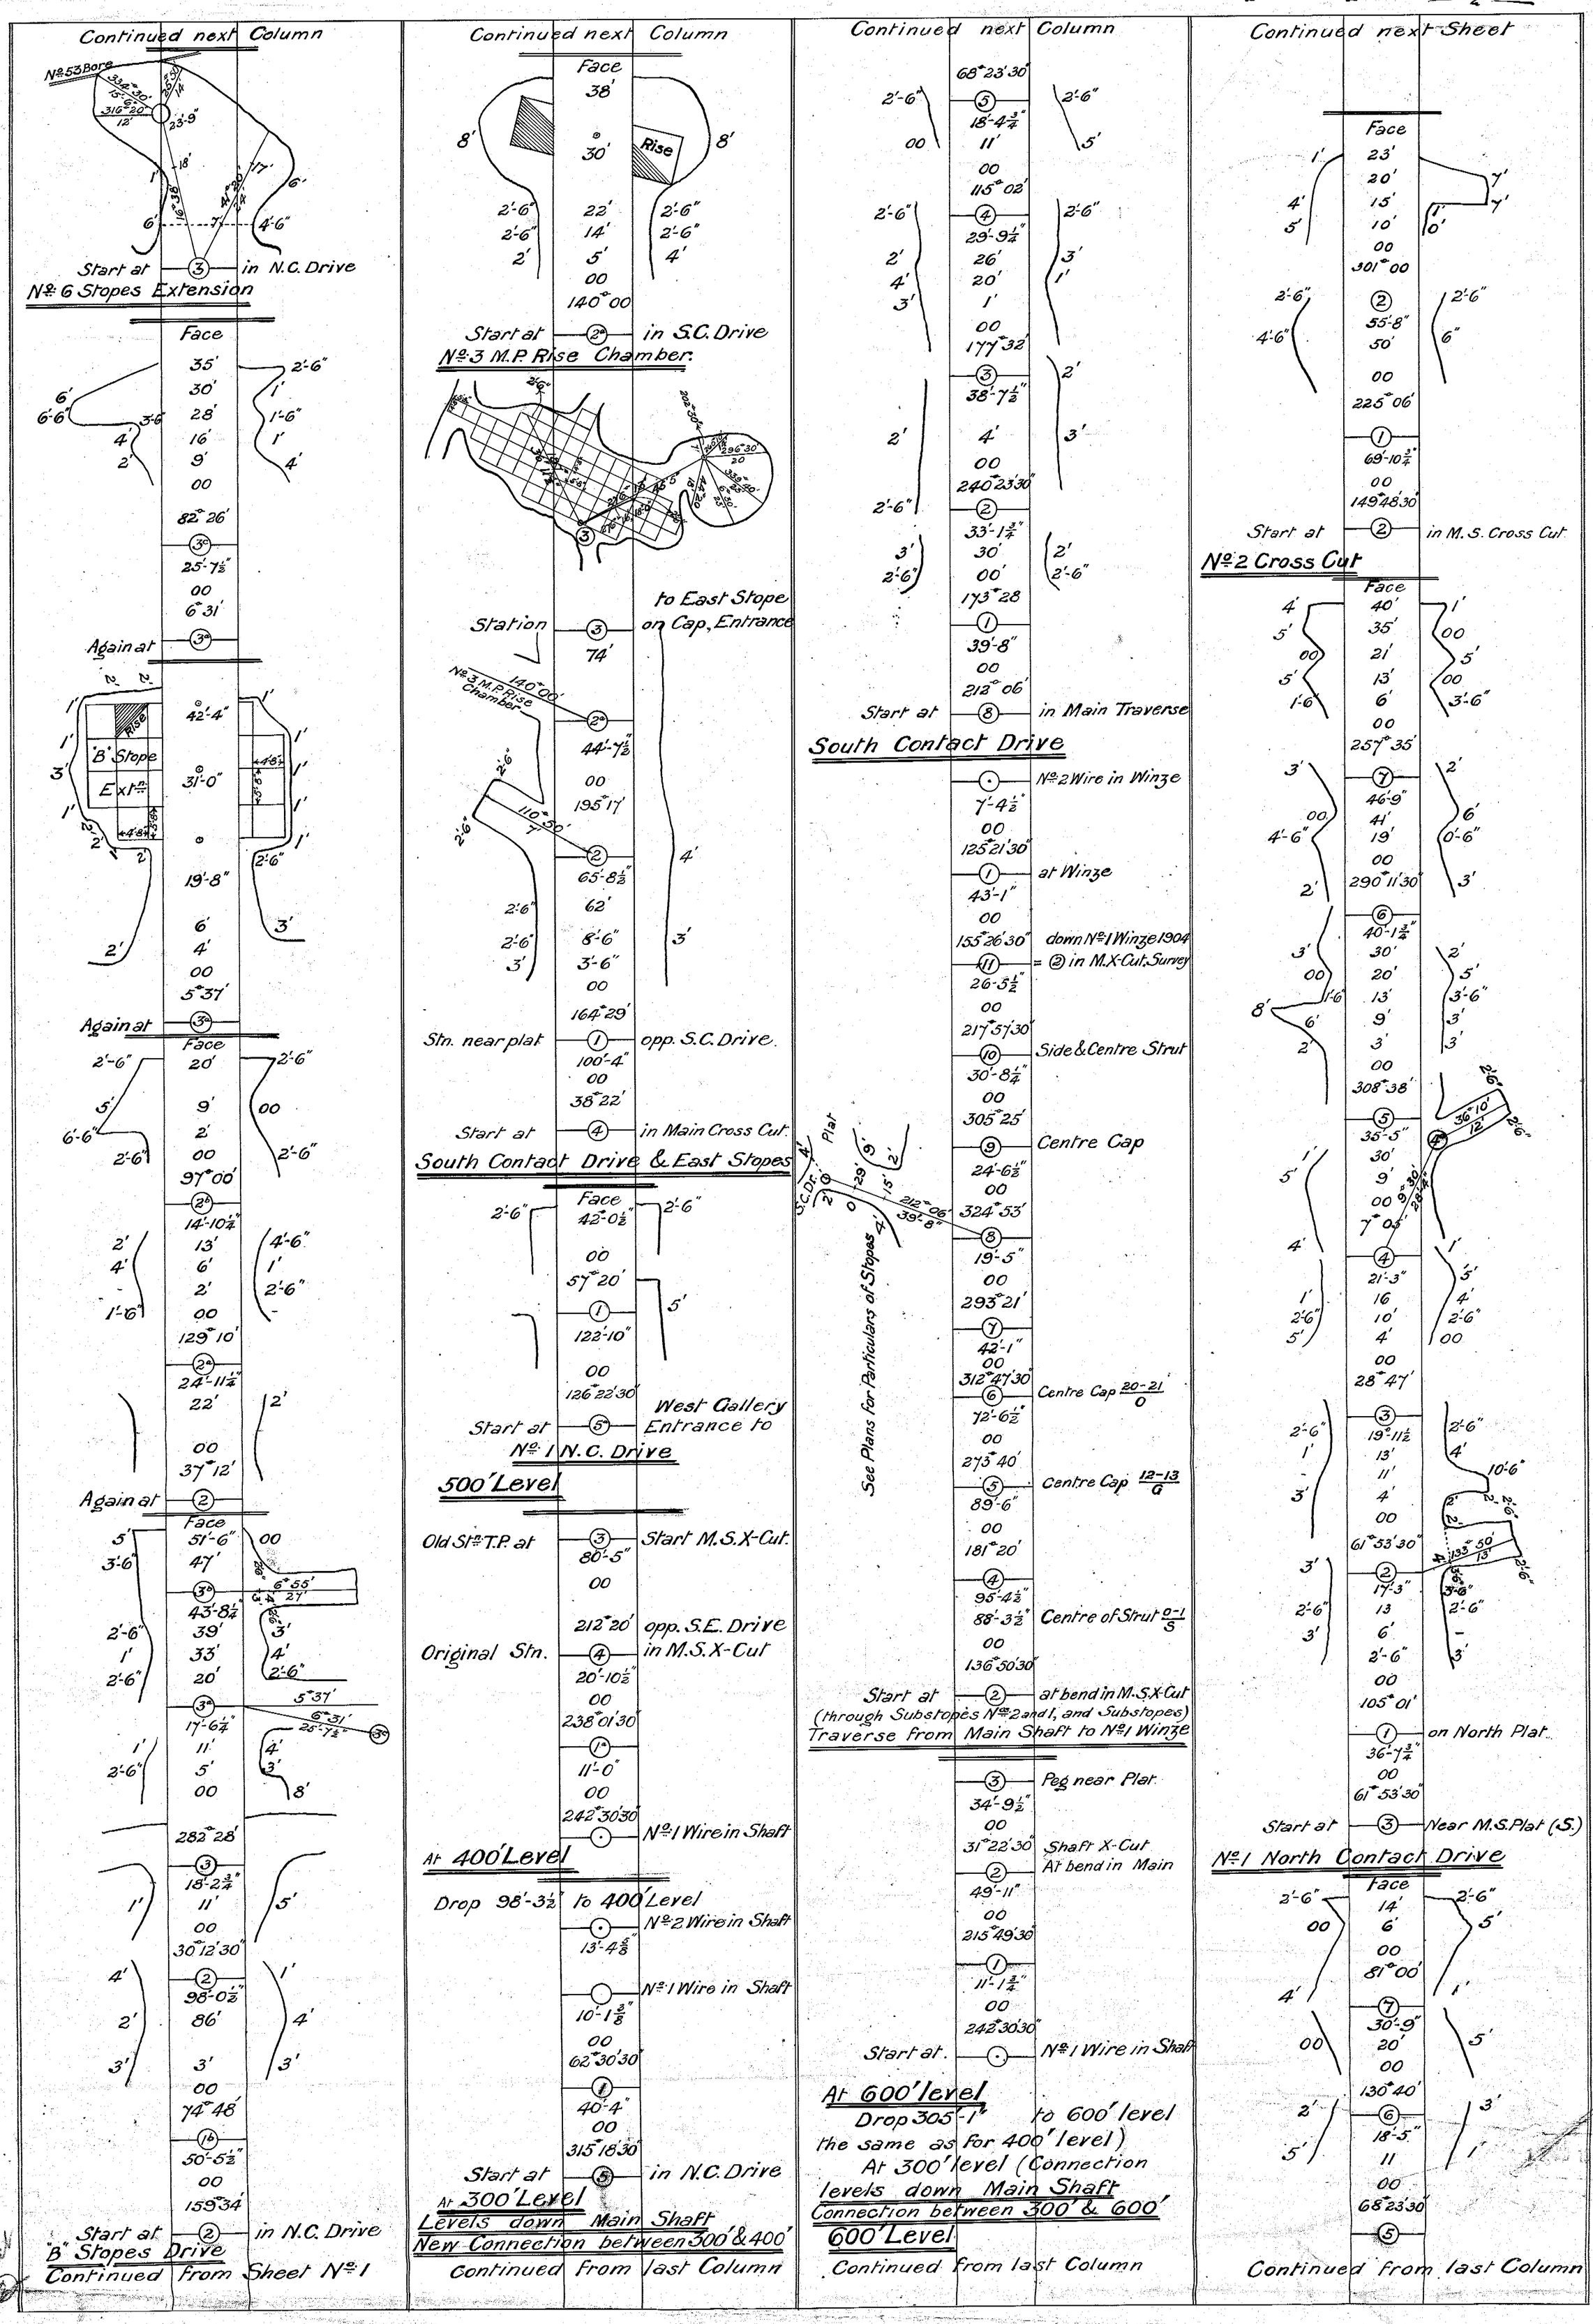
Engineer-in-Charge. W. F. Hatchett