EAST TASMANIA G.M.

Scale 25 ft to an inch.

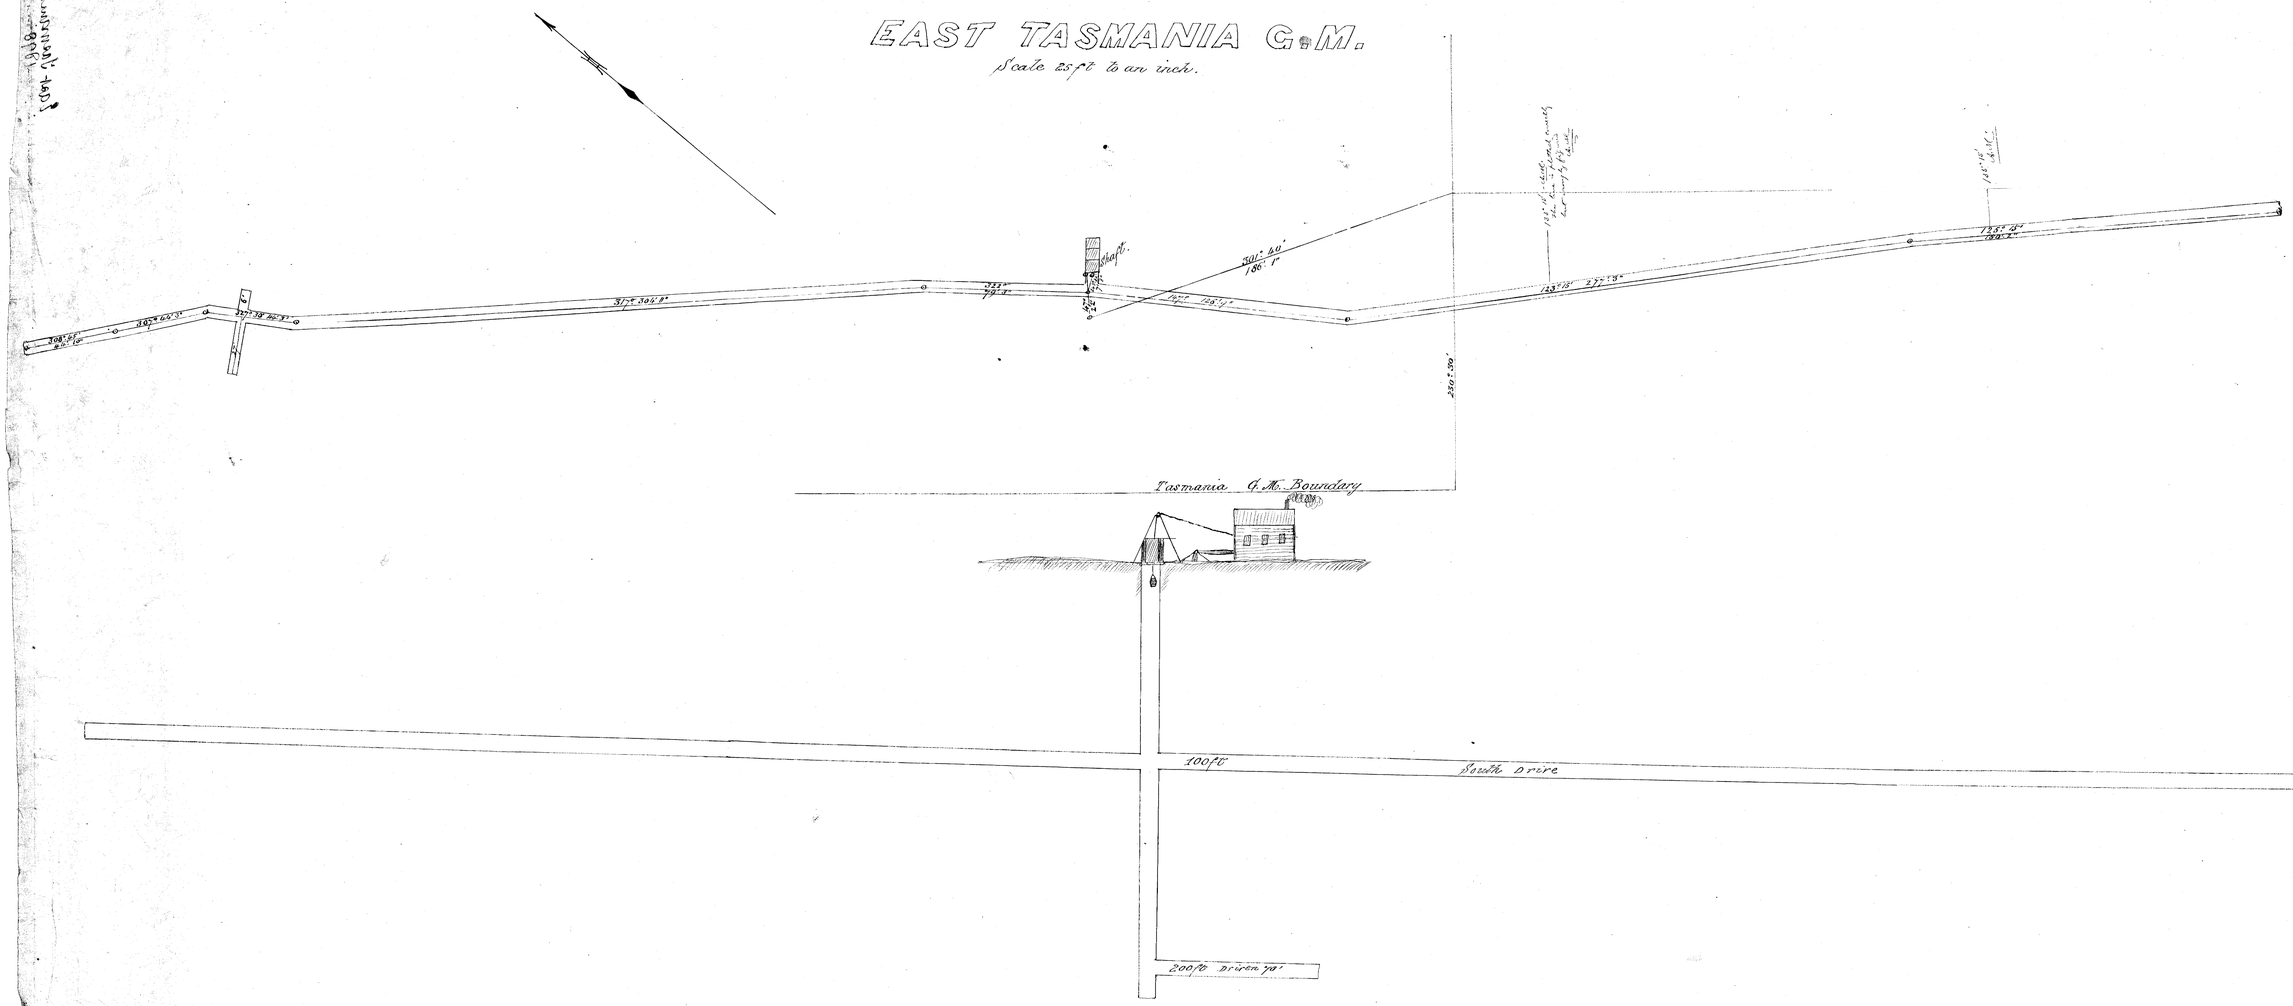

219-02

Certified extract copy of plan of above mine as seen on the withdrawal of Tas. G.M. year 1890
Bradley Battery
Mining Surveyor
R.T. Pike