220-01

220-01

PLAN

of

NORTH TASMANIA G.M.

Scale 25 ft. to 1 inch

344
93 G

10 ac.

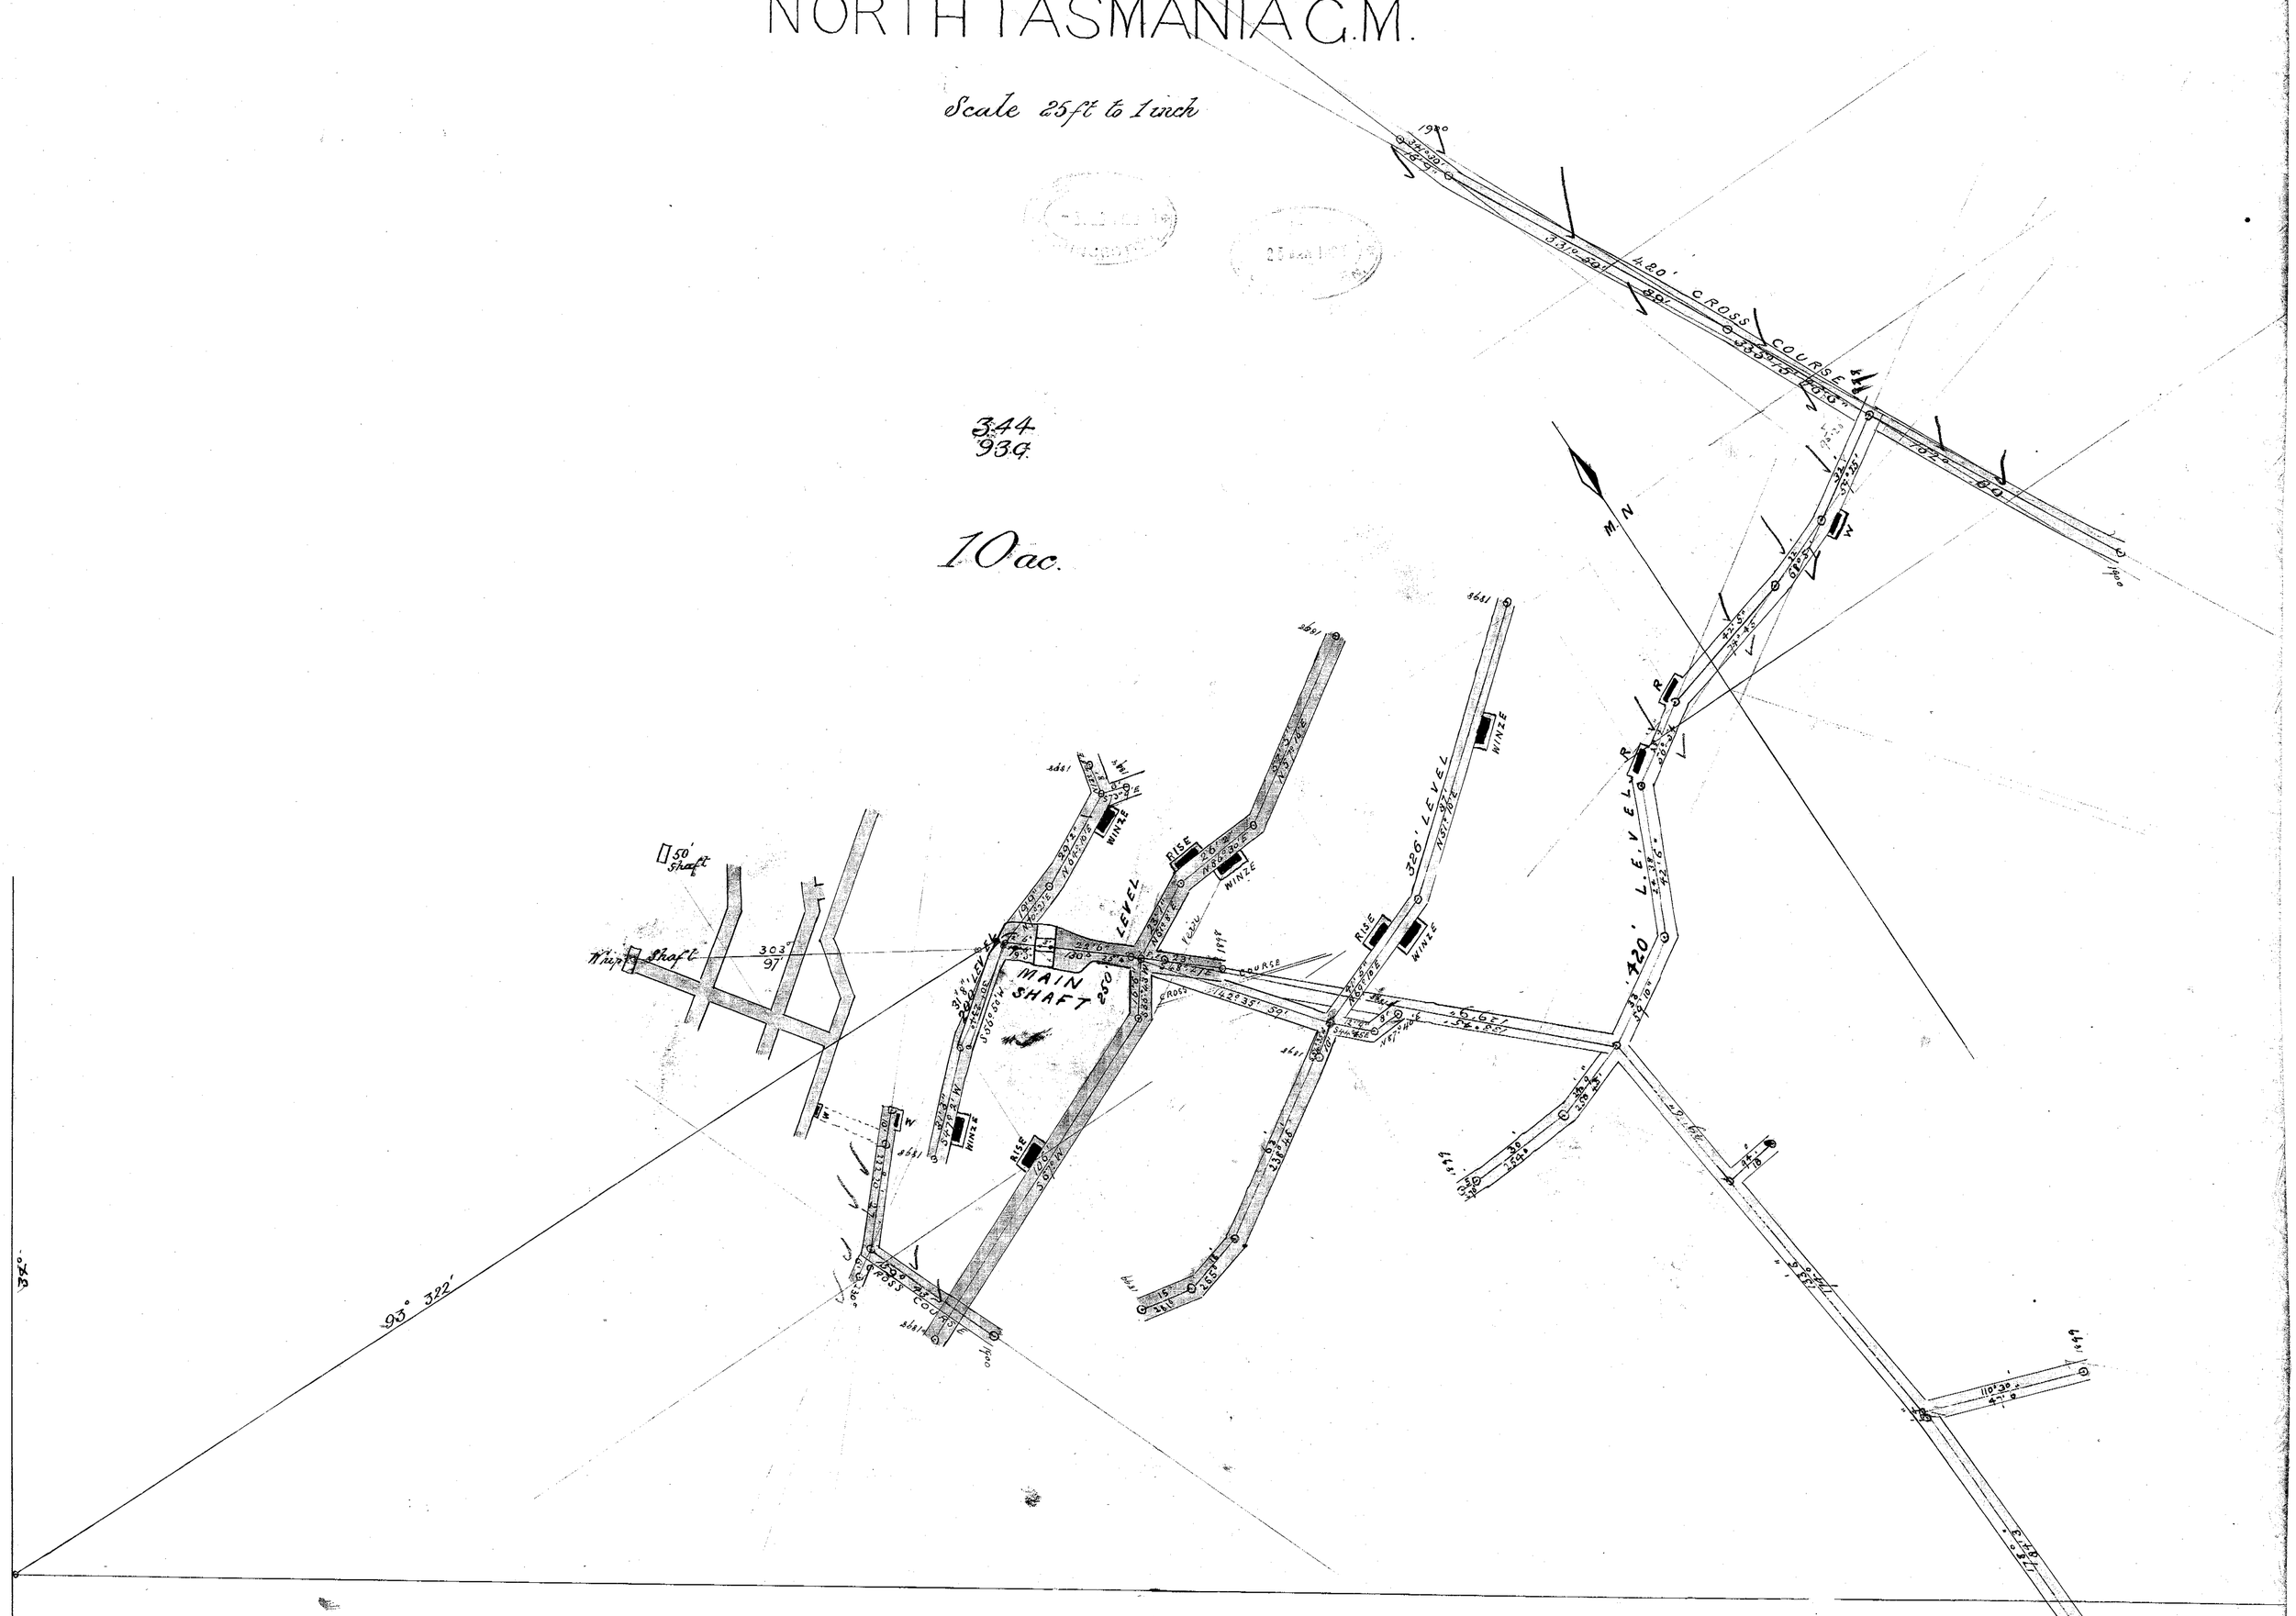

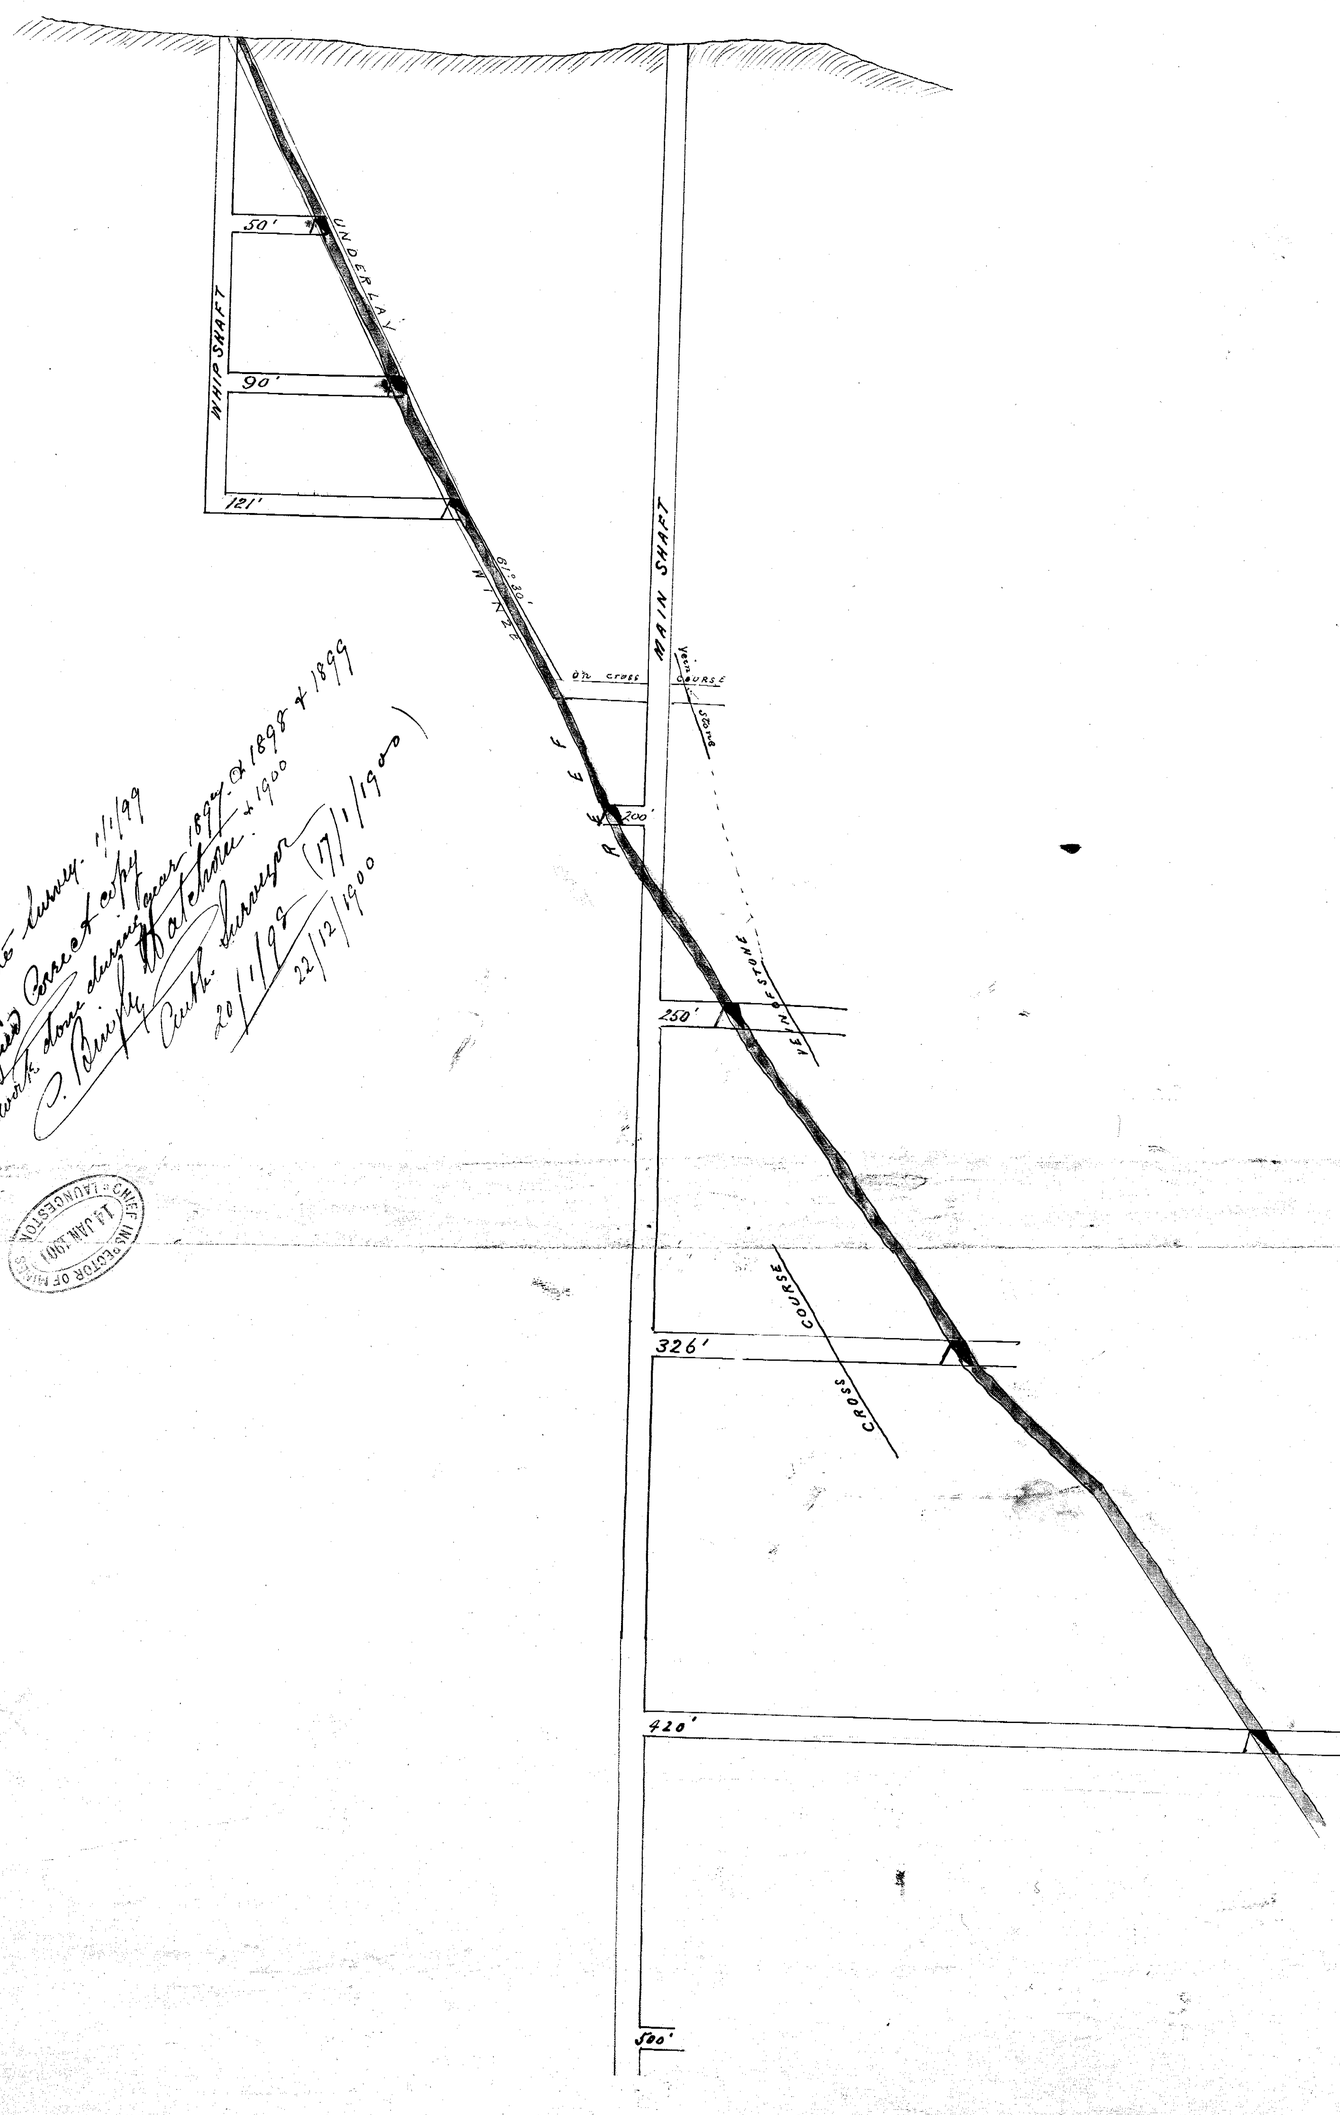

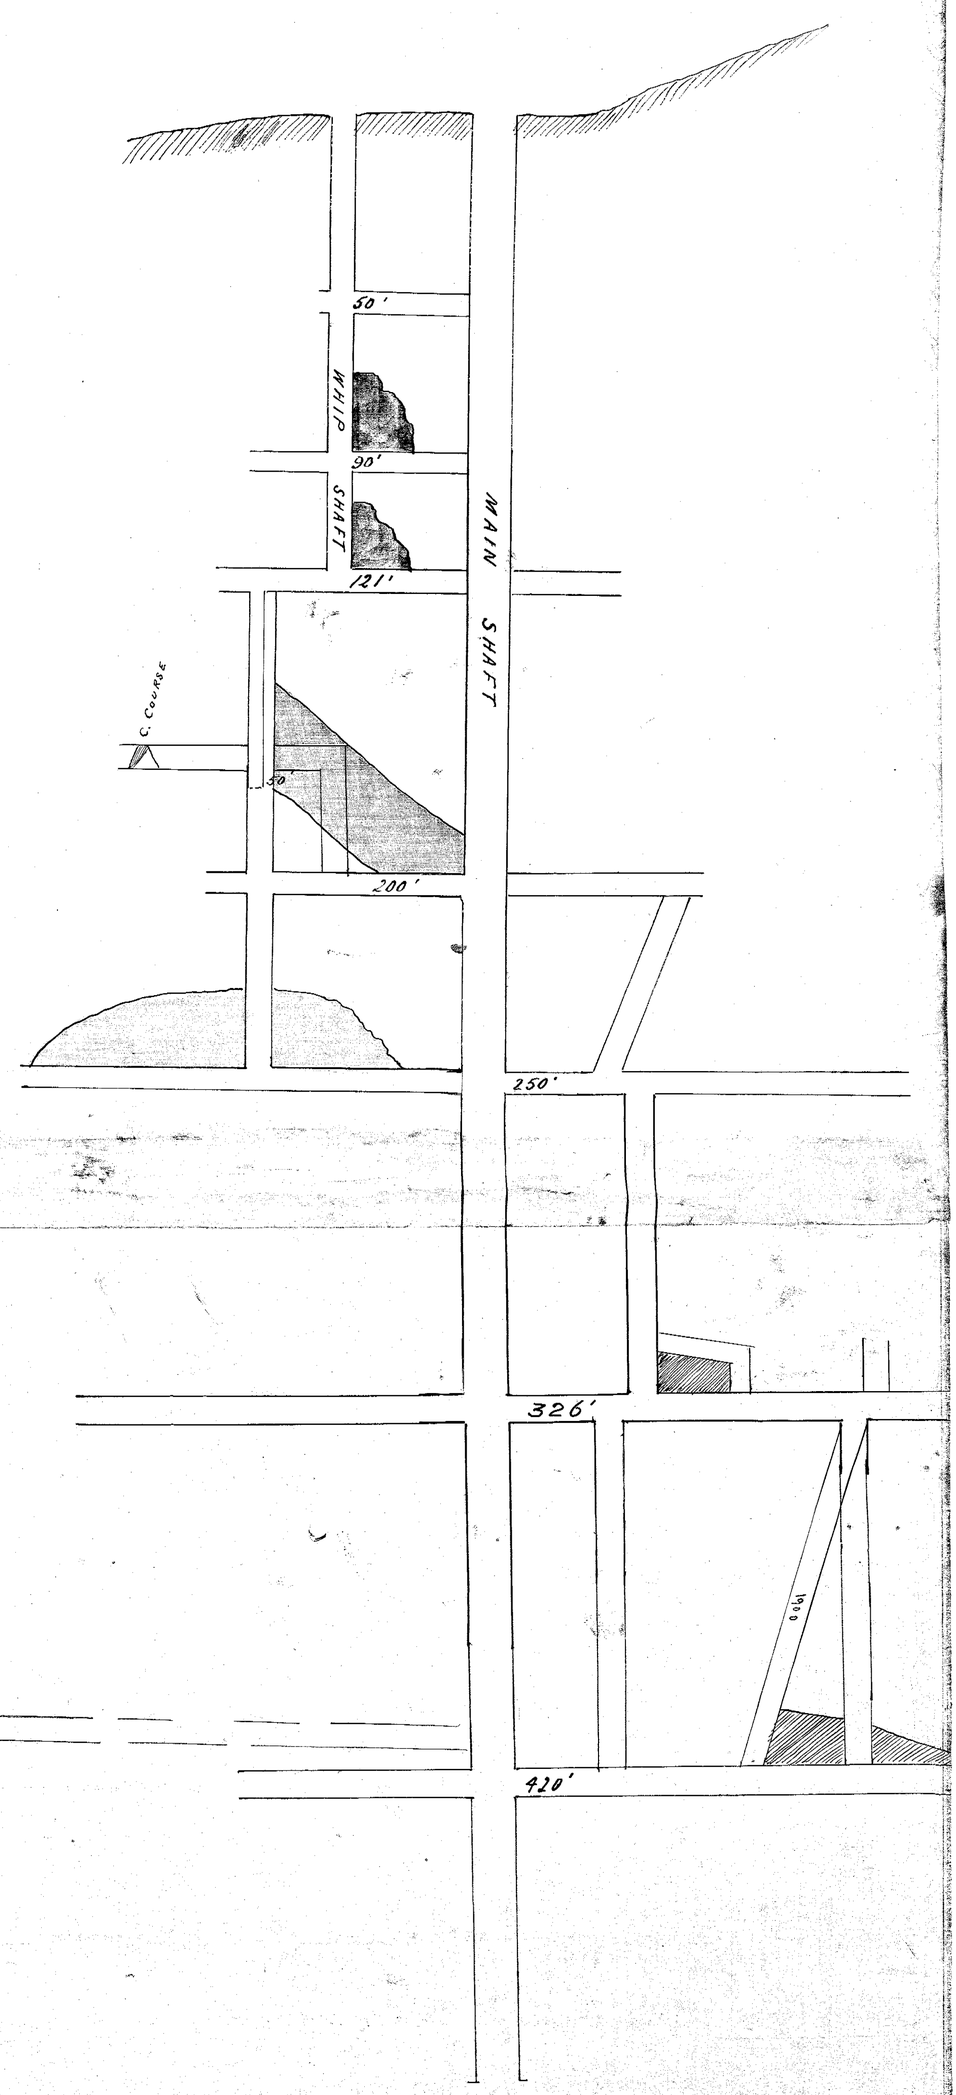


MINES DEPARTMENT
LAUNCESTON