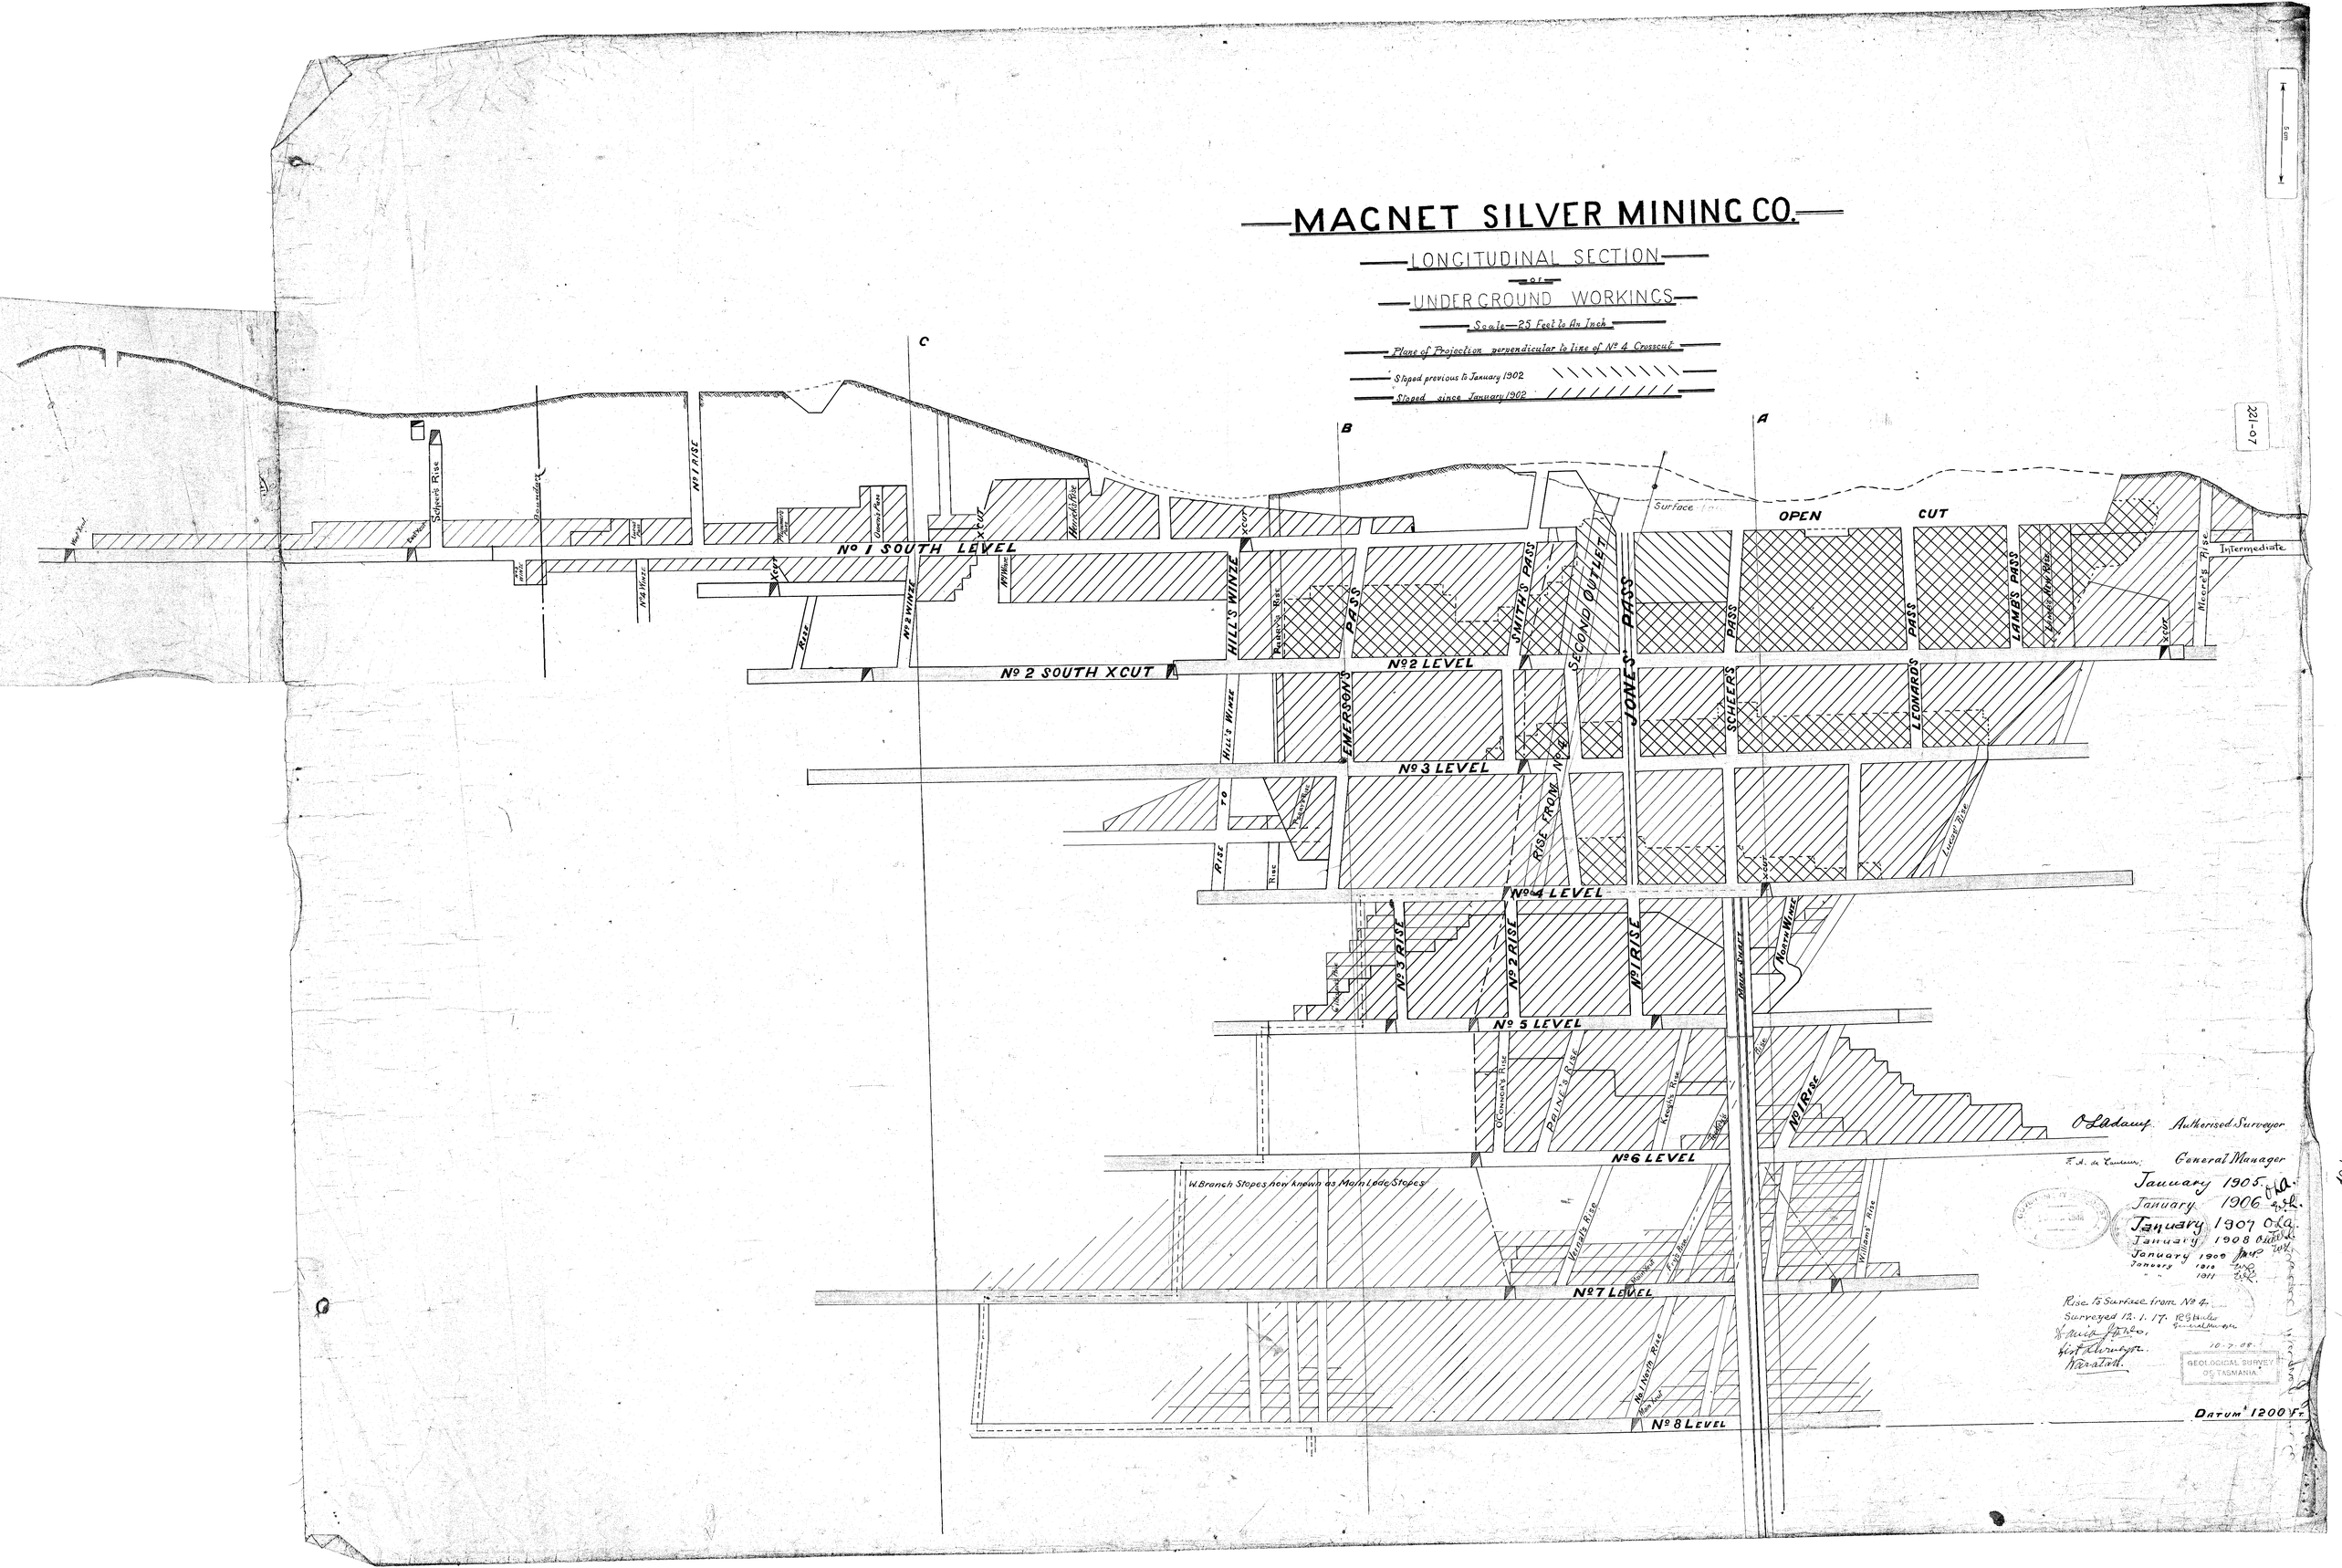
MAGNET SILVER MINING CO.
LONGITUDINAL SECTION
OF
UNDERGROUND WORKINGS
Scale—25 Feet to An Inch
Plane of Projection perpendicular to line of No 4 Crosscut
Stoped previous to January 1902
Stoped since January 1902
C
B
A
Surface
OPEN CUT
No 1 SOUTH LEVEL
No 2 SOUTH XCUT
No 2 LEVEL
No 3 LEVEL
No 4 LEVEL
No 5 LEVEL
No 6 LEVEL
No 7 LEVEL
No 8 LEVEL
Schern's Rise
No 1 RISE
No 2 WINZE
HILL'S WINZE
EMERSON'S PASS
SMITH'S PASS
SECOND OUTLET
JONES' PASS
SCHEERS PASS
LEONARDS PASS
LAMBS PASS
Meece's Rise
Intermediate
RISE FROM No 4
No 3 RISE
No 2 RISE
No 1 RISE
North Winze
Main Shaft
O'Connor's Rise
Palmer's Rise
Kenny's Rise
Williams' Rise
W. Branch Stopes now known as Main Lode Stopes
Datum 1200 Ft
O Ladauf Authorised Surveyor
E. A. de Tankum General Manager
January 1905
January 1906
January 1907
January 1908
January 1909
January 1910
" 1911
Rise 15 Surface from No 4
Surveyed 12.1.17
GEOLOGICAL SURVEY OF TASMANIA
221-07