221-16
TEO
LARLE
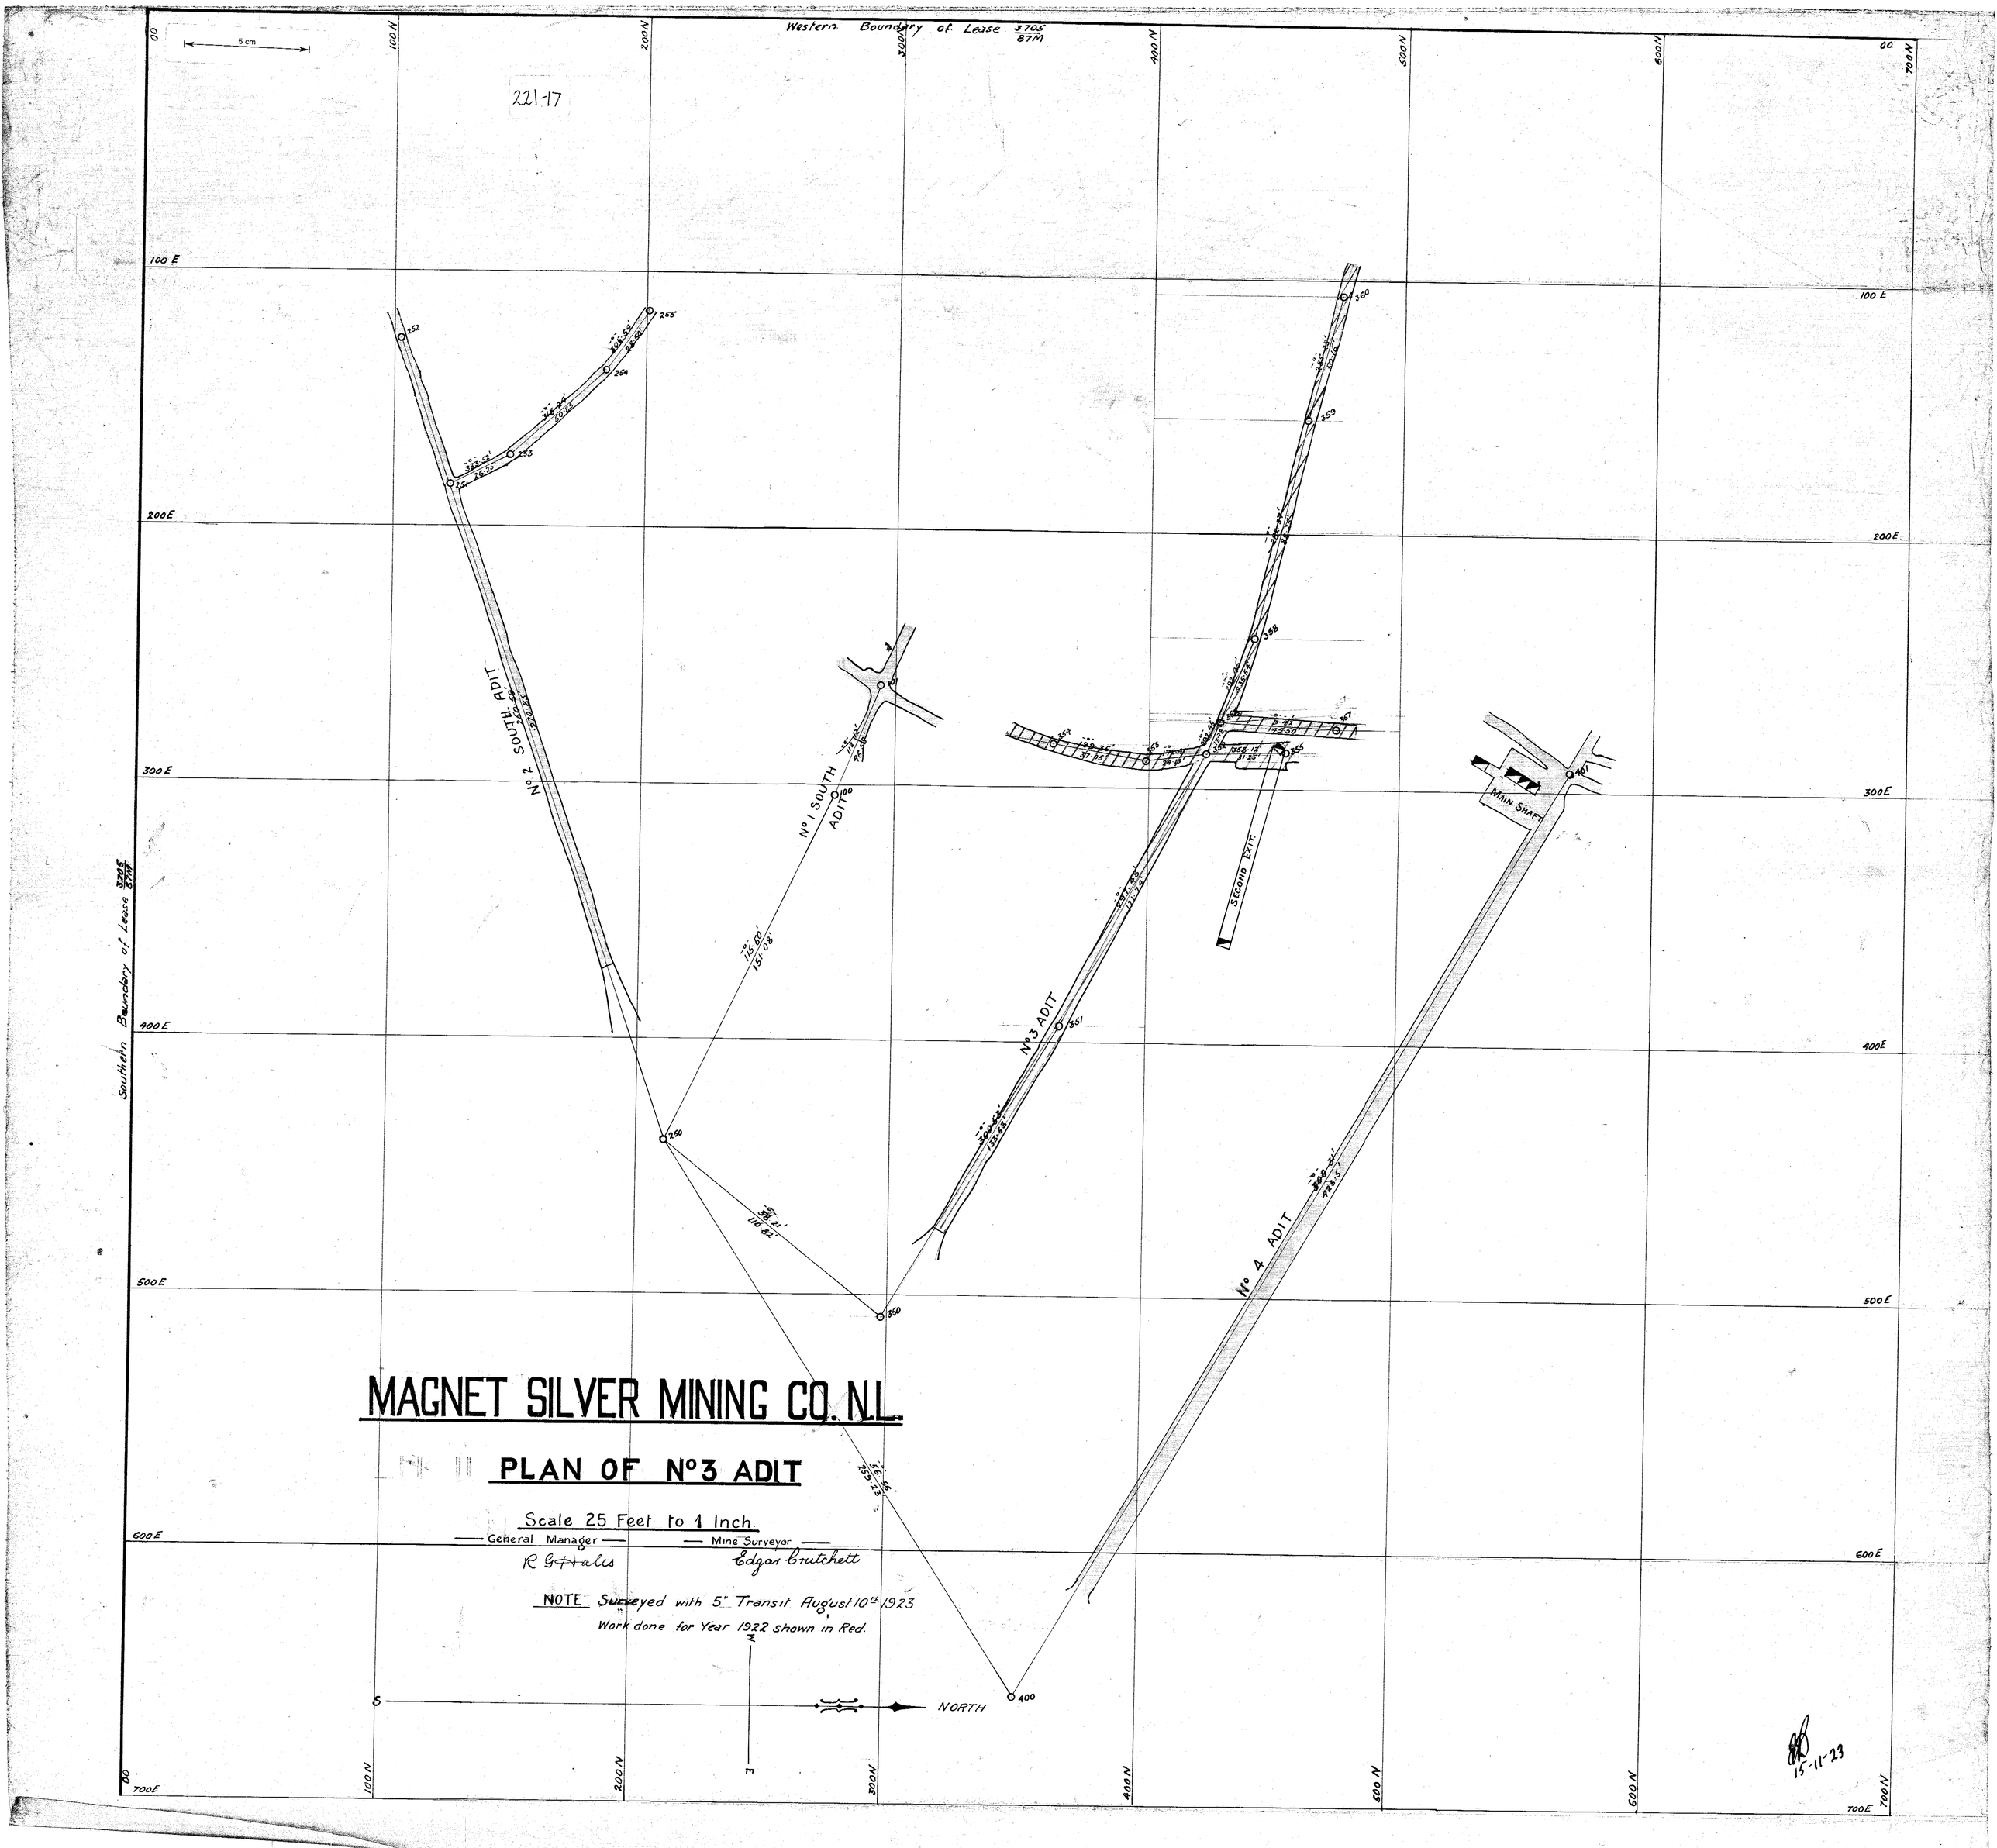
221-17