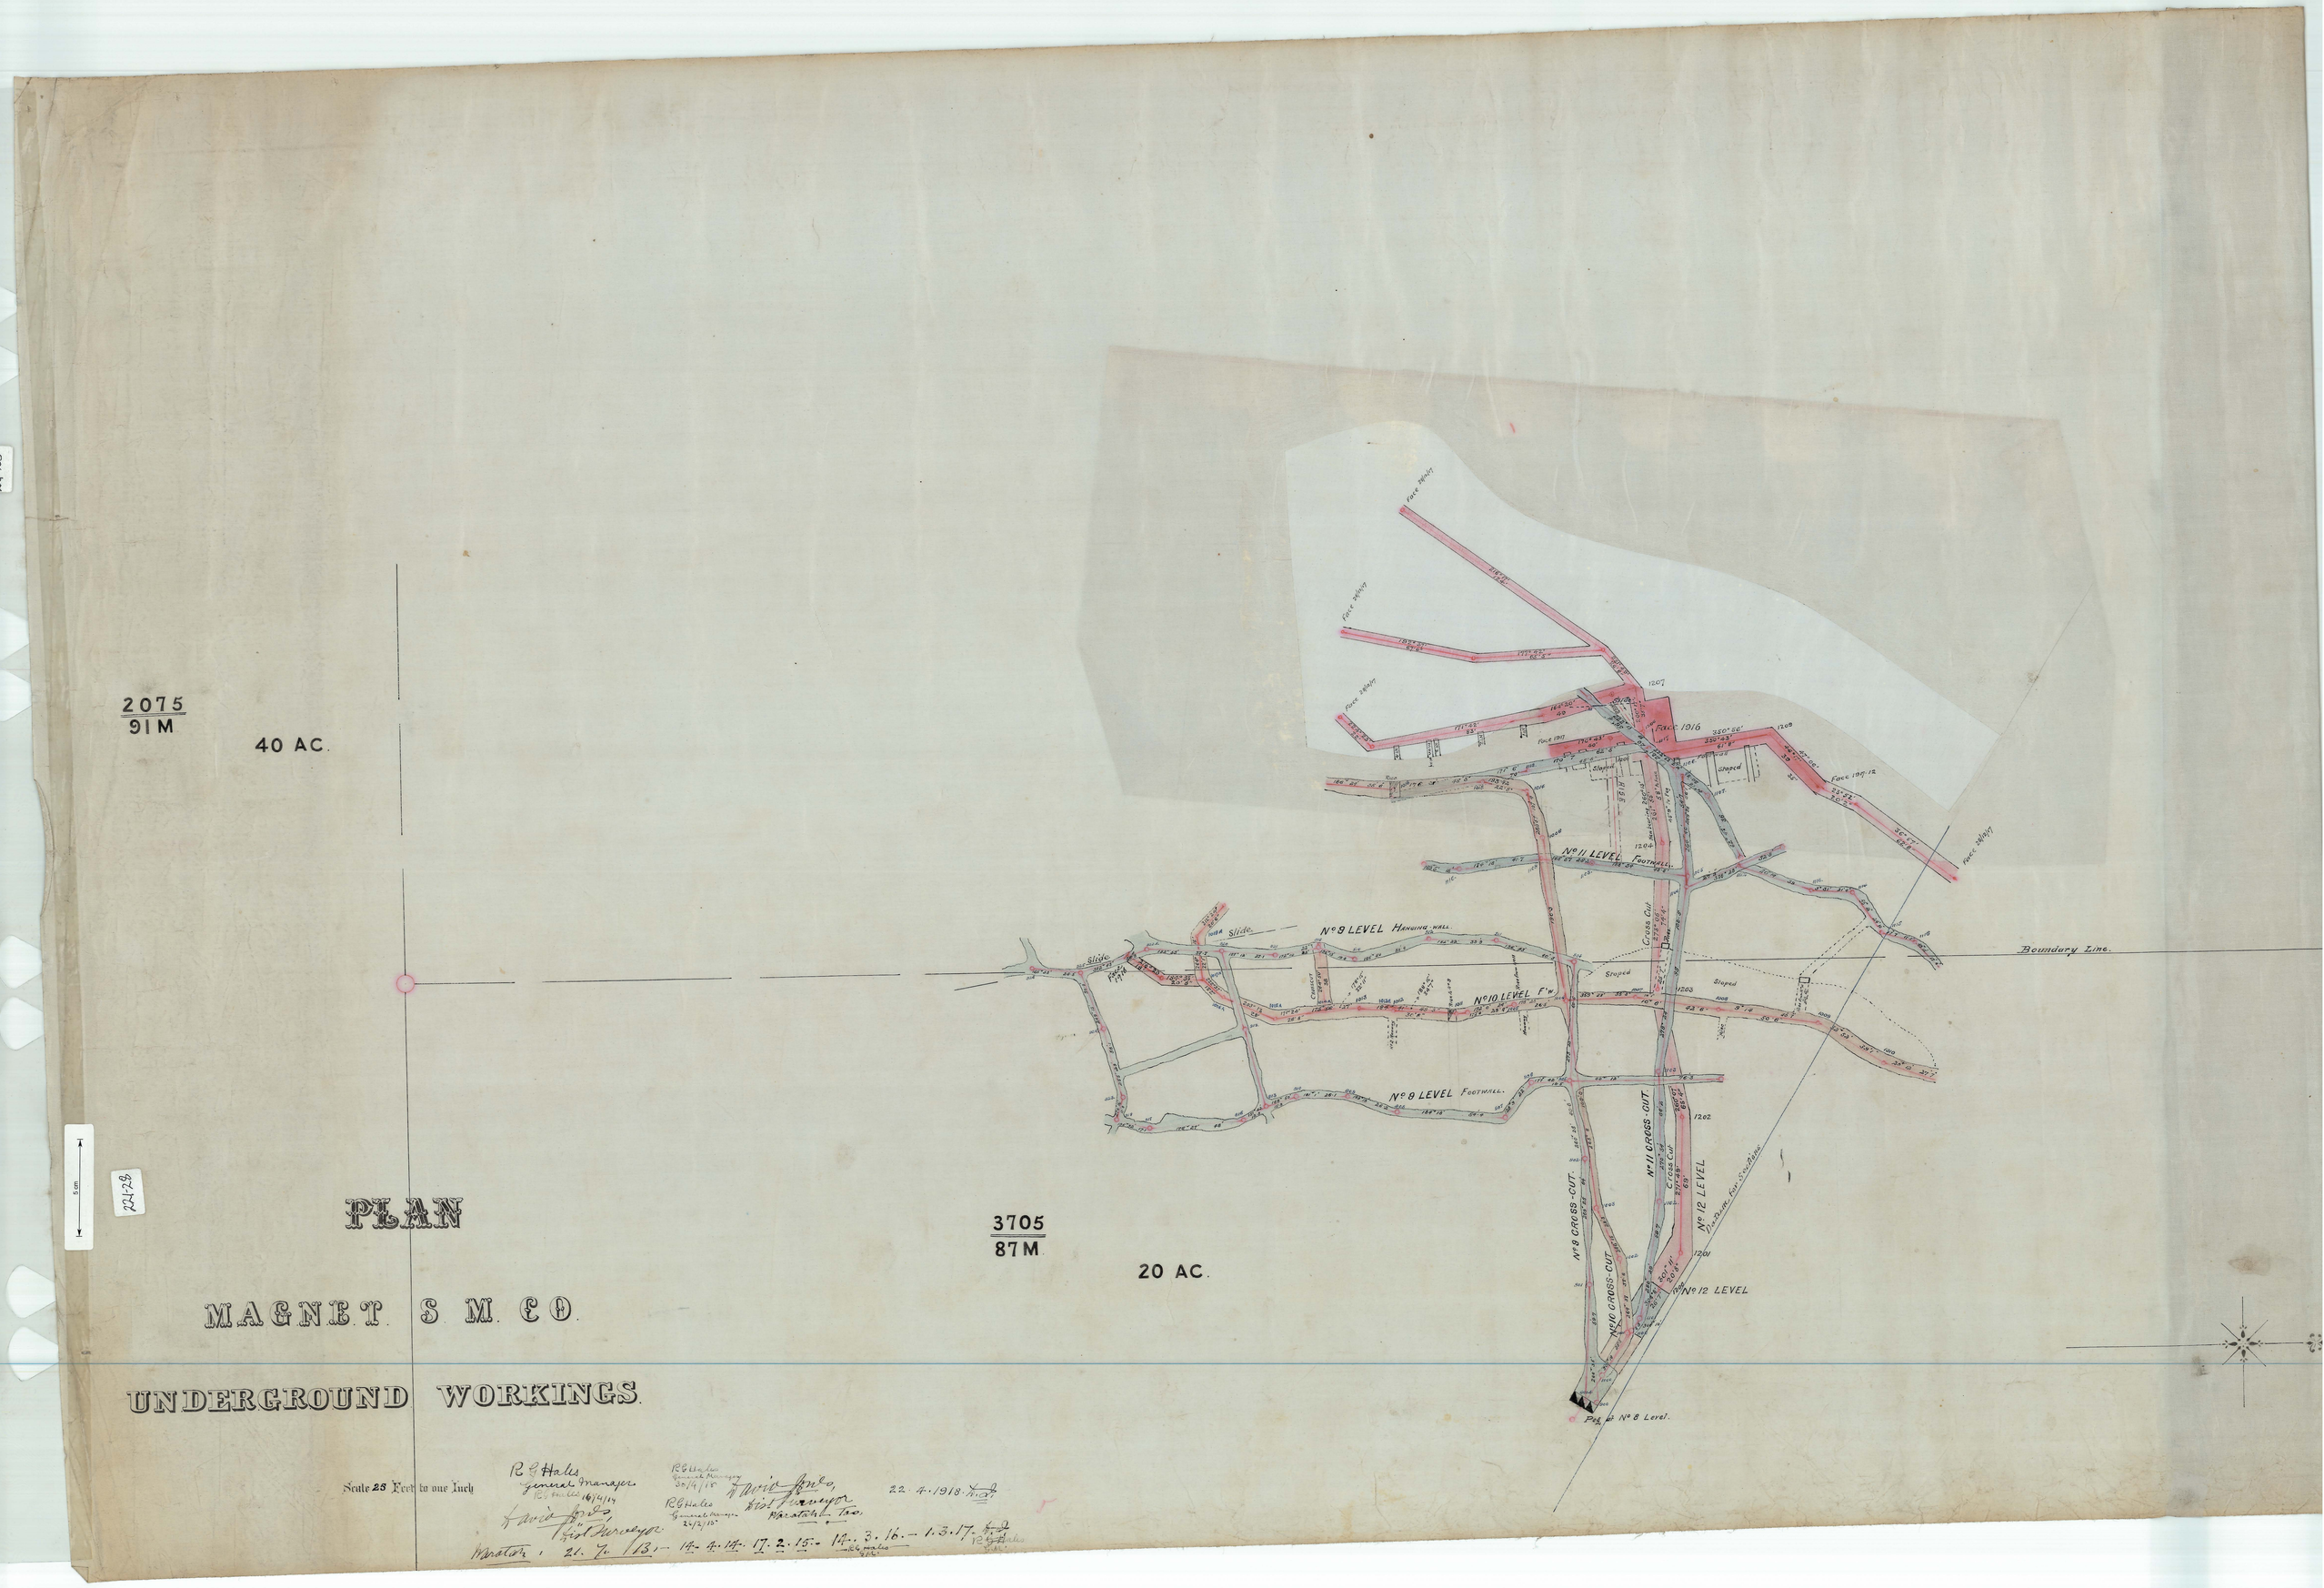
2075
91M
40 AC.
3705
87M
20 AC.
PLAN
MAGNET S. M. Co.
UNDERGROUND WORKINGS.
Scale 25 Feet to one Inch
Face 1916
Face 1917
Face 1917-12
Face 1917
Face 1917
Face 1917