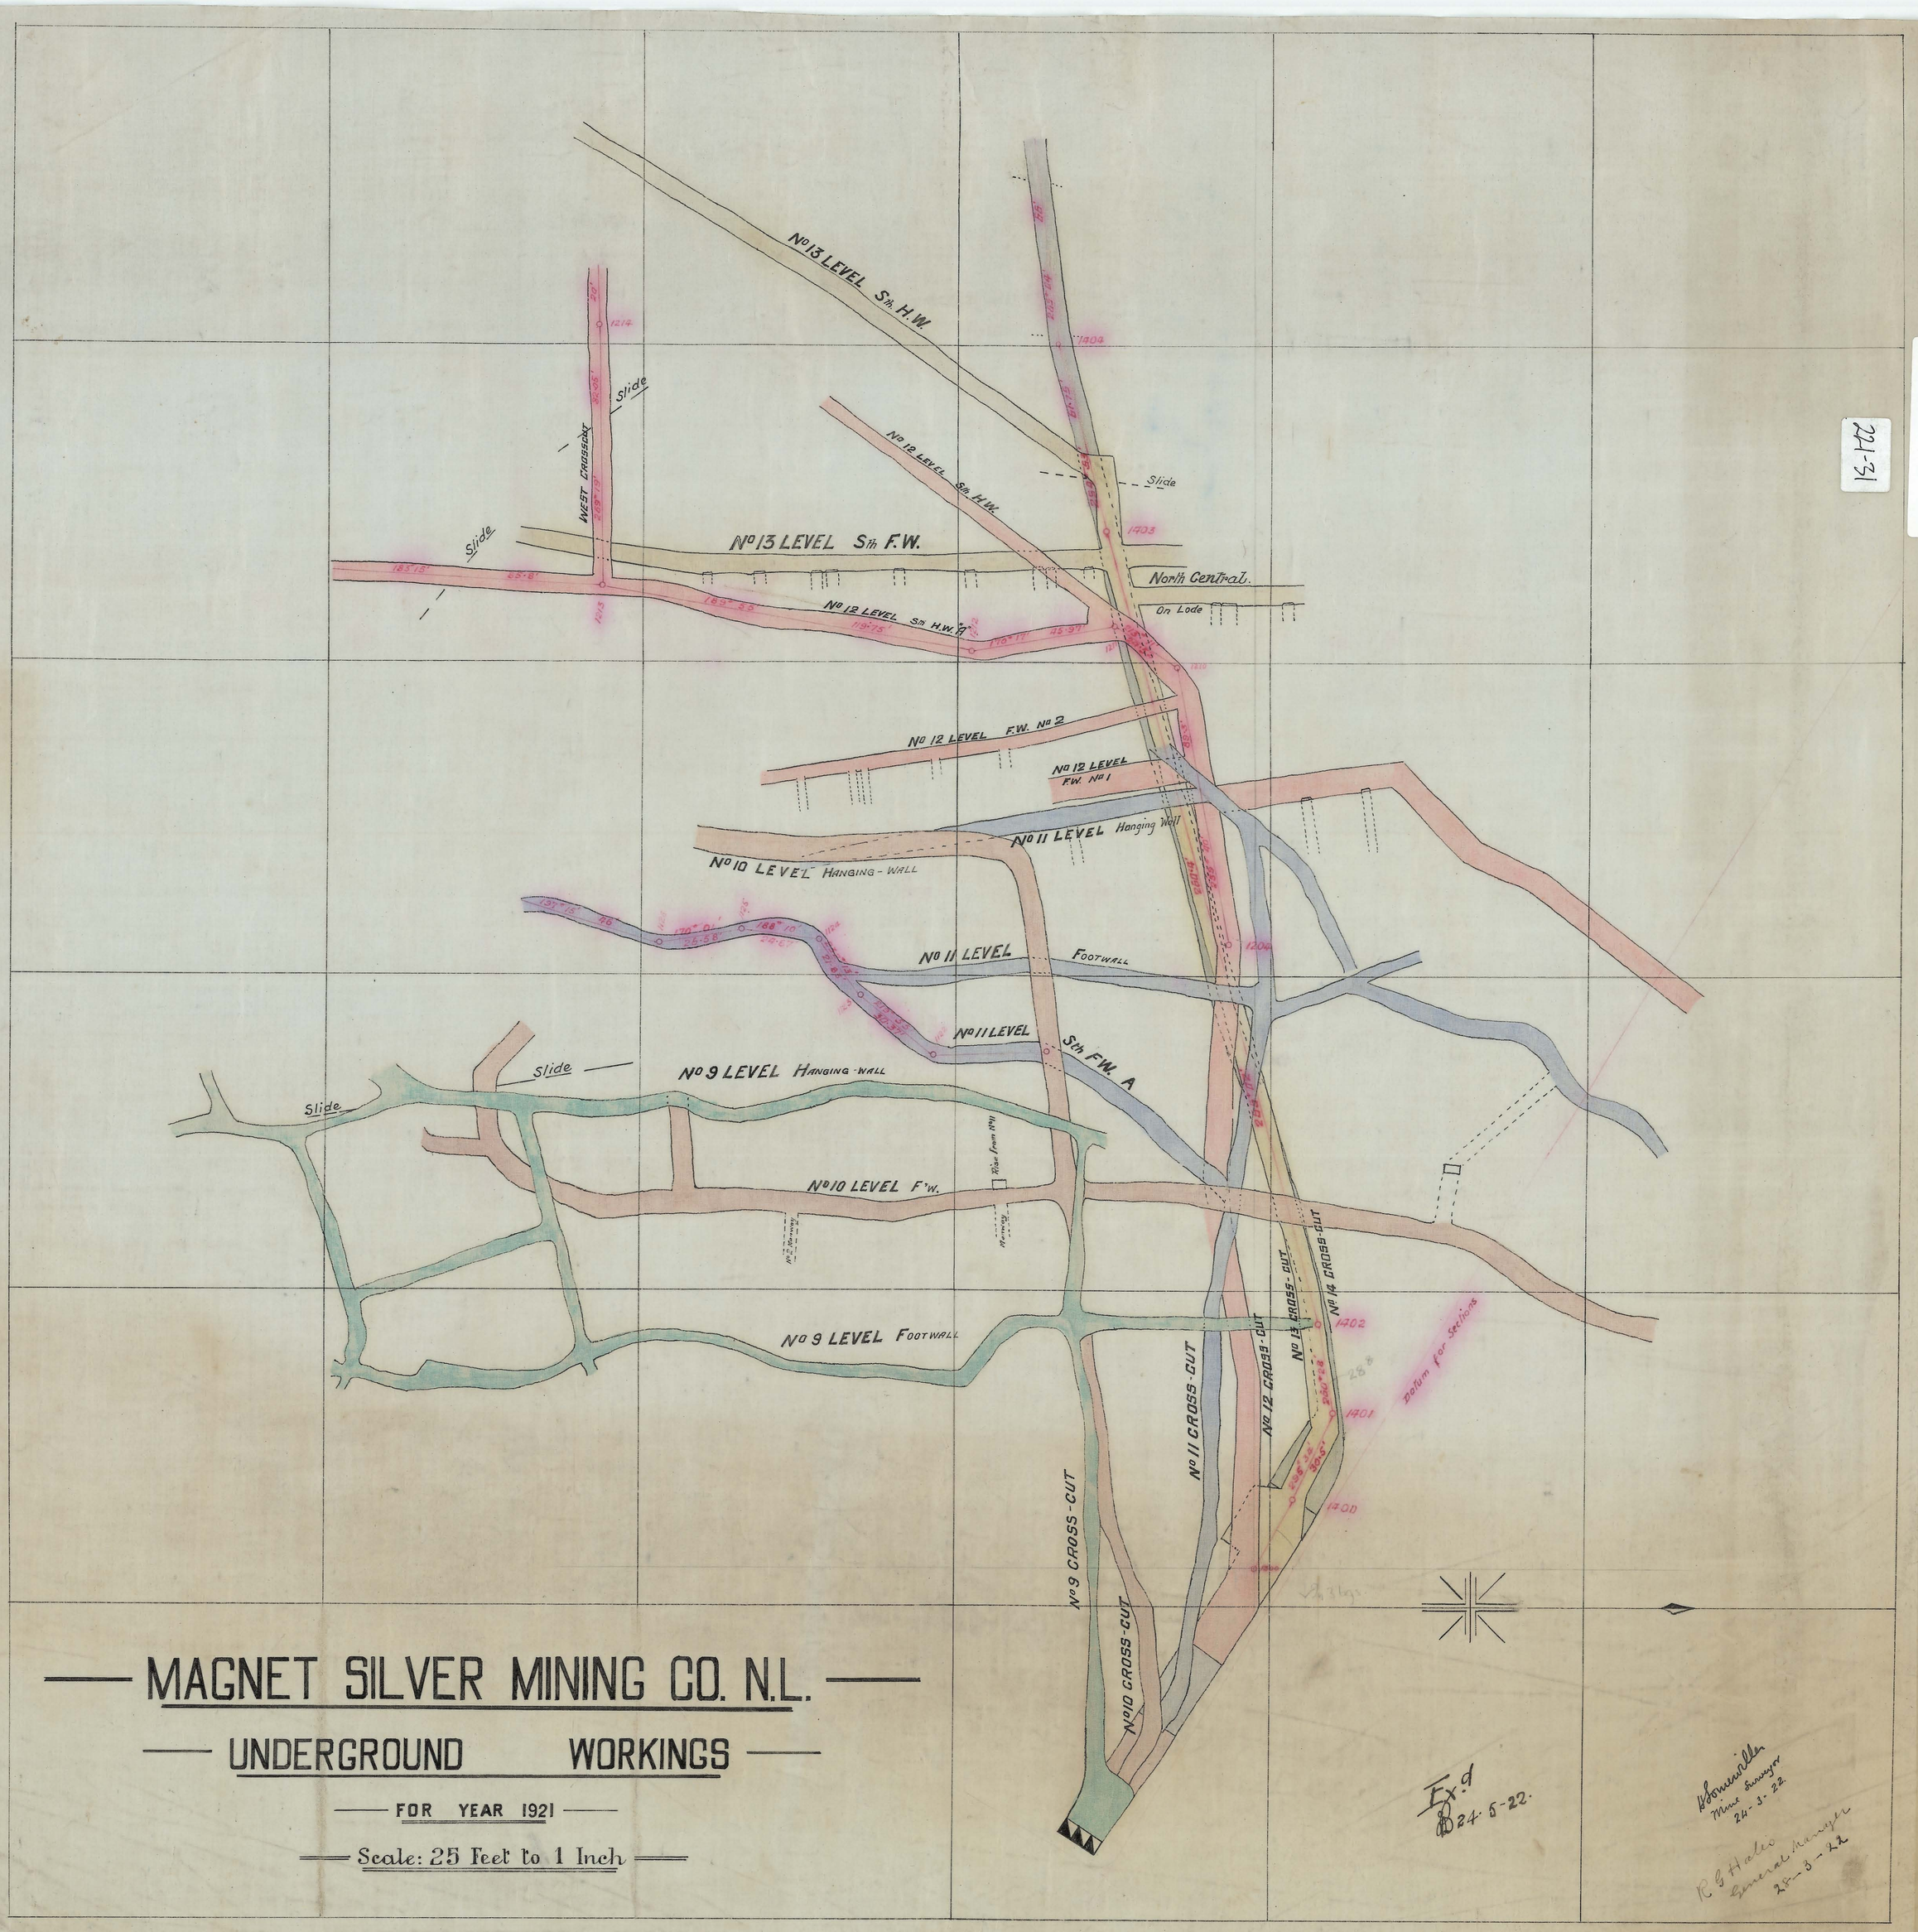

MAGNET SILVER MINING CO. N.L.

UNDERGROUND WORKINGS

FOR YEAR 1921

Scale: 25 Feet to 1 Inch

Ex'd 24-5-22.

H Somerville
Mine Surveyor
24-3-22.

R G Halio
General Manager
25-3-22

221-31

221-31